


T.14S., R.31E., W.M.

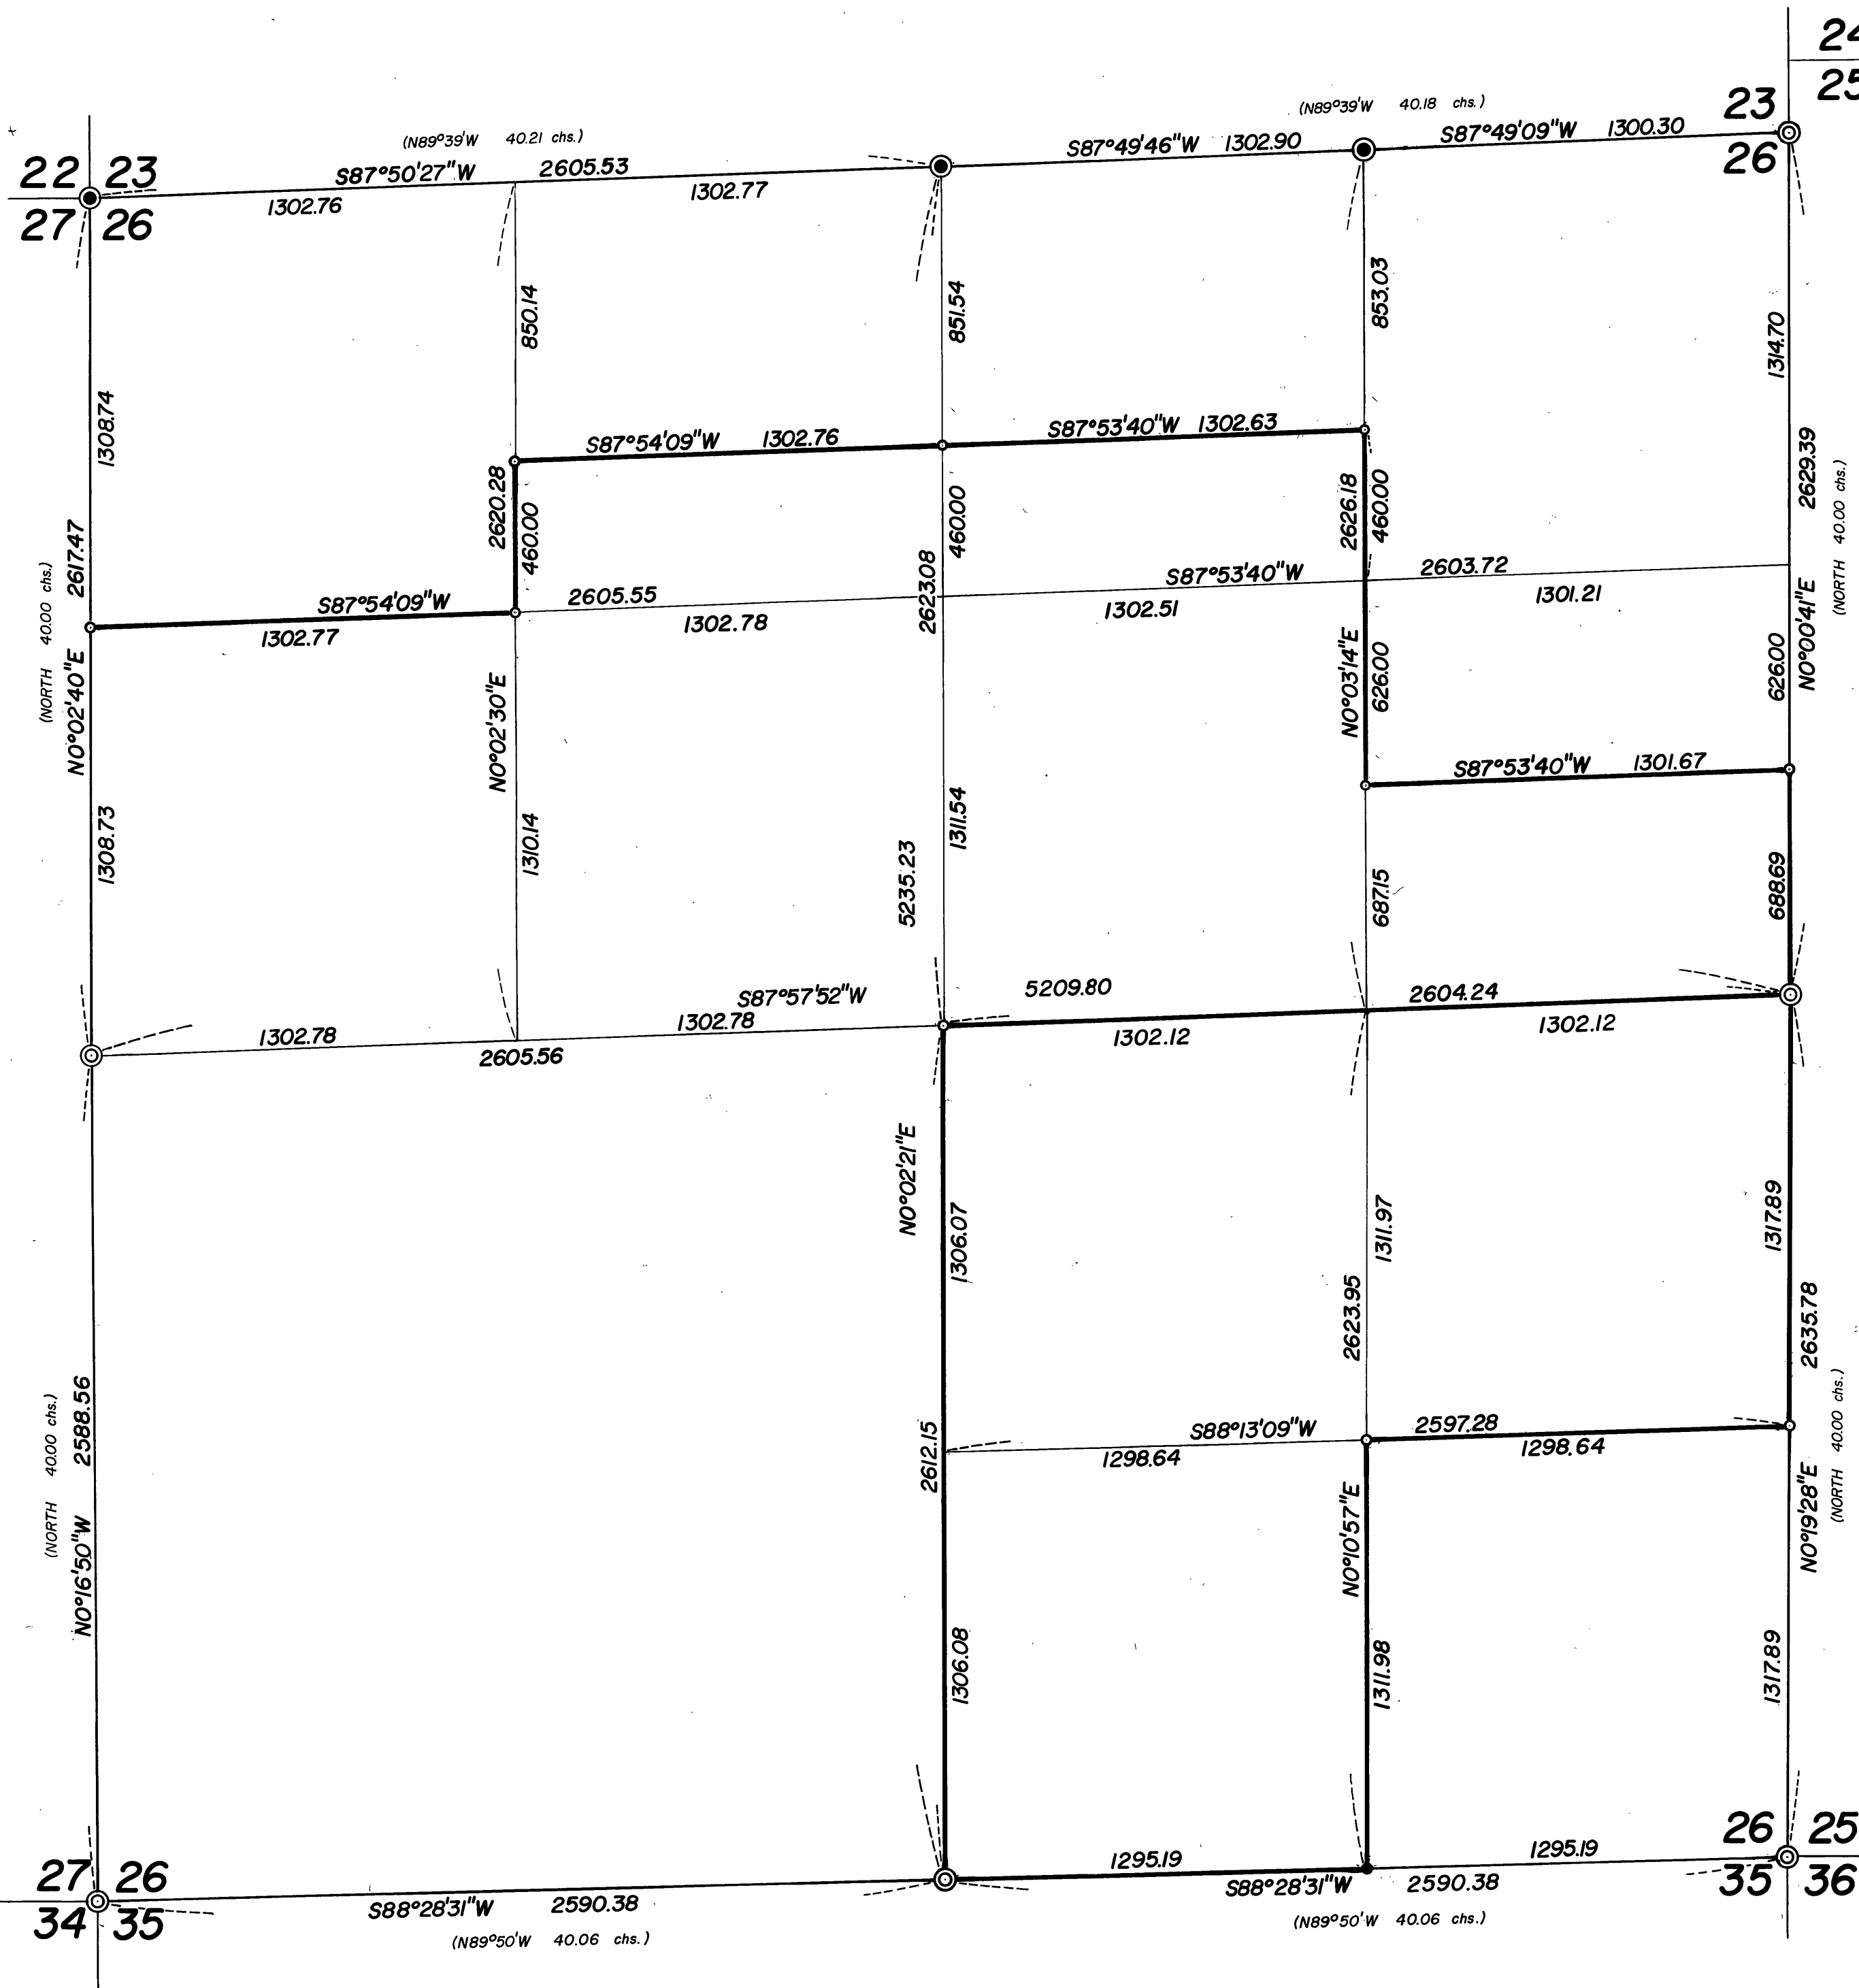

RECEIVED AND
FILED
JUL 12 1978
JOHN D. BAGETT
Deputy
County Clerk

BASIS OF BEARINGS SOLAR OBSERVATION

LEGEND

- FD. BLM BRASS CAP
- ⊙ FD. GRANT COUNTY SURVEYOR BRASS CAP
- FD. 5/8" X 30" IRON PIN
- SET 5/8" X 30" IRON PIN
- () RECORD BEARING & DISTANCE

NOTE: SEE REMONUMENTATION SHEETS FOR
RECORD OF BEARING TREES TAKEN
AT 1/16 CORNERS.

REGISTERED
PROFESSIONAL
LAND SURVEYOR

Robert D. Bagett
OREGON
JULY 12, 1963
ROBERT D. BAGETT
598

BAGETT, GRIFFITH & ASSOCIATES
John Day, Oregon

Map of Survey
SUBDIVISION OF SECTION 26
T.14S., R.31E., W.M.

GRANT COUNTY, OREGON

SURVEYED FOR	PRAIRIE CITY TIMBER COMPANY	
SURVEYED BY	R.D.B., S.F.U., & C.G.	JULY 1978
Scale: 1" = 400'	Drawn by: C.G.	JULY 1978