


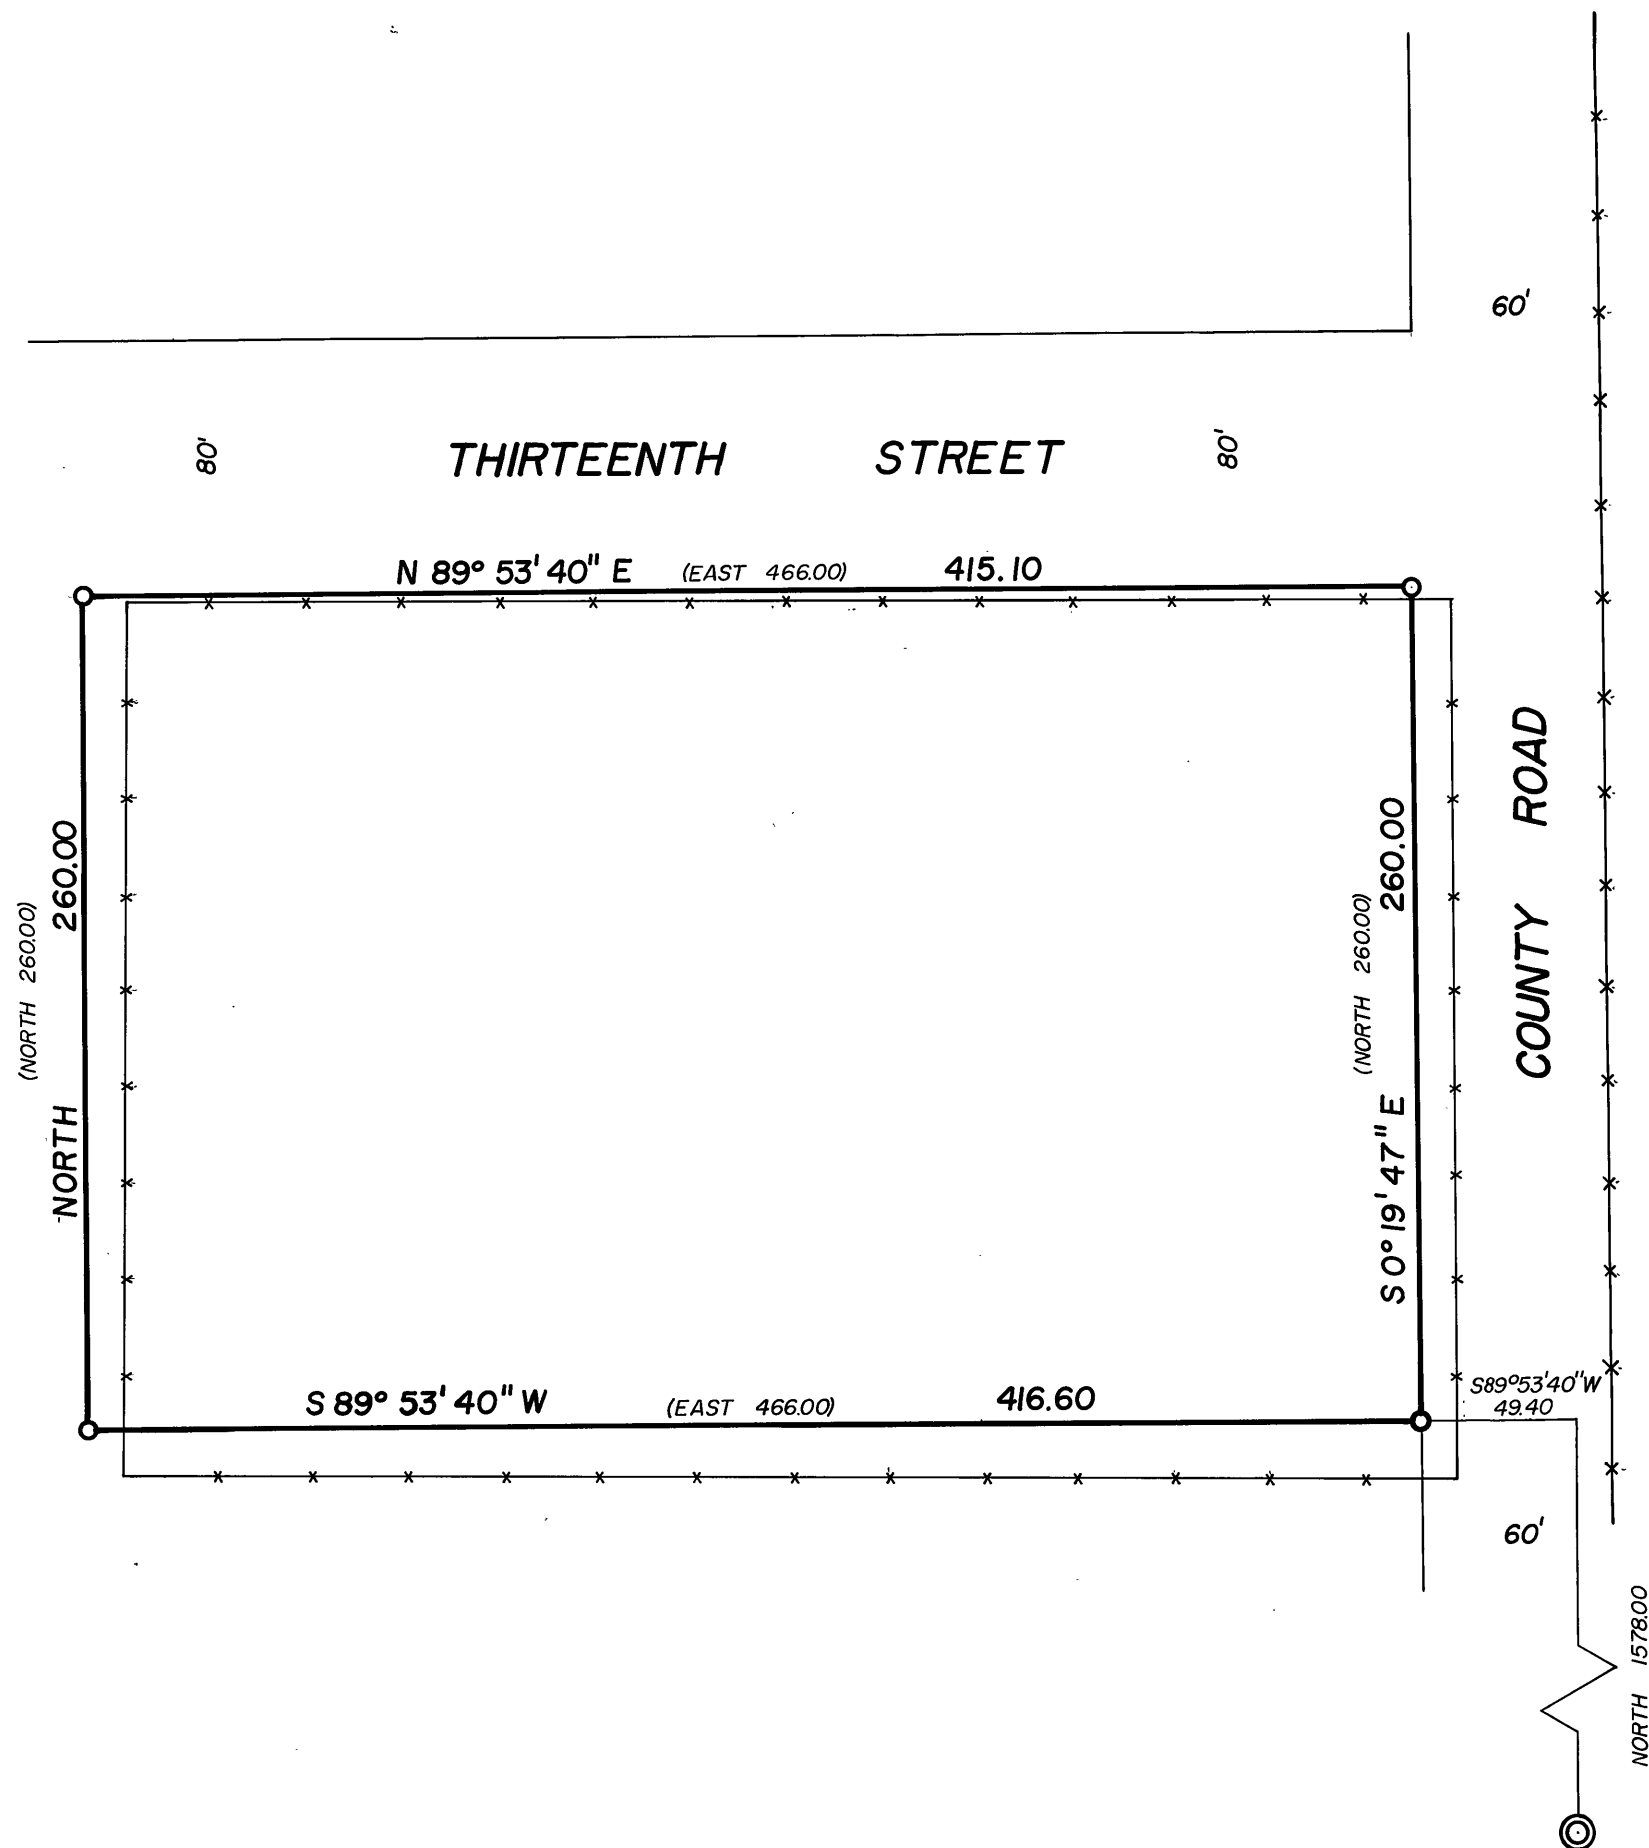

BASIS OF BEARINGS

SOLAR OBSERVATION

LEGEND

- o Set 5/8" X 30" iron pin
- x—x Fence
- () Record bearing & distance

REGISTERED
PROFESSIONAL
LAND SURVEYOR

Robert D. Bagett
OREGON
JULY 12, 1963
ROBERT D. BAGETT
598

RECEIVED AND
FILED

JUL 25 1978
John Liveira
JOHN LIVEIRA, County Clerk
By _____ Deputy

BAGETT, GRIFFITH & ASSOCIATES

John Day, Oregon

Map of Survey

A TRACT OF LAND IN THE
NE 1/4 SW 1/4 OF SECTION 11
T.13S., R.33E., W.M.

GRANT COUNTY, OREGON

SURVEYED FOR	CECIL KIGHT	
SURVEYED BY	R.D.B. & H.H.	6/29/78
Scale: 1" = 60'	Drawn by: K.M.S. & C.G.	7/20/78

MAP OF SURVEY NO. 520