

TOWNSHIP 18 SOUTH, RANGE 26 EAST, W.M.

DEPENDENT RESURVEY

SNOW MOUNTAIN CADASTRAL SURVEY
REGION 6, F.S. CONTRACT NO. 006655 N


Dated September 27, 1977

BOUNDARY SPRINGS

Field Book No. 2






Bearings based on Solar Observations. Mean Declination $19^{\circ}30'$ East

SCALE

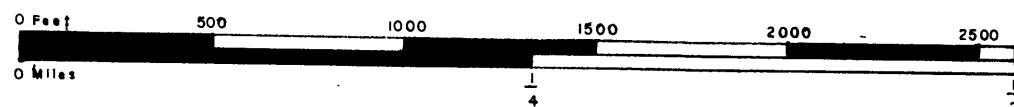

LEGEND

- ◆ Corner Found
- ⊙ Corner Monumented
- #### N. F. Boundary Posted

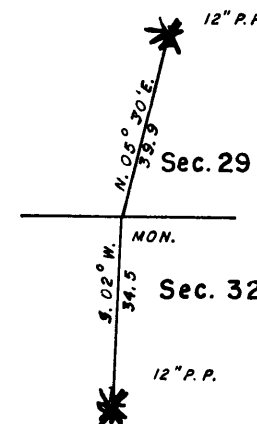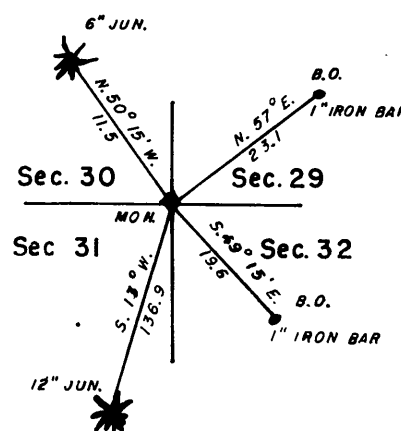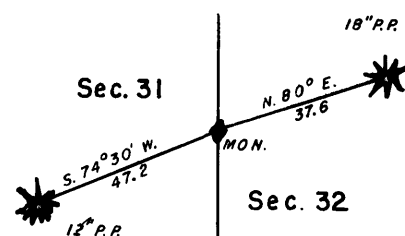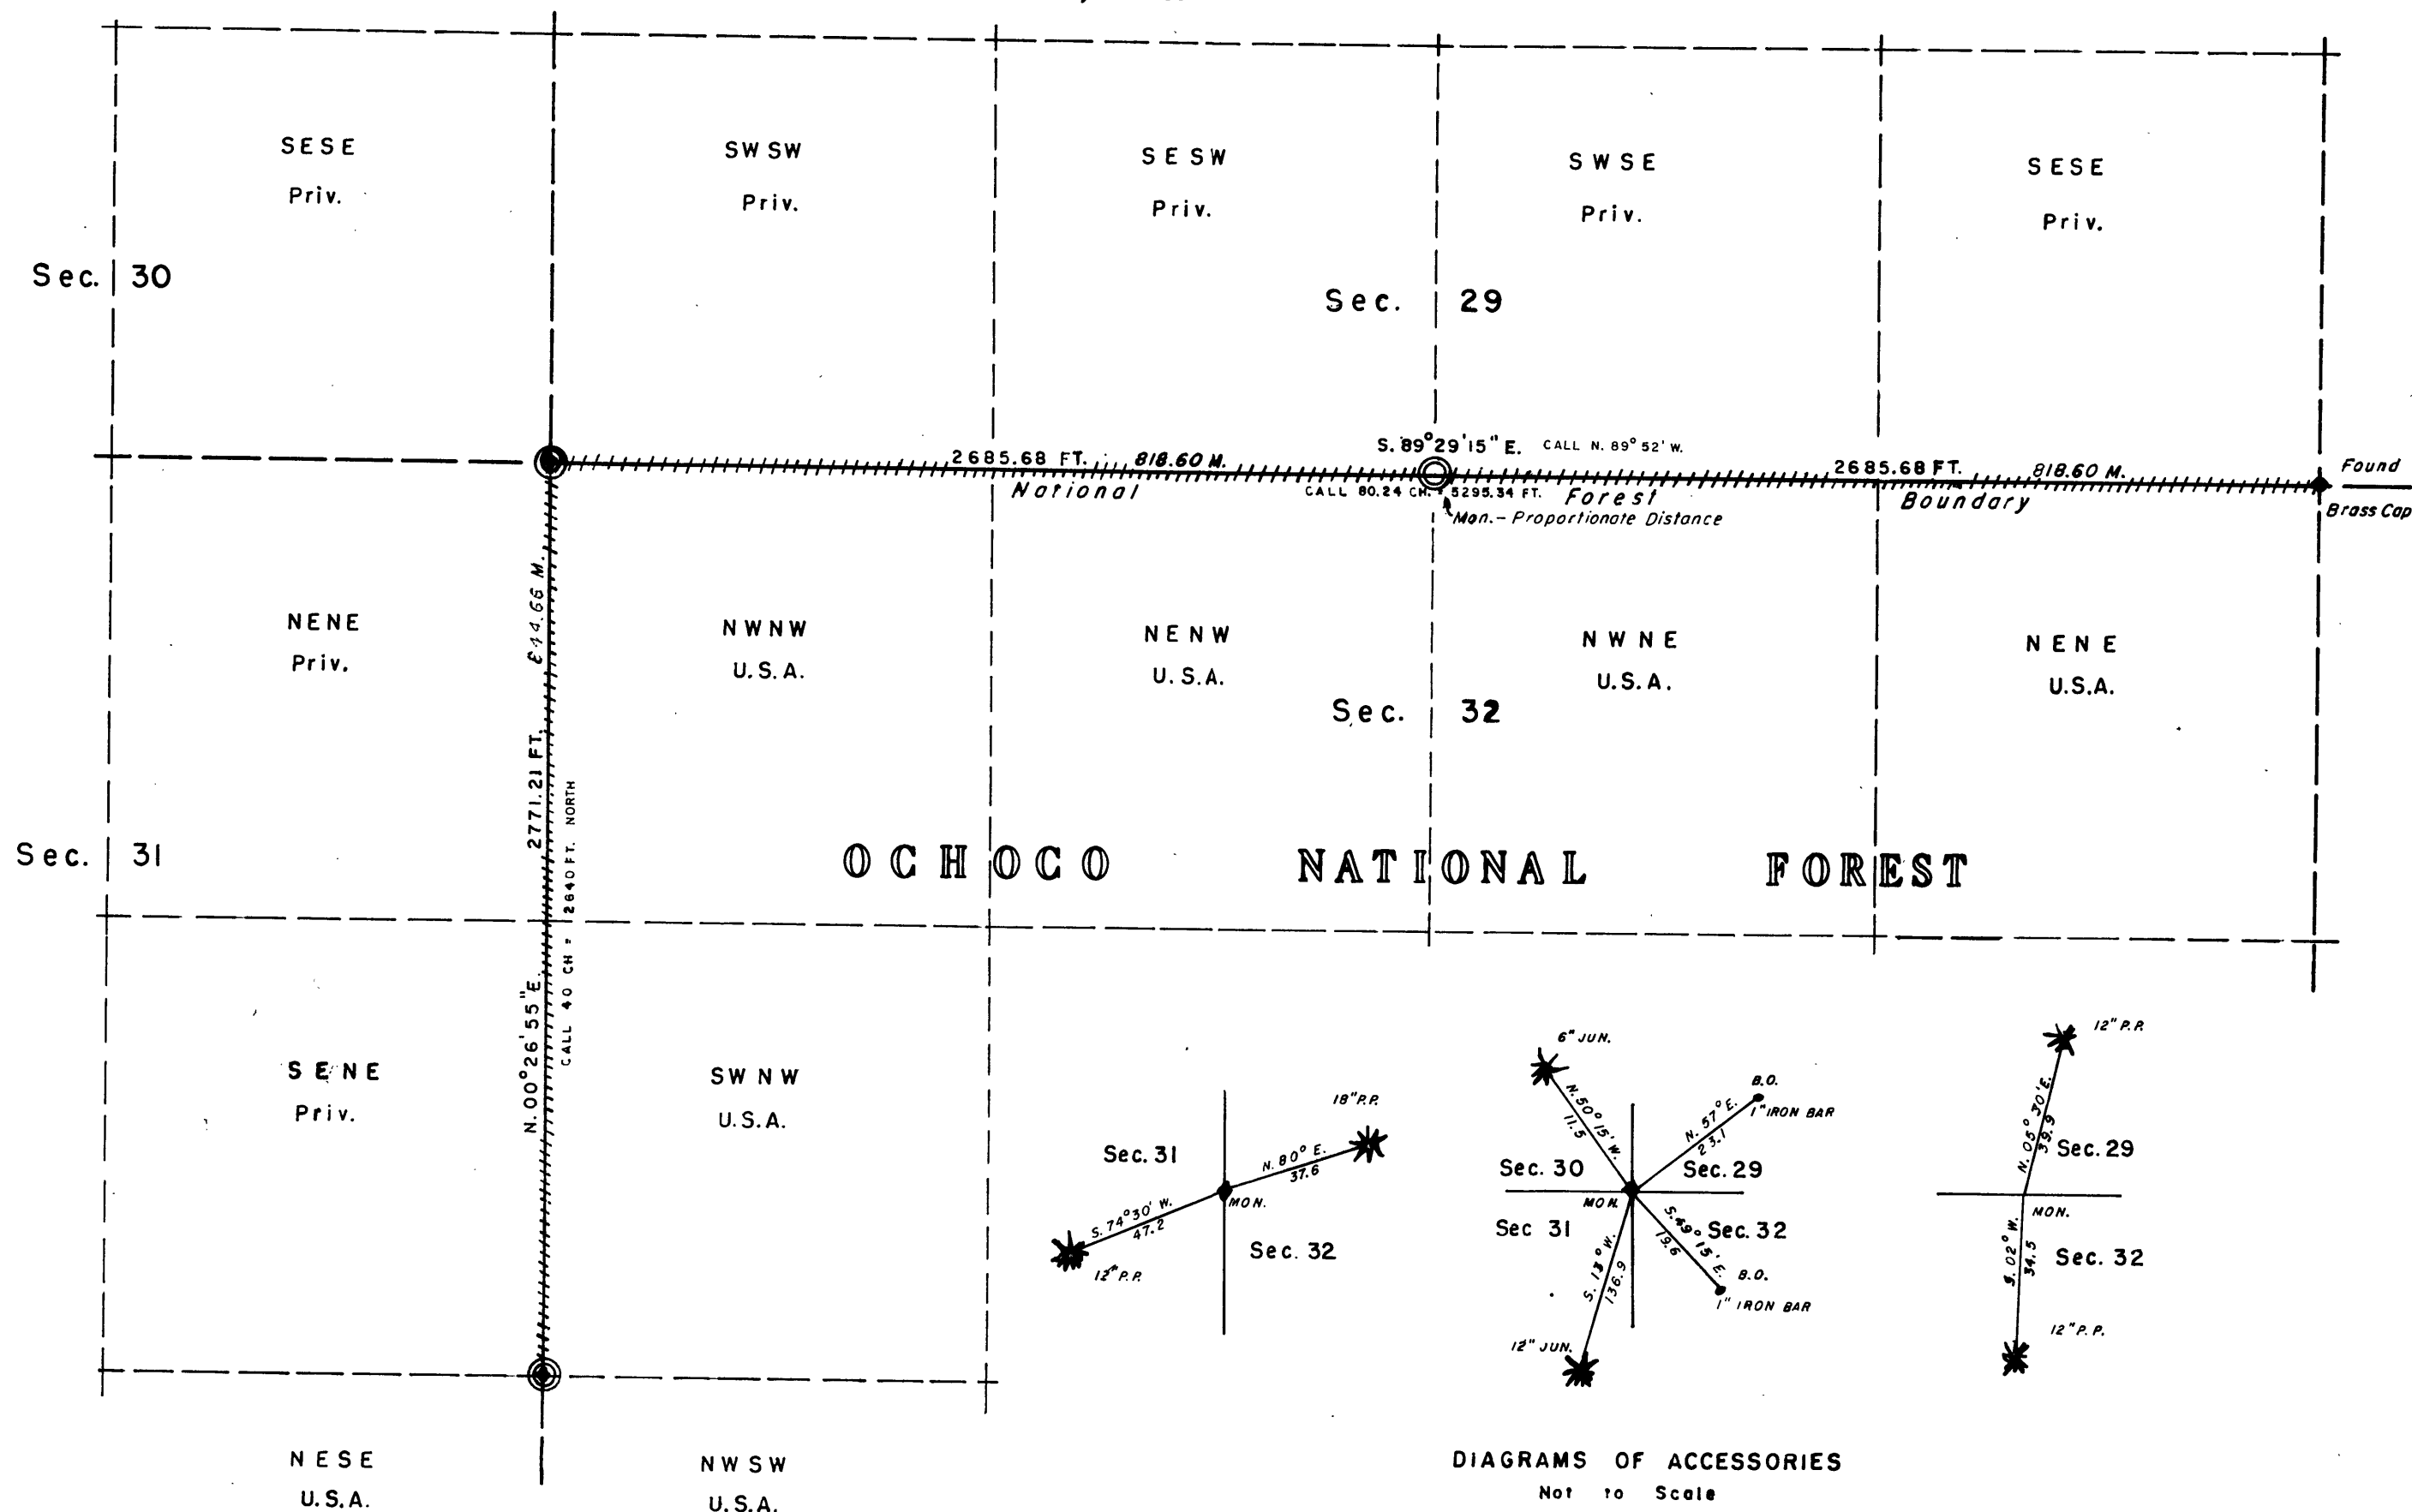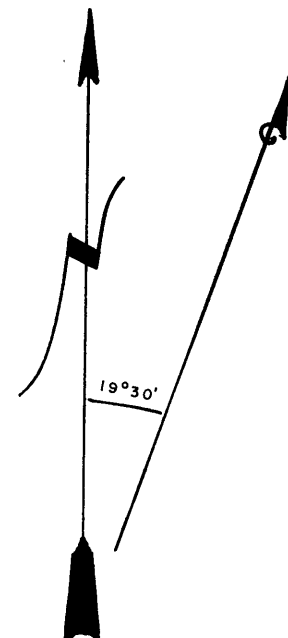

DIAGRAMS OF ACCESSORIES
Not to Scale

All lands shown as U.S.A. are administered by the U.S. Forest Service

I, M.A. Palmer, Land Surveyor registered in accordance with the laws of the State of Oregon, do hereby certify that this plot and the notes hereon, or attached, are a correct representation of a survey I performed during 1977 and 1978 for the U.S. Forest Service in accordance with the statutes of the State of Oregon and the articles of my contract

Mapalena 6/17/78

RECEIVED AND
FILED

JUL 25 1978
John Liveira
JOHN LIVEIRA, County Clerk
By _____ Deputy