


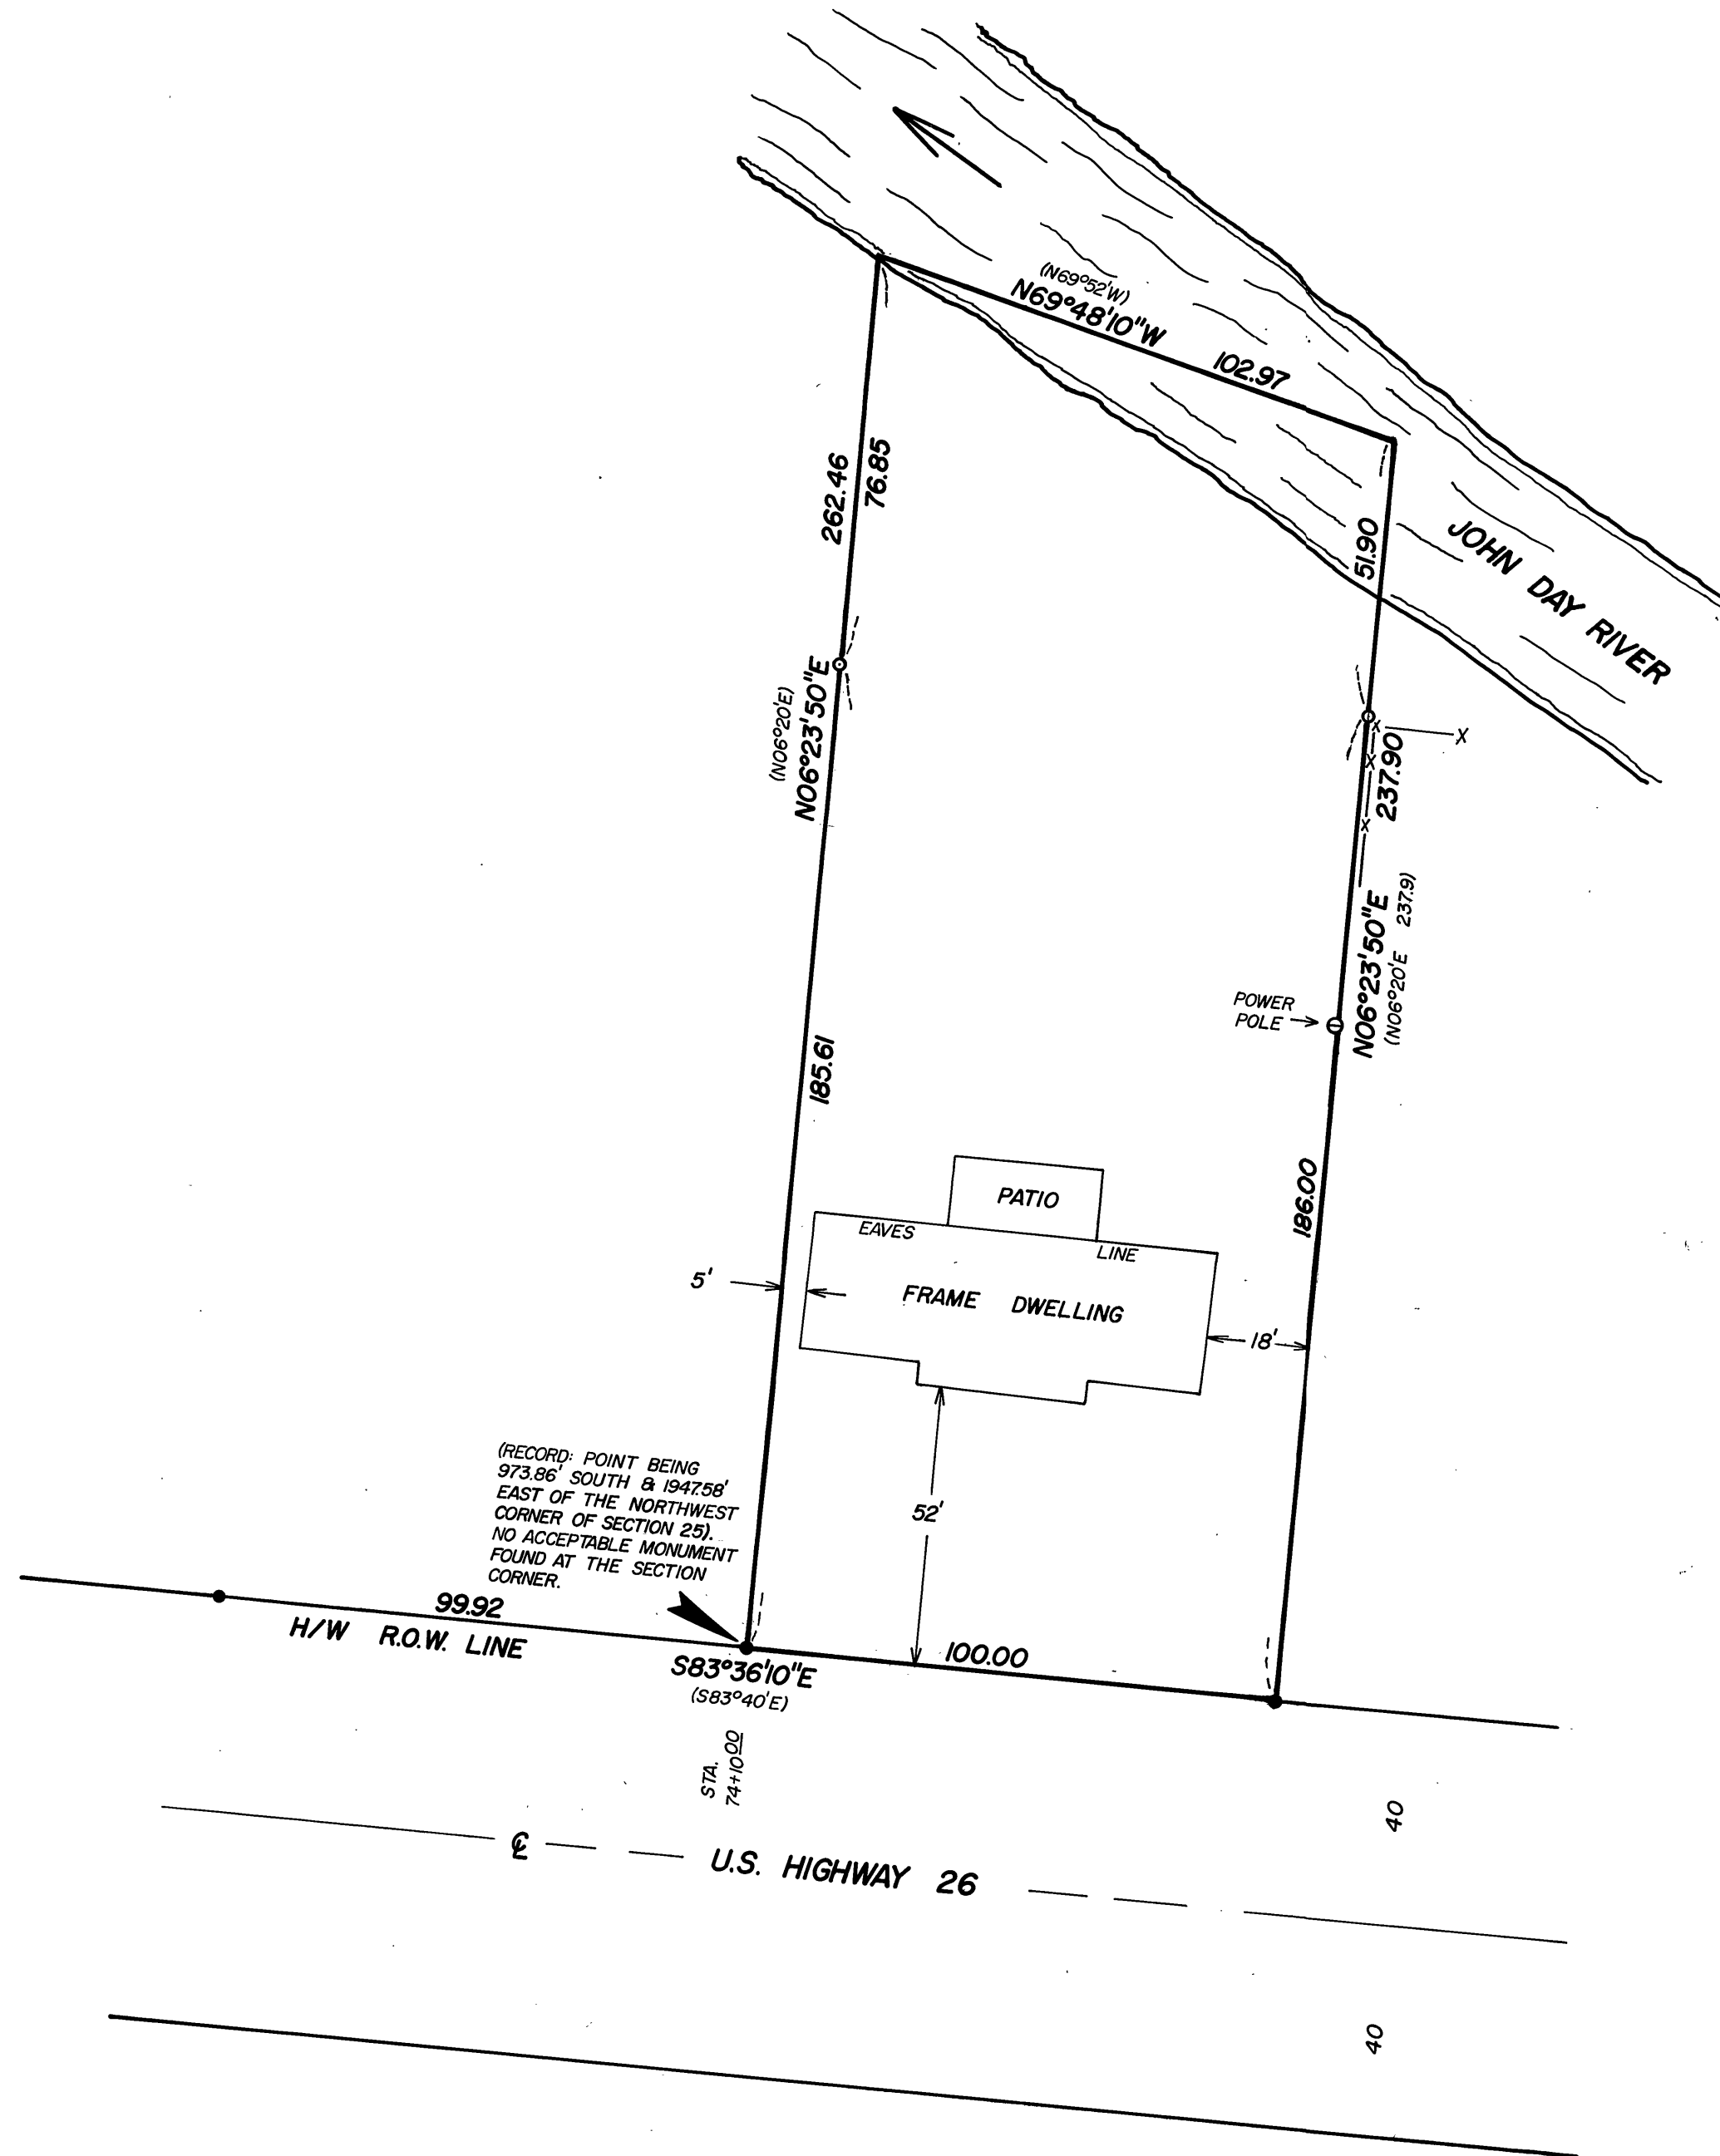

BASIS OF BEARINGS

SOLAR OBSERVATION

LEGEND

- FD. 1/2" IRON PIN
- SET 5/8" X 30" IRON PIN
- x—x FENCE
- () RECORD BEARING & DISTANCE

REGISTERED
PROFESSIONAL
LAND SURVEYOR

Robert D. Baggett
OREGON
JULY 12, 1963
ROBERT D. BAGETT
598

RECEIVED AND
FILED
JUL 24 1978
JOHN L. LIVERA, County Clerk
By _____ Deputy

BAGETT, GRIFFITH & ASSOCIATES
John Day, Oregon
Map of Survey

A TRACT OF LAND IN THE
NE1/4NW1/4 OF SECTION 25
T.13S, R.31E., W.M., CITY OF JOHN DAY
GRANT COUNTY, OREGON

SURVEYED FOR	HART CULP	
SURVEYED BY	R.D.B., S.F.J., & C.G.	8/8/78
Scale: 1" = 30'	Drawn by: C.G.	8/10/78

MAP OF SURVEY NO. 526