


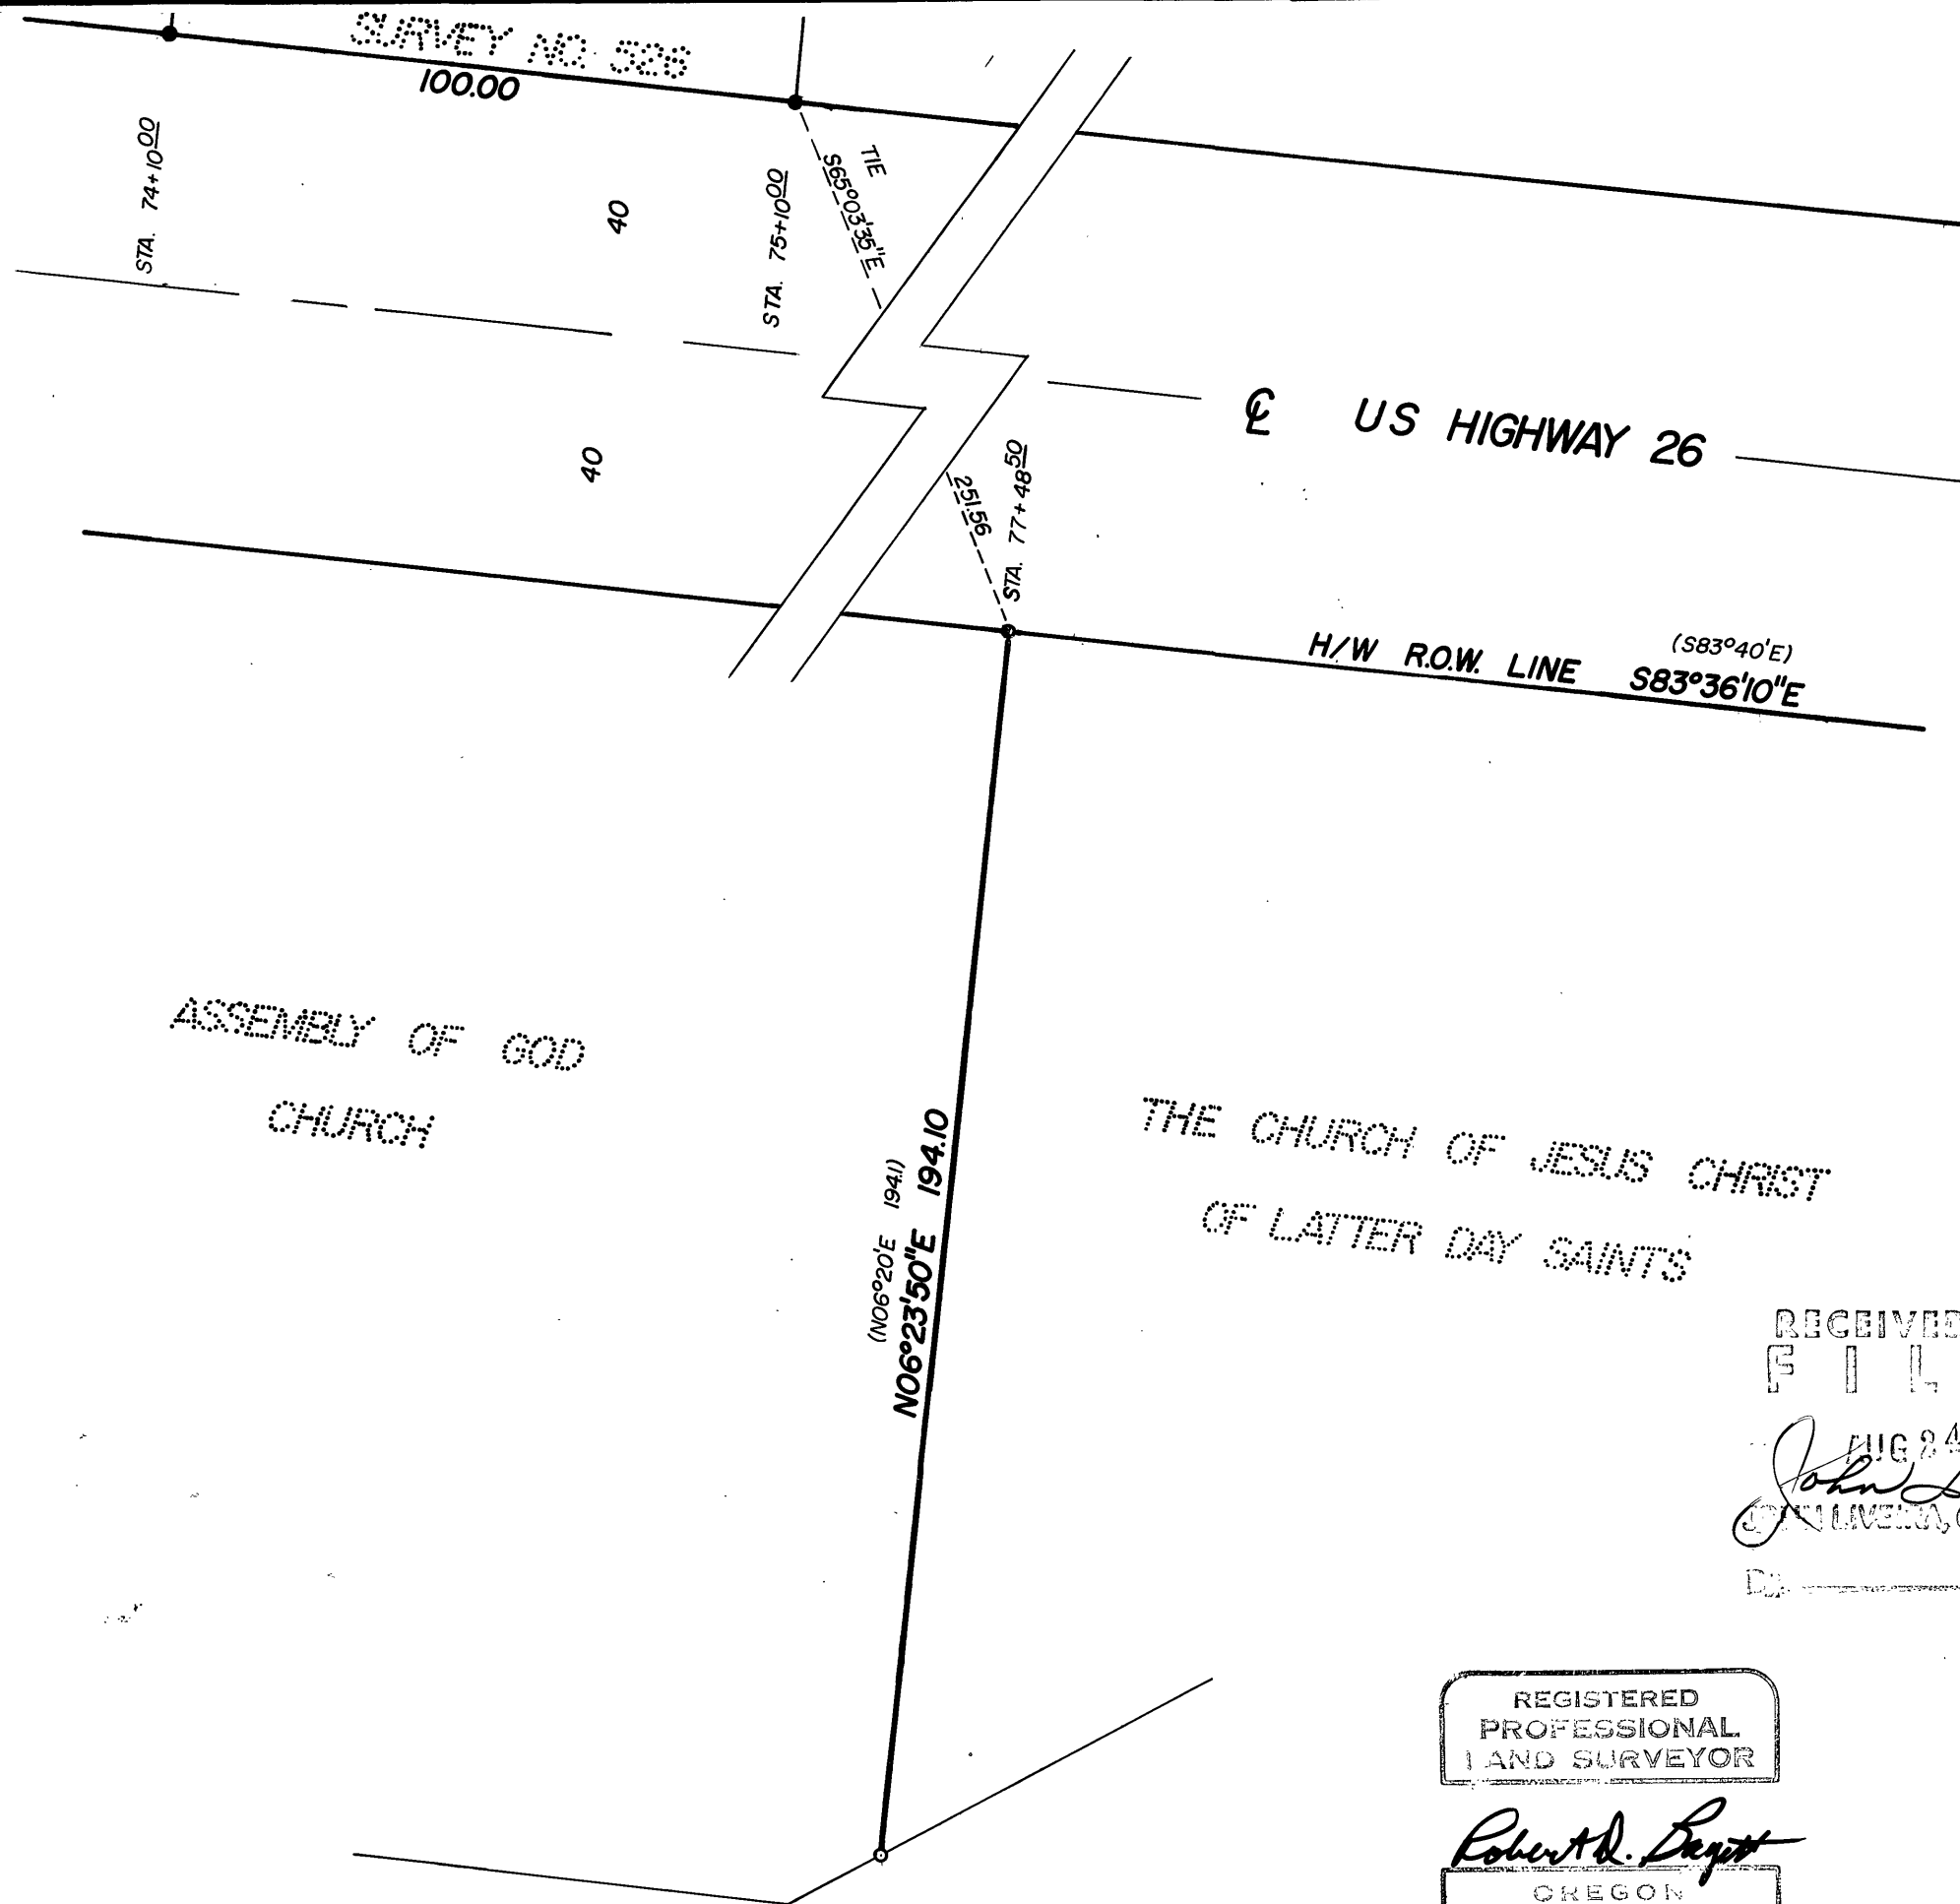

BASIS OF BEARINGS
SOLAR OBSERVATION

- LEGEND**
- FD. 1/2" IRON PIN
 - SET 5/8" X 30" IRON PIN
 - () RECORD BEARING & DISTANCE

REFERENCES
DEEDS:
BOOK 84, P. 566.

RECEIVED AND
FILED

AUG 24 1978
John Livera
JOHN LIVERA, County Clerk
DEPT. OF COUNTY CLERK

REGISTERED
PROFESSIONAL
LAND SURVEYOR

Robert D. Bagett
OREGON
JULY 12, 1963
ROBERT D. BAGETT
598

BAGETT, GRIFFITH & ASSOCIATES
John Day, Oregon
Map of Survey

A LINE IN THE NE1/4NW1/4
OF SECTION 25 T.13S, R.31E, W.M.,
CITY OF JOHN DAY
GRANT COUNTY, OREGON

SURVEYED FOR	CITY OF JOHN DAY	
SURVEYED BY	R.D.B. & S.F.J.	8/8/78
Scale: 1" = 30'	Drawn by: C.G.	8/14/78

MAP OF SURVEY NO. 527