


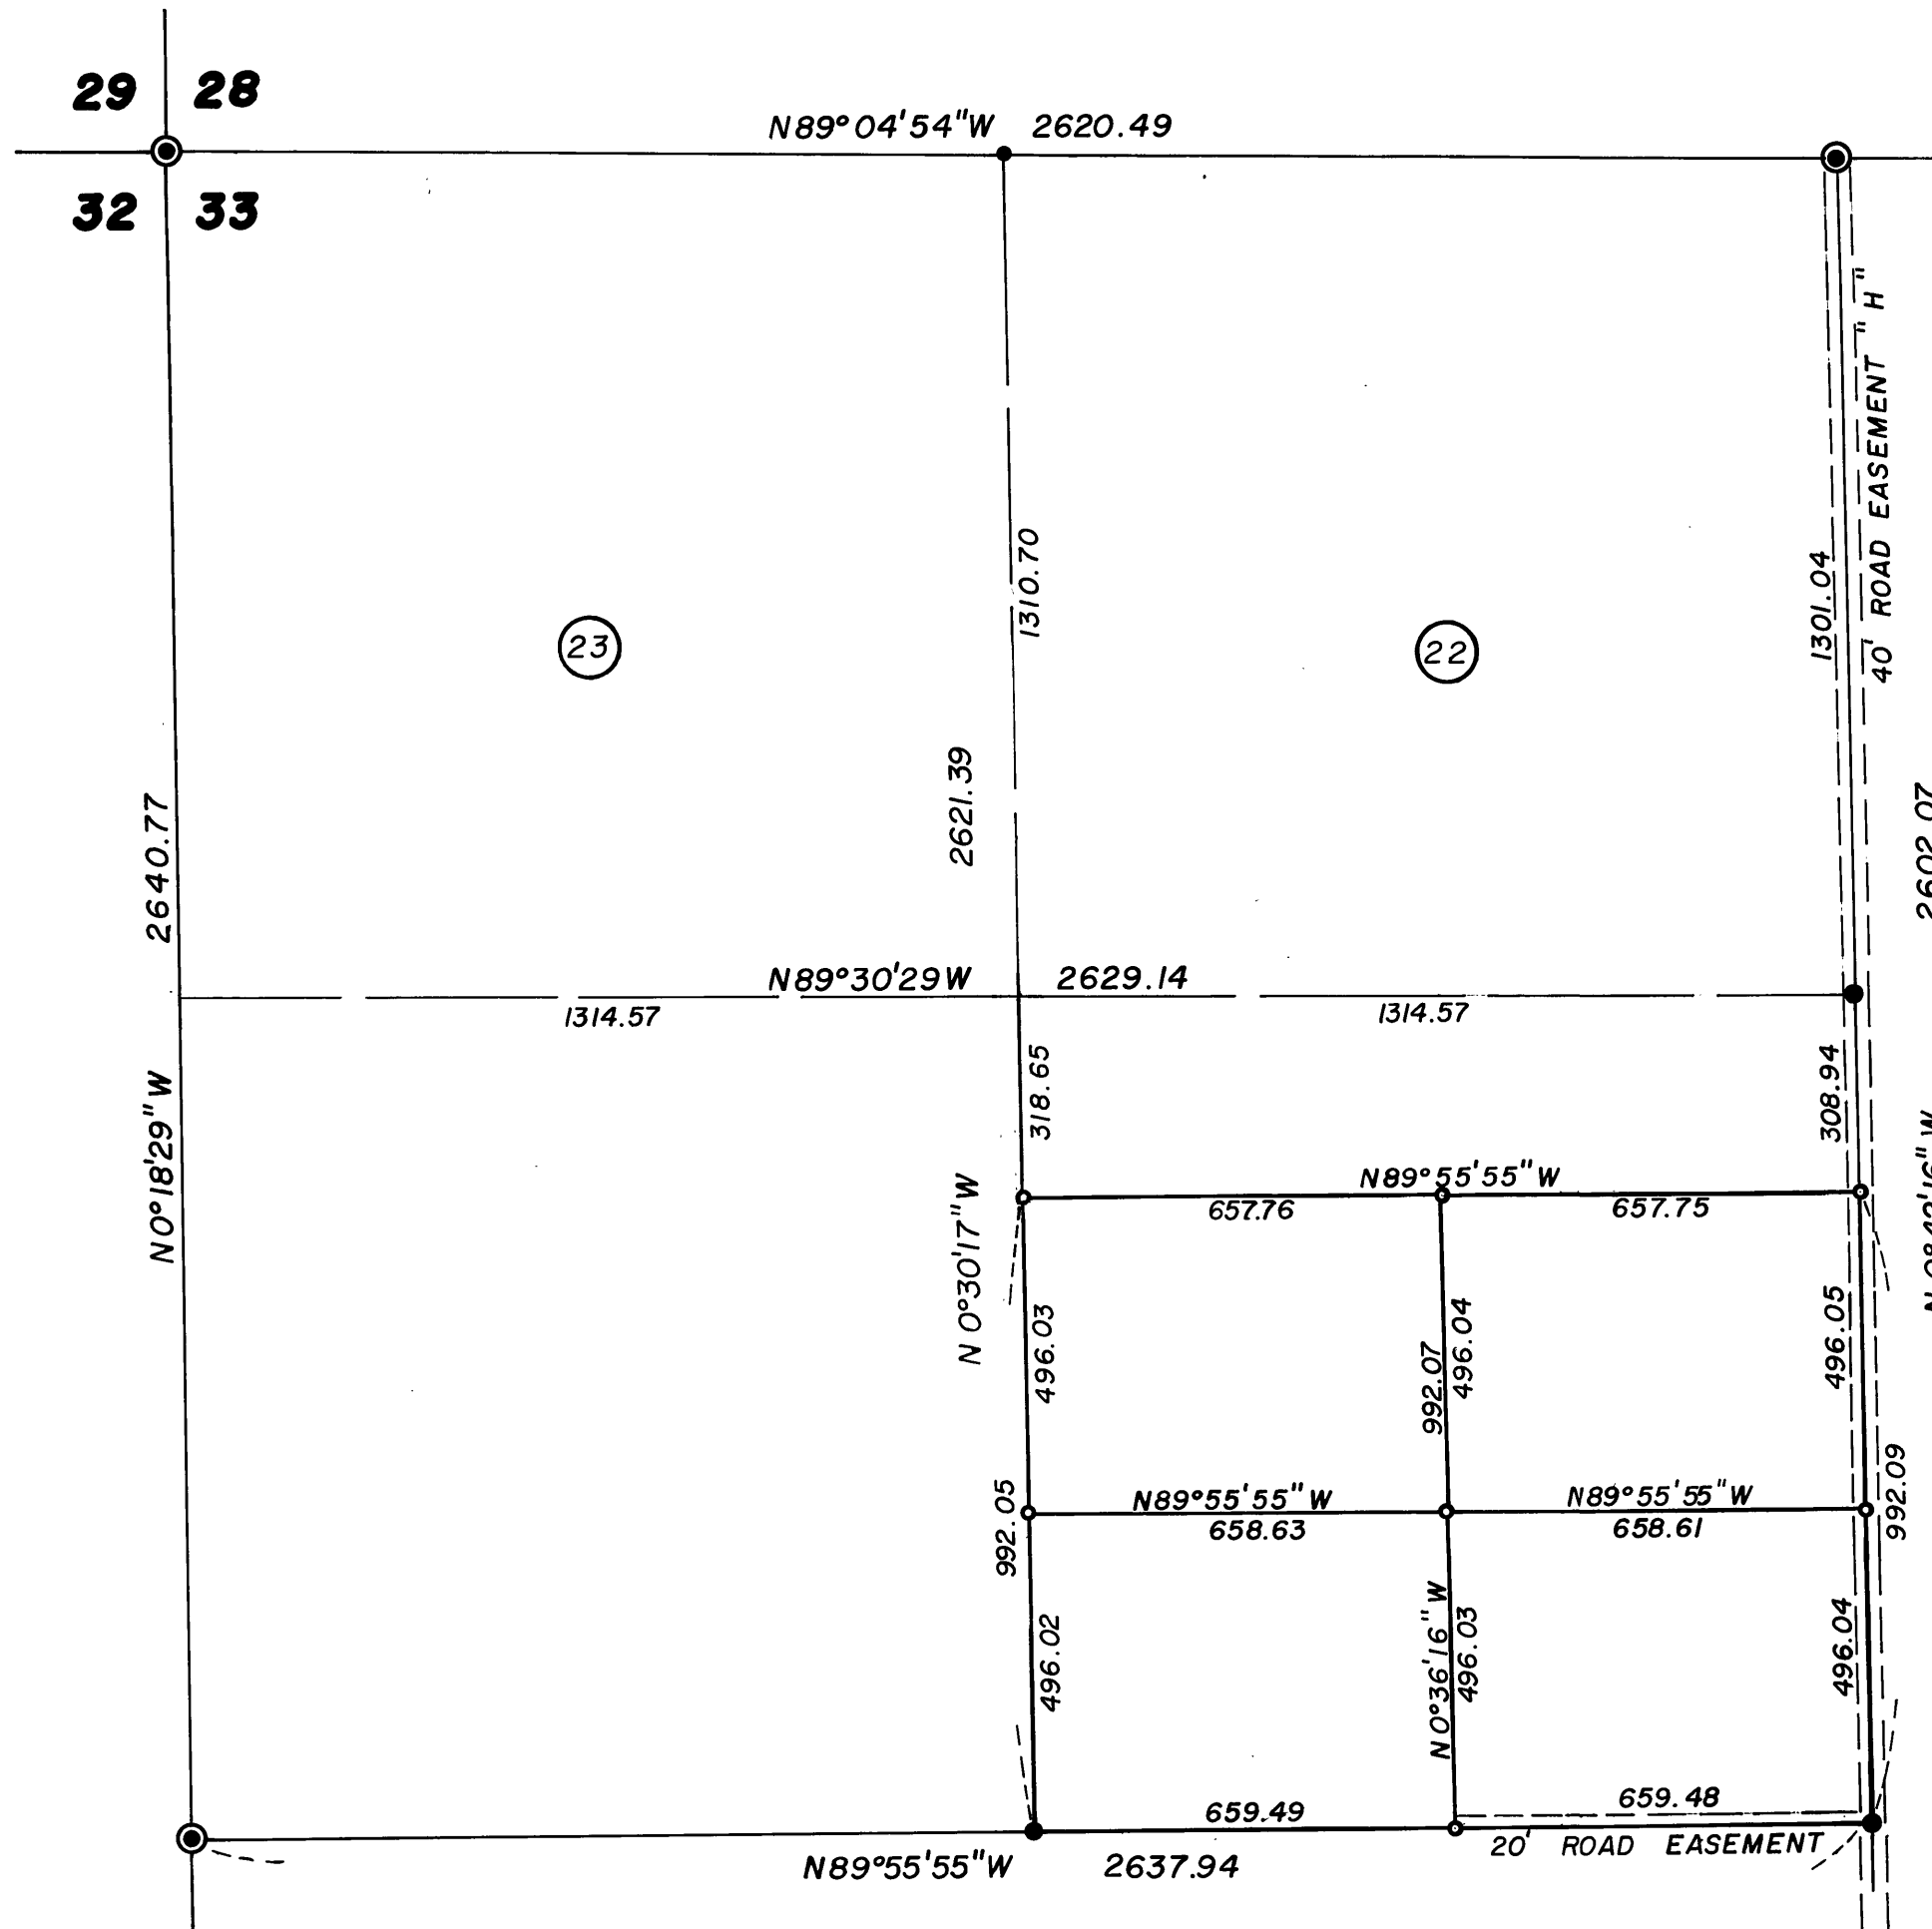

RECEIVED AND
FILED
AUG 24 1978
John Liveira
COUNTY CLERK
DEPT. OF LAND & FORESTRY



BASIS OF BEARINGS

MAP OF SURVEY NO. 324


LEGEND

- FD 5/8" IRON PIN
- SET 5/8" X 30" IRON PIN
- ⊙ FD GRANT CO. SURVEYOR BRASS CAP

REFERENCES

MAP OF SURVEY NO. 324

PARCELS IN THE SOUTH 992.0 FT.
OF THE SE 1/4 NW 1/4.

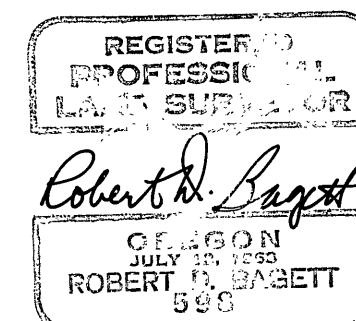

BAGETT, GRIFFITH & ASSOCIATES

John Day, Oregon

Map of Survey

A PORTION OF THE SE 1/4 NW 1/4
OF SECTION 33, T 13 S., R. 31 E., W.M.

WEST BENCH

GRANT COUNTY, OREGON

SURVEYED FOR	CHUCK LEDFORD	
SURVEYED BY	R.D.B. & S.F.J.	8-18-78
Scale: 1" = 30'	Drawn by: S.F.J.	8-22-78

MAP OF SURVEY 528