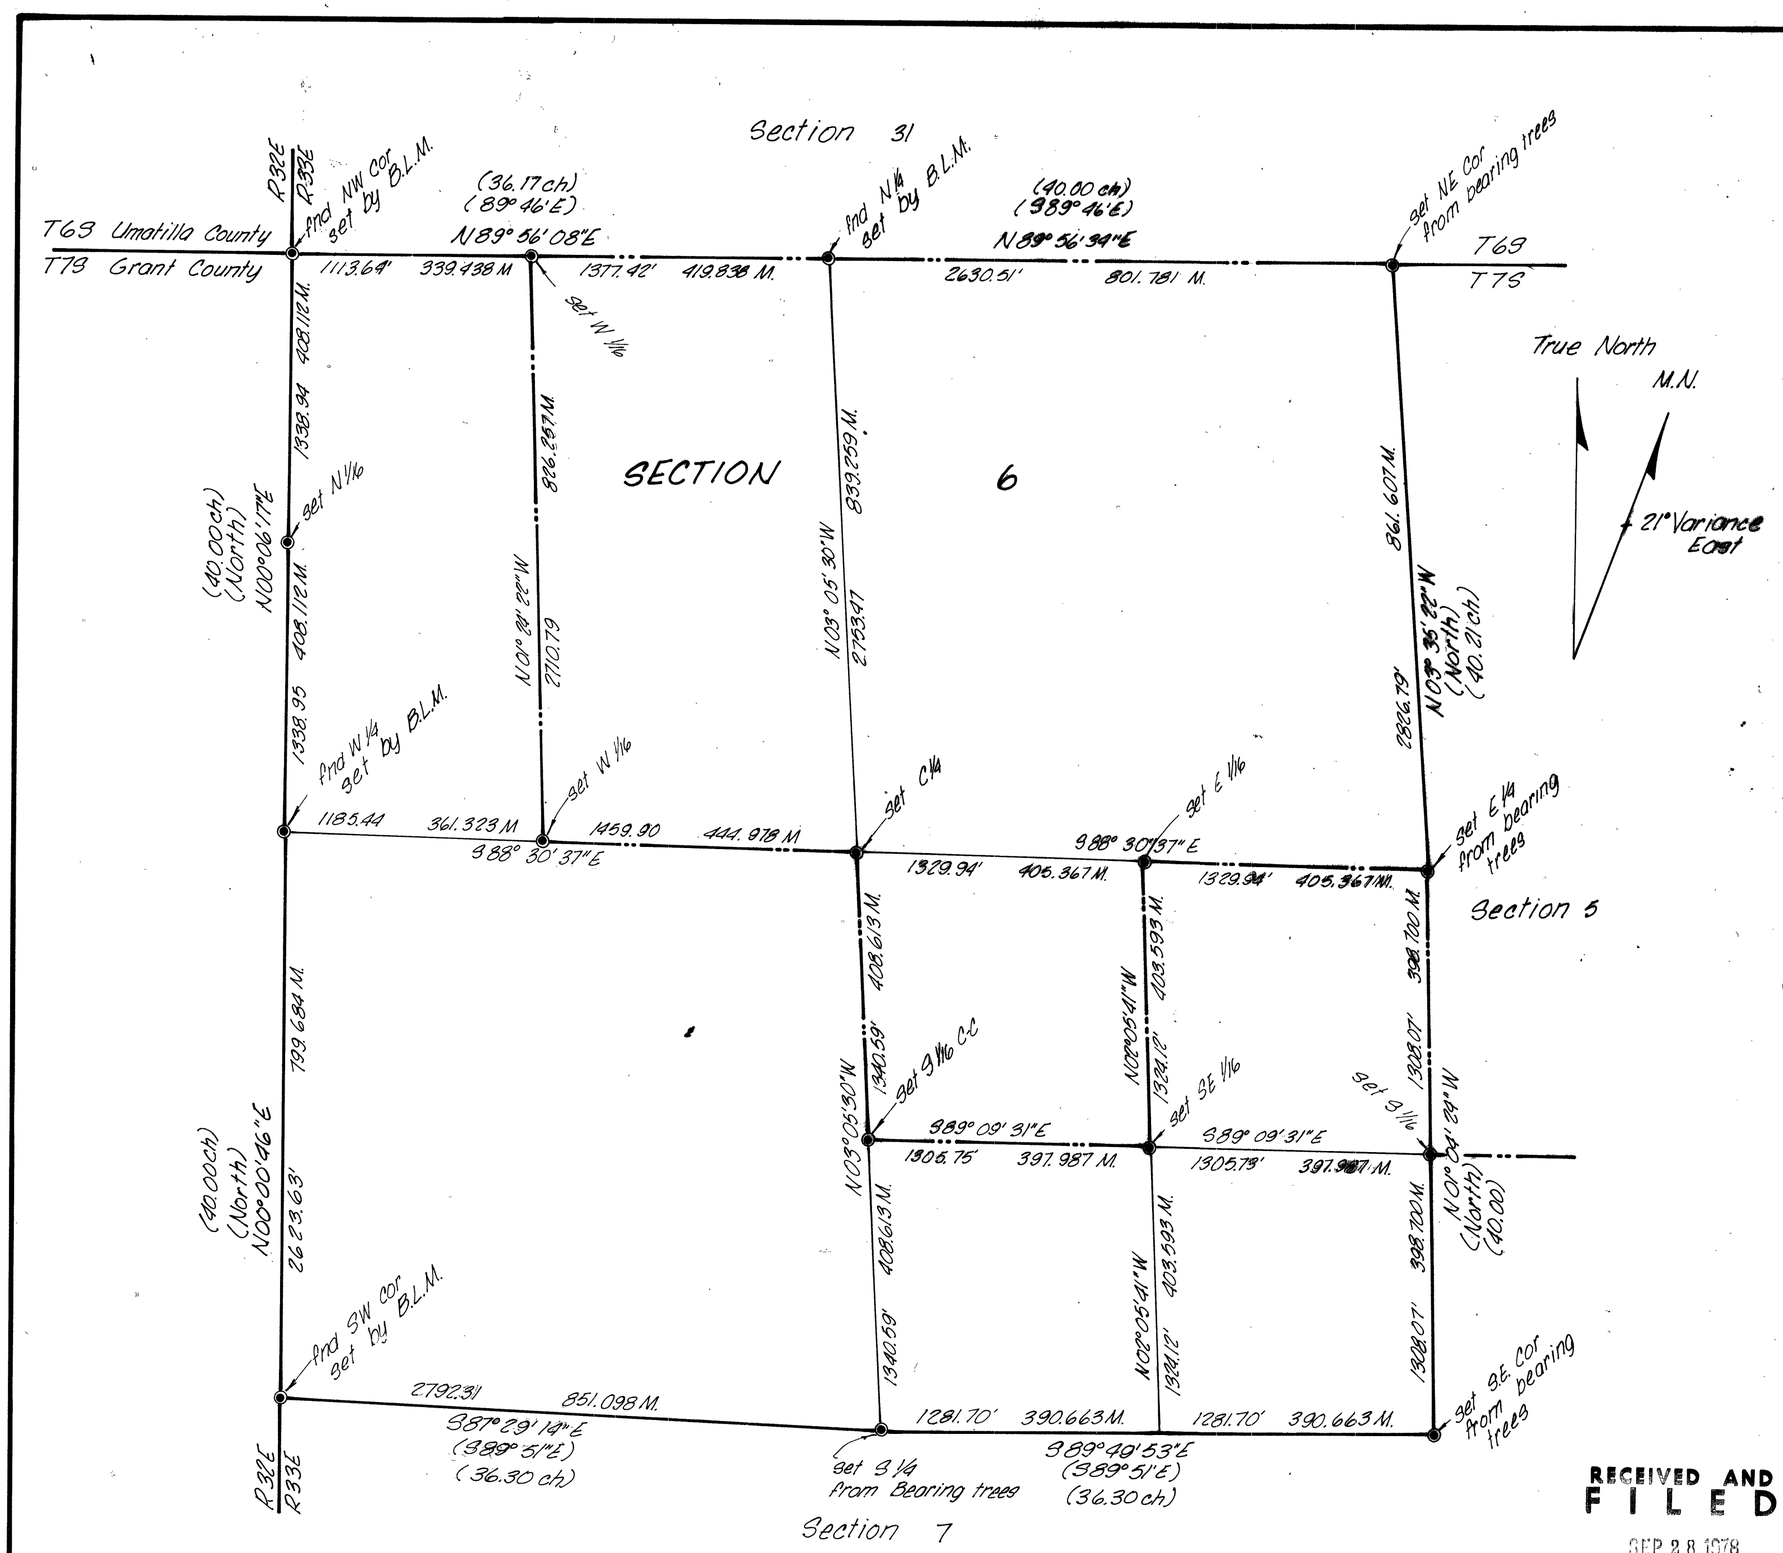

denotes U.S. Forest Service Boundary

◉ denotes Brass Cap

( ) denotes G.L.O. record bearings & distances

NOTES:

Bearings are based on observation of Polaris August 3, 1978, SEE Book 1, pages 164-178., SEE Traverse Detail Sheet 3 of 3. All bearings and distances shown are true.

All field notes for traverses for Section 6 are in Book 2.. Notes used to set Brass Caps are in Book 2 pages 170-190. All accessory ties for corners set in Section 6 are described in Certified Record of Land Monumentation.

Computations for all corners set are based on the Manual of Surveying Instruction 1973, Chapter 5, see Book 2, page 91 for computation done.

Sheet one is on file with Umatilla County.
Sheet three is for U.S. Forest Service use only.

LEGAL DESCRIPTION

U.S. Forest Service ownership; the Northeast one-quarter and the East half of the Northwest one-quarter; and the Northwest one-quarter of the Southeast one-quarter; all being in Section 6, Township 7 South, Range 33 East of the Willamette Meridian.

I, David H. Krumbein, a registered land surveyor (Engineer) in the State of Oregon, hereby certify that this plat and the notes hereon, or attached, are a correct representation of a survey I performed during May-August, 1978 for the U.S. Forest Service in accordance with the statutes of the State of Oregon and with the Articles of my contract.

David H Krumbein (a) David H. Krumbein
Registered Land Surveyor
Oregon License No. 933

RECEIVED AND FILED
SEP 28 1978
JOHN LIVEIRA, County Clerk
By Louann Holland Deputy

REGISTERED PROFESSIONAL LAND SURVEYOR
David H Krumbein
OREGON JULY 17, 1970
DAVID H. KRUMBEIN
933

Sheet 2 of 3

KRUMBEIN ENGINEERING CO. ENGINEERS – SURVEYORS – PLANNERS 221 S. Main, Pendleton, Oregon	SCALE 1" = 500'
	DATE Sept 7, 1978
Survey for U.S. FOREST SERVICE Section 6, T79, R33E W.M.	DRN. BY TAG
	CKD. BY TEH
	DRNG. NO. 78-612

MAP OF Survey No. 533 Job No 78-58