


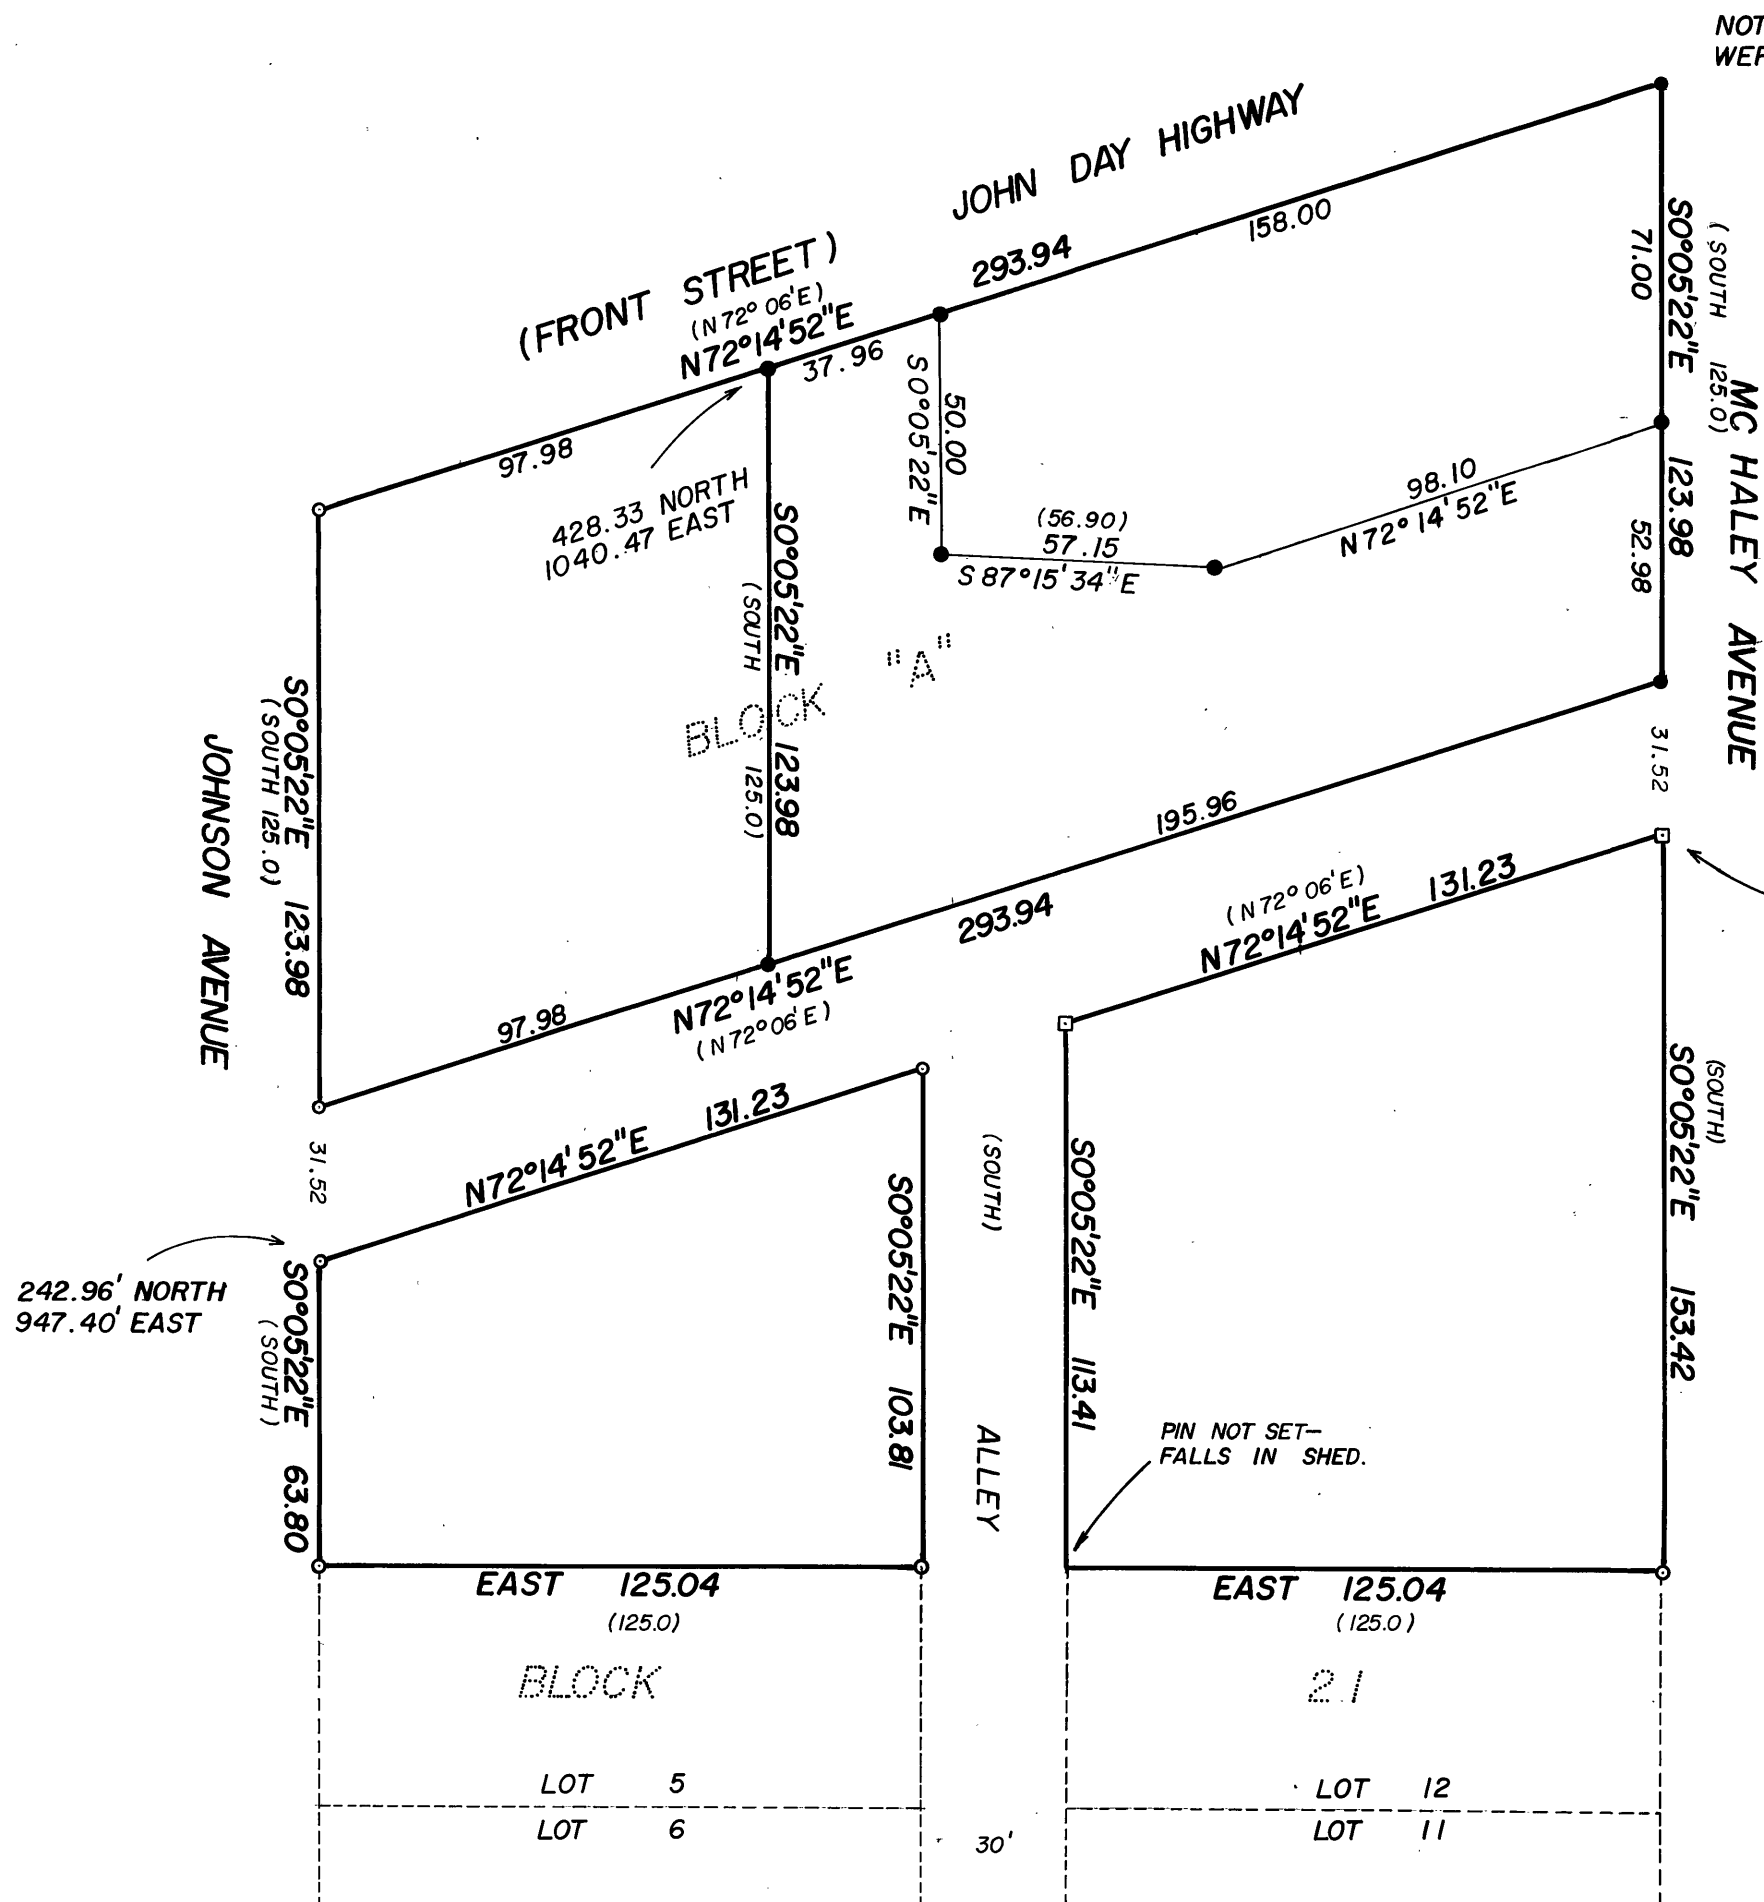

REGISTERED
F. L. L.
JUL 28 1978
JOHN LEVIERA, County Clerk
D. Lammie Lawrence Deputy

BASIS OF BEARINGS
SOLAR OBSERVATION

LEGEND

- FD. 5/8" X 30" IRON PIN SET IN SURVEY NO. 113.
- SET 5/8" X 30" IRON PIN
- CHISELED 2 1/2" "X" IN CONC. SIDEWALK.
- () RECORD BEARING & DIST.

REFERENCES

MAP OF SURVEY
NO. 113

PLAT OF PRAIRIE CITY LAND
COMPANY'S SECOND ADDITION
TO THE CITY OF PRAIRIE
CITY.

BAGETT, GRIFFITH & ASSOCIATES

John Day, Oregon

Map of Survey

TRACTS IN BLOCK "A" AND A PORTION
OF BLOCK "21" IN PRAIRIE CITY LAND
COMPANY'S SECOND ADDITION TO THE
CITY OF PRAIRIE CITY.

GRANT COUNTY, OREGON

SURVEYED FOR	GILMAN-HALL-FRANKLIN	
SURVEYED BY	R.D.B. & S.F.J.	9-78
Scale: 1" = 40'	Drawn by: S.F.J.	9-78

MAP OF SURVEY NO. 536