



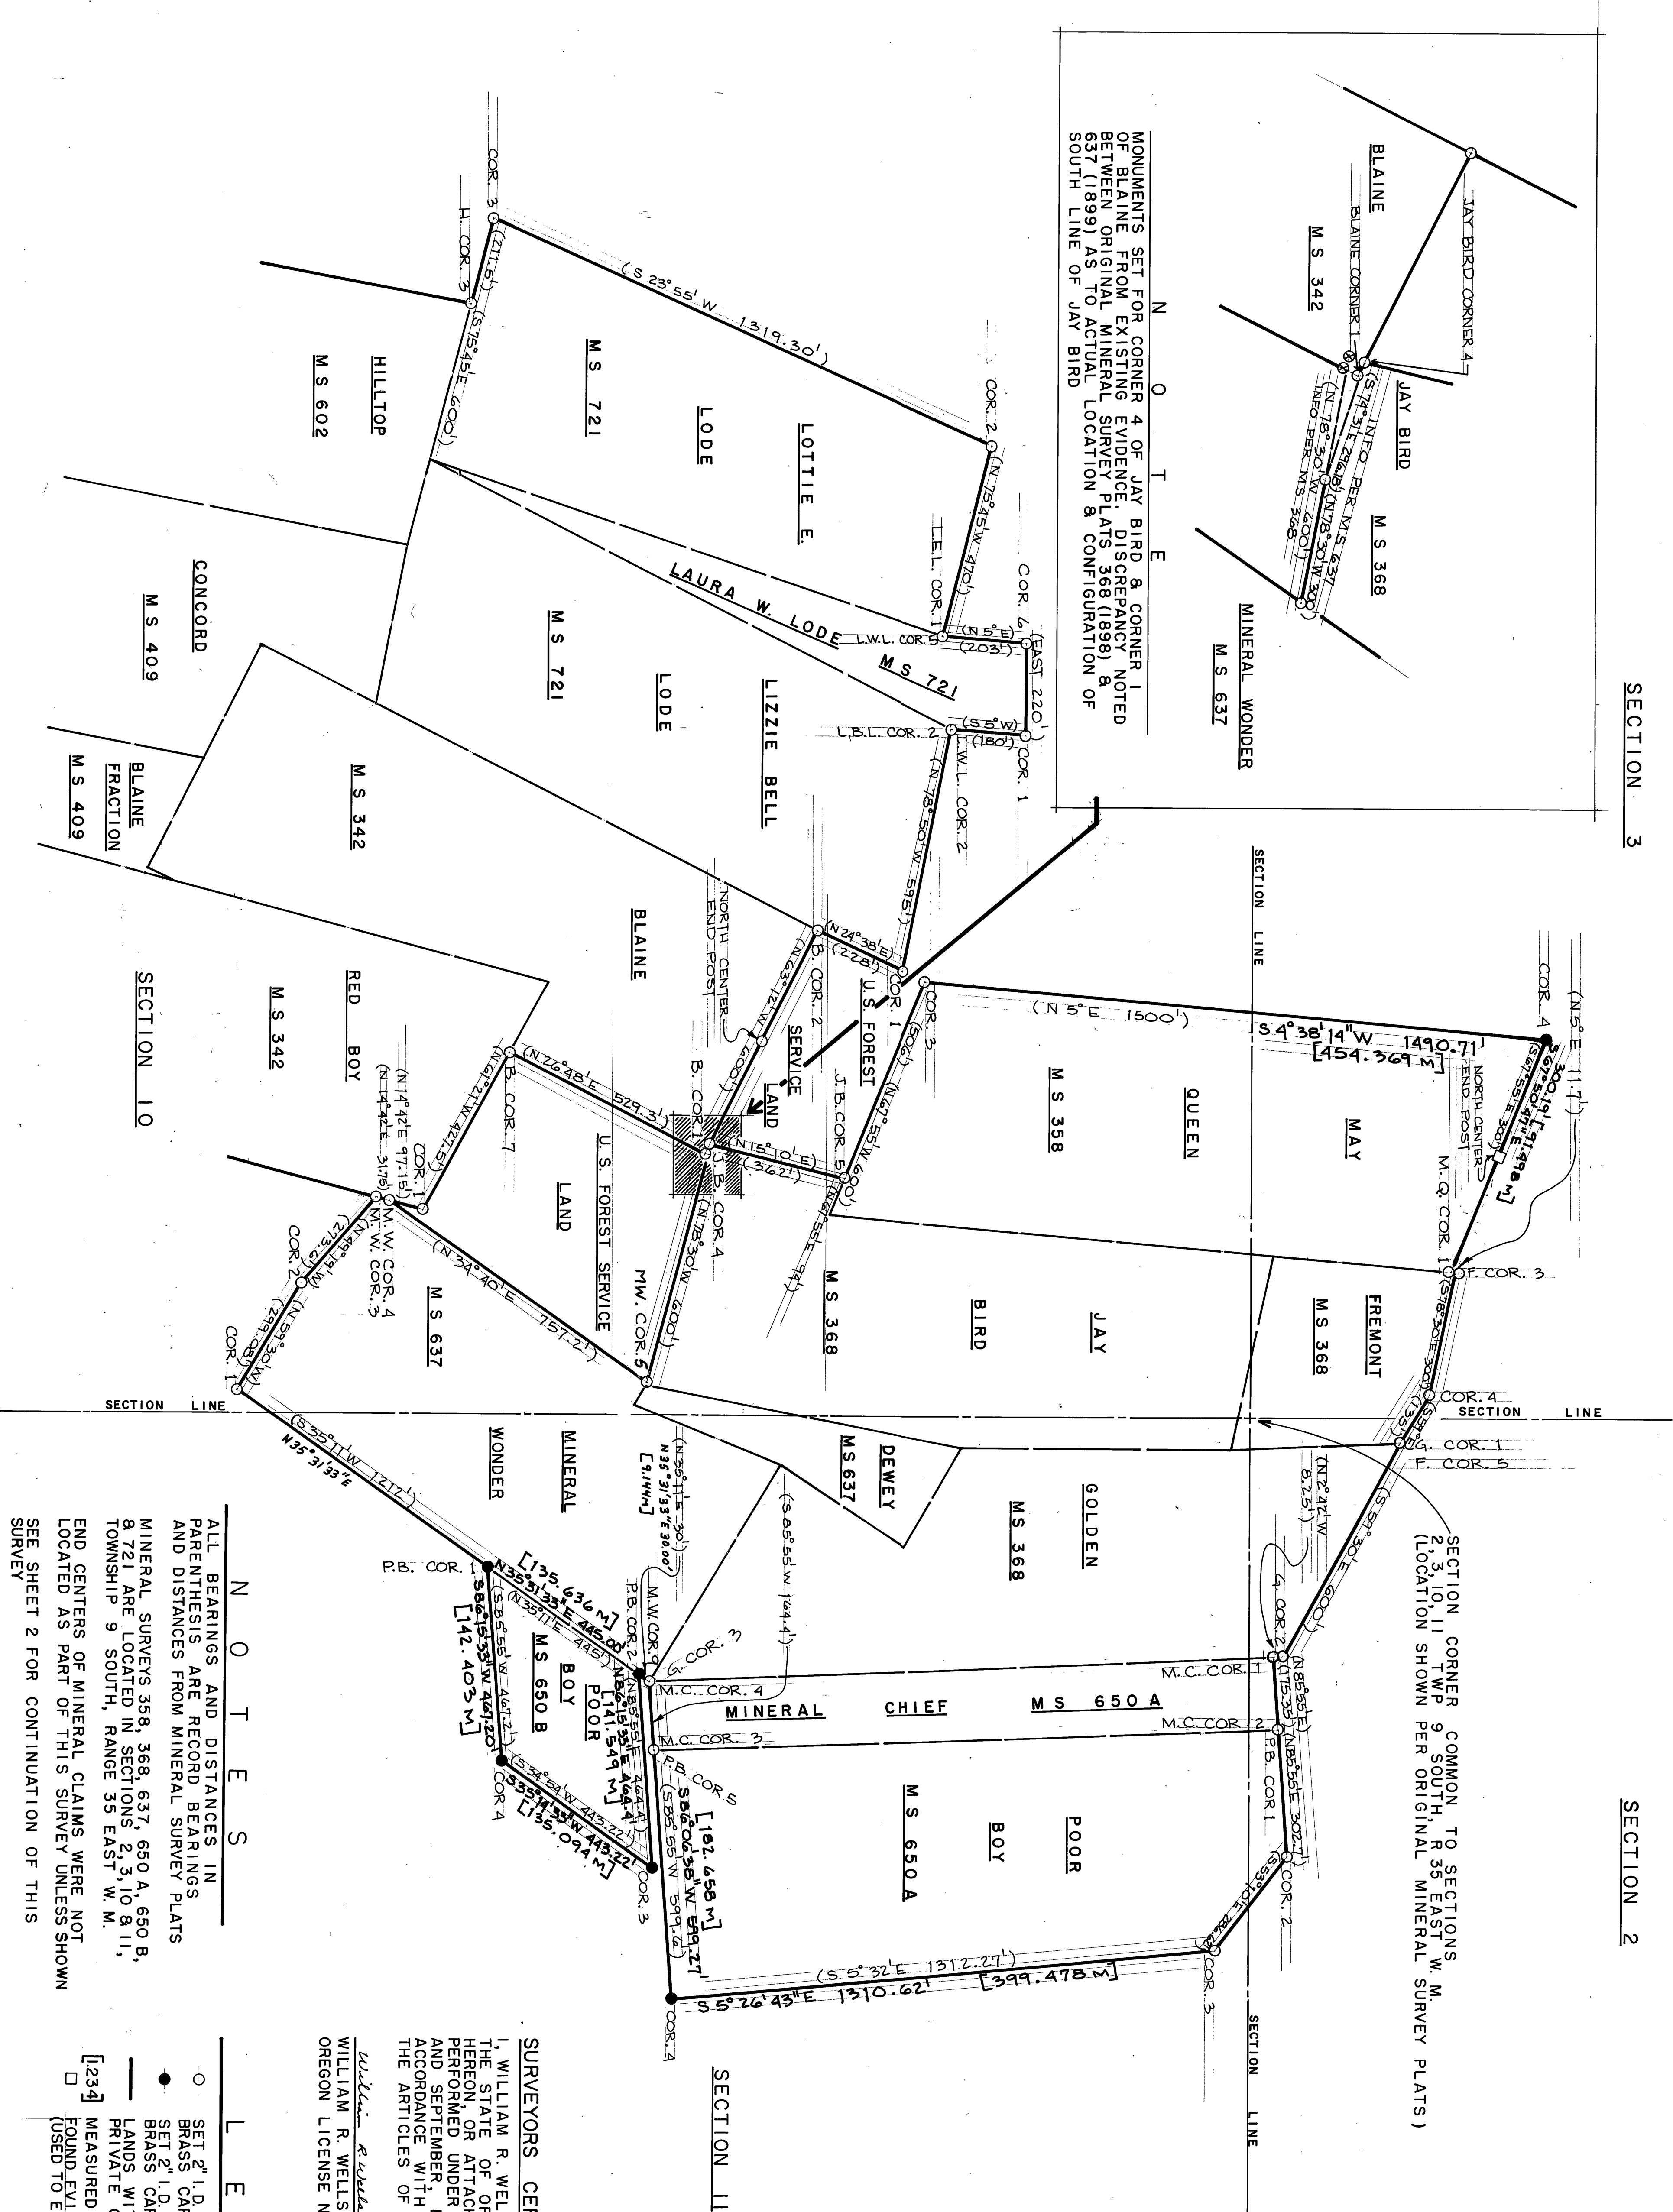

ALL BEARINGS AND DISTANCES IN PARENTHESES ARE RECORD BEARINGS AND DISTANCES FROM MINERAL SURVEY PLATS. MINERAL SURVEYS 358, 368, 637, 650 A, 650 B, 650 C, 650 D, 650 E, 650 F, 650 G, 650 H, 650 I, 650 J, 650 K, 650 L, 650 M, 650 N, 650 O, 650 P, 650 Q, 650 R, 650 S, 650 T, 650 U, 650 V, 650 W, 650 X, 650 Y, 650 Z, 650 AA, 650 AB, 650 AC, 650 AD, 650 AE, 650 AF, 650 AG, 650 AH, 650 AI, 650 AJ, 650 

LEGEND
○ SET 1" D GALV IRON PIPE 30" LONG WITH 2 1/2" BRASS CAP FROM EXISTING EVIDENCE
● BRASS CAP ONLY FROM EXISTING EVIDENCE
— LANDS WITHIN HEAVY LINES ARE HELD IN PRIVATE OWNERSHIP
[234] MEASURED DISTANCE IN METERS FOUND EVIDENCE OF ORIGINAL POST (USED TO ESTABLISH MISSING CORNERS)

SURVEYORS CERTIFICATION
I, WILLIAM R. WELLS, A REGISTERED PROFESSIONAL LAND SURVEYOR IN THE STATE OF OREGON, HEREBY CERTIFY THAT THIS PLAT AND NOTES HEREON, OR ATTACHED, ARE A CORRECT REPRESENTATION OF A SURVEY PERFORMED UNDER MY DIRECT SUPERVISION DURING JUNE, JULY, AUGUST, AND SEPTEMBER, 1978 FOR THE U.S. FOREST SERVICE, IN ACCORDANCE WITH THE STATUTES OF THE STATE OF OREGON AND WITH THE ARTICLES OF THE CONTRACT.
WILLIAM R. WELLS
REGISTERED PROFESSIONAL LAND SURVEYOR
OREGON LICENSE NO. 1106

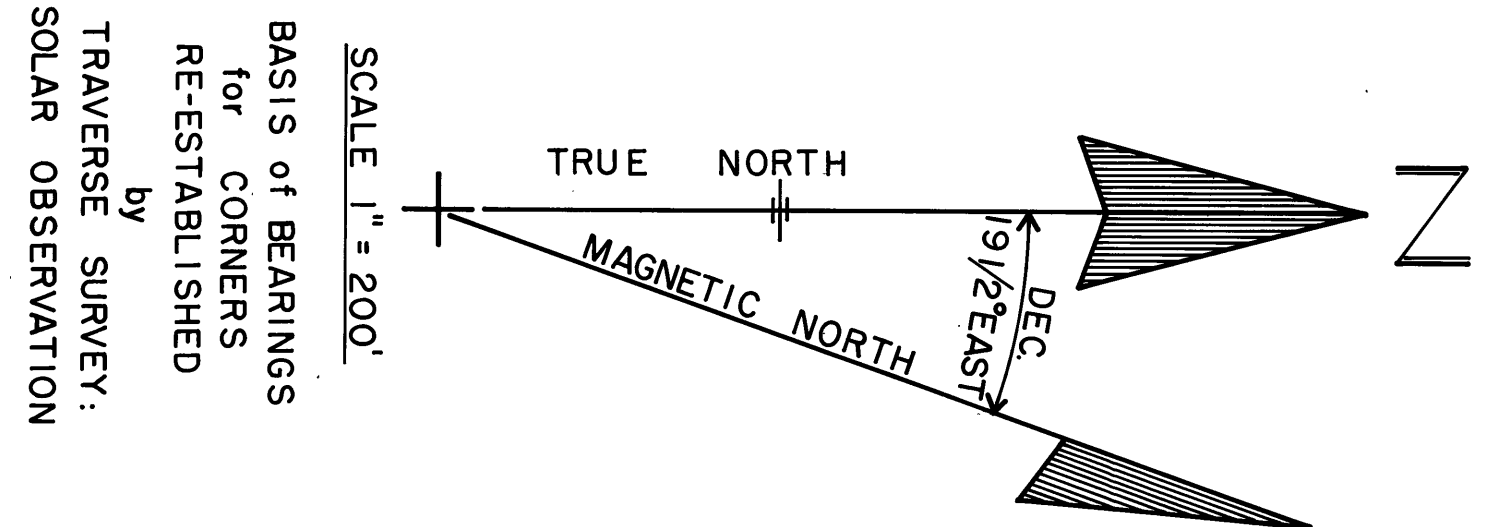

MAP OF Survey 16 537

DRAWING I SHEET 1 OF 4	TITLE MINERAL SURVEYS 358, 368, 637, 650 A, 650 B, 721 REVISIONS	WALLULIS & ASSOCIATES, INC. ENGINEERING & PLANNING P.O. BOX 1598 PENDLETON, OREGON 97801 503 276 1598	PROJECT DALE 1978 CADASTRAL SURVEY A SURVEY INCLUDING CORNER SEARCH FOR ORIGINAL MINERAL SURVEY CORNERS AND RE-ESTABLISHMENT OF CERTAIN LOST CORNERS PERFORMED FOR UNITED STATES FOREST SERVICE - UMATILLA DISTRICT	WALLULIS PROJECT NO. 78-105 AGENCY PROJECT NO. U.S.F.S. CONTRACT NO. 006828N
-------------------------------------	--	---	---	---