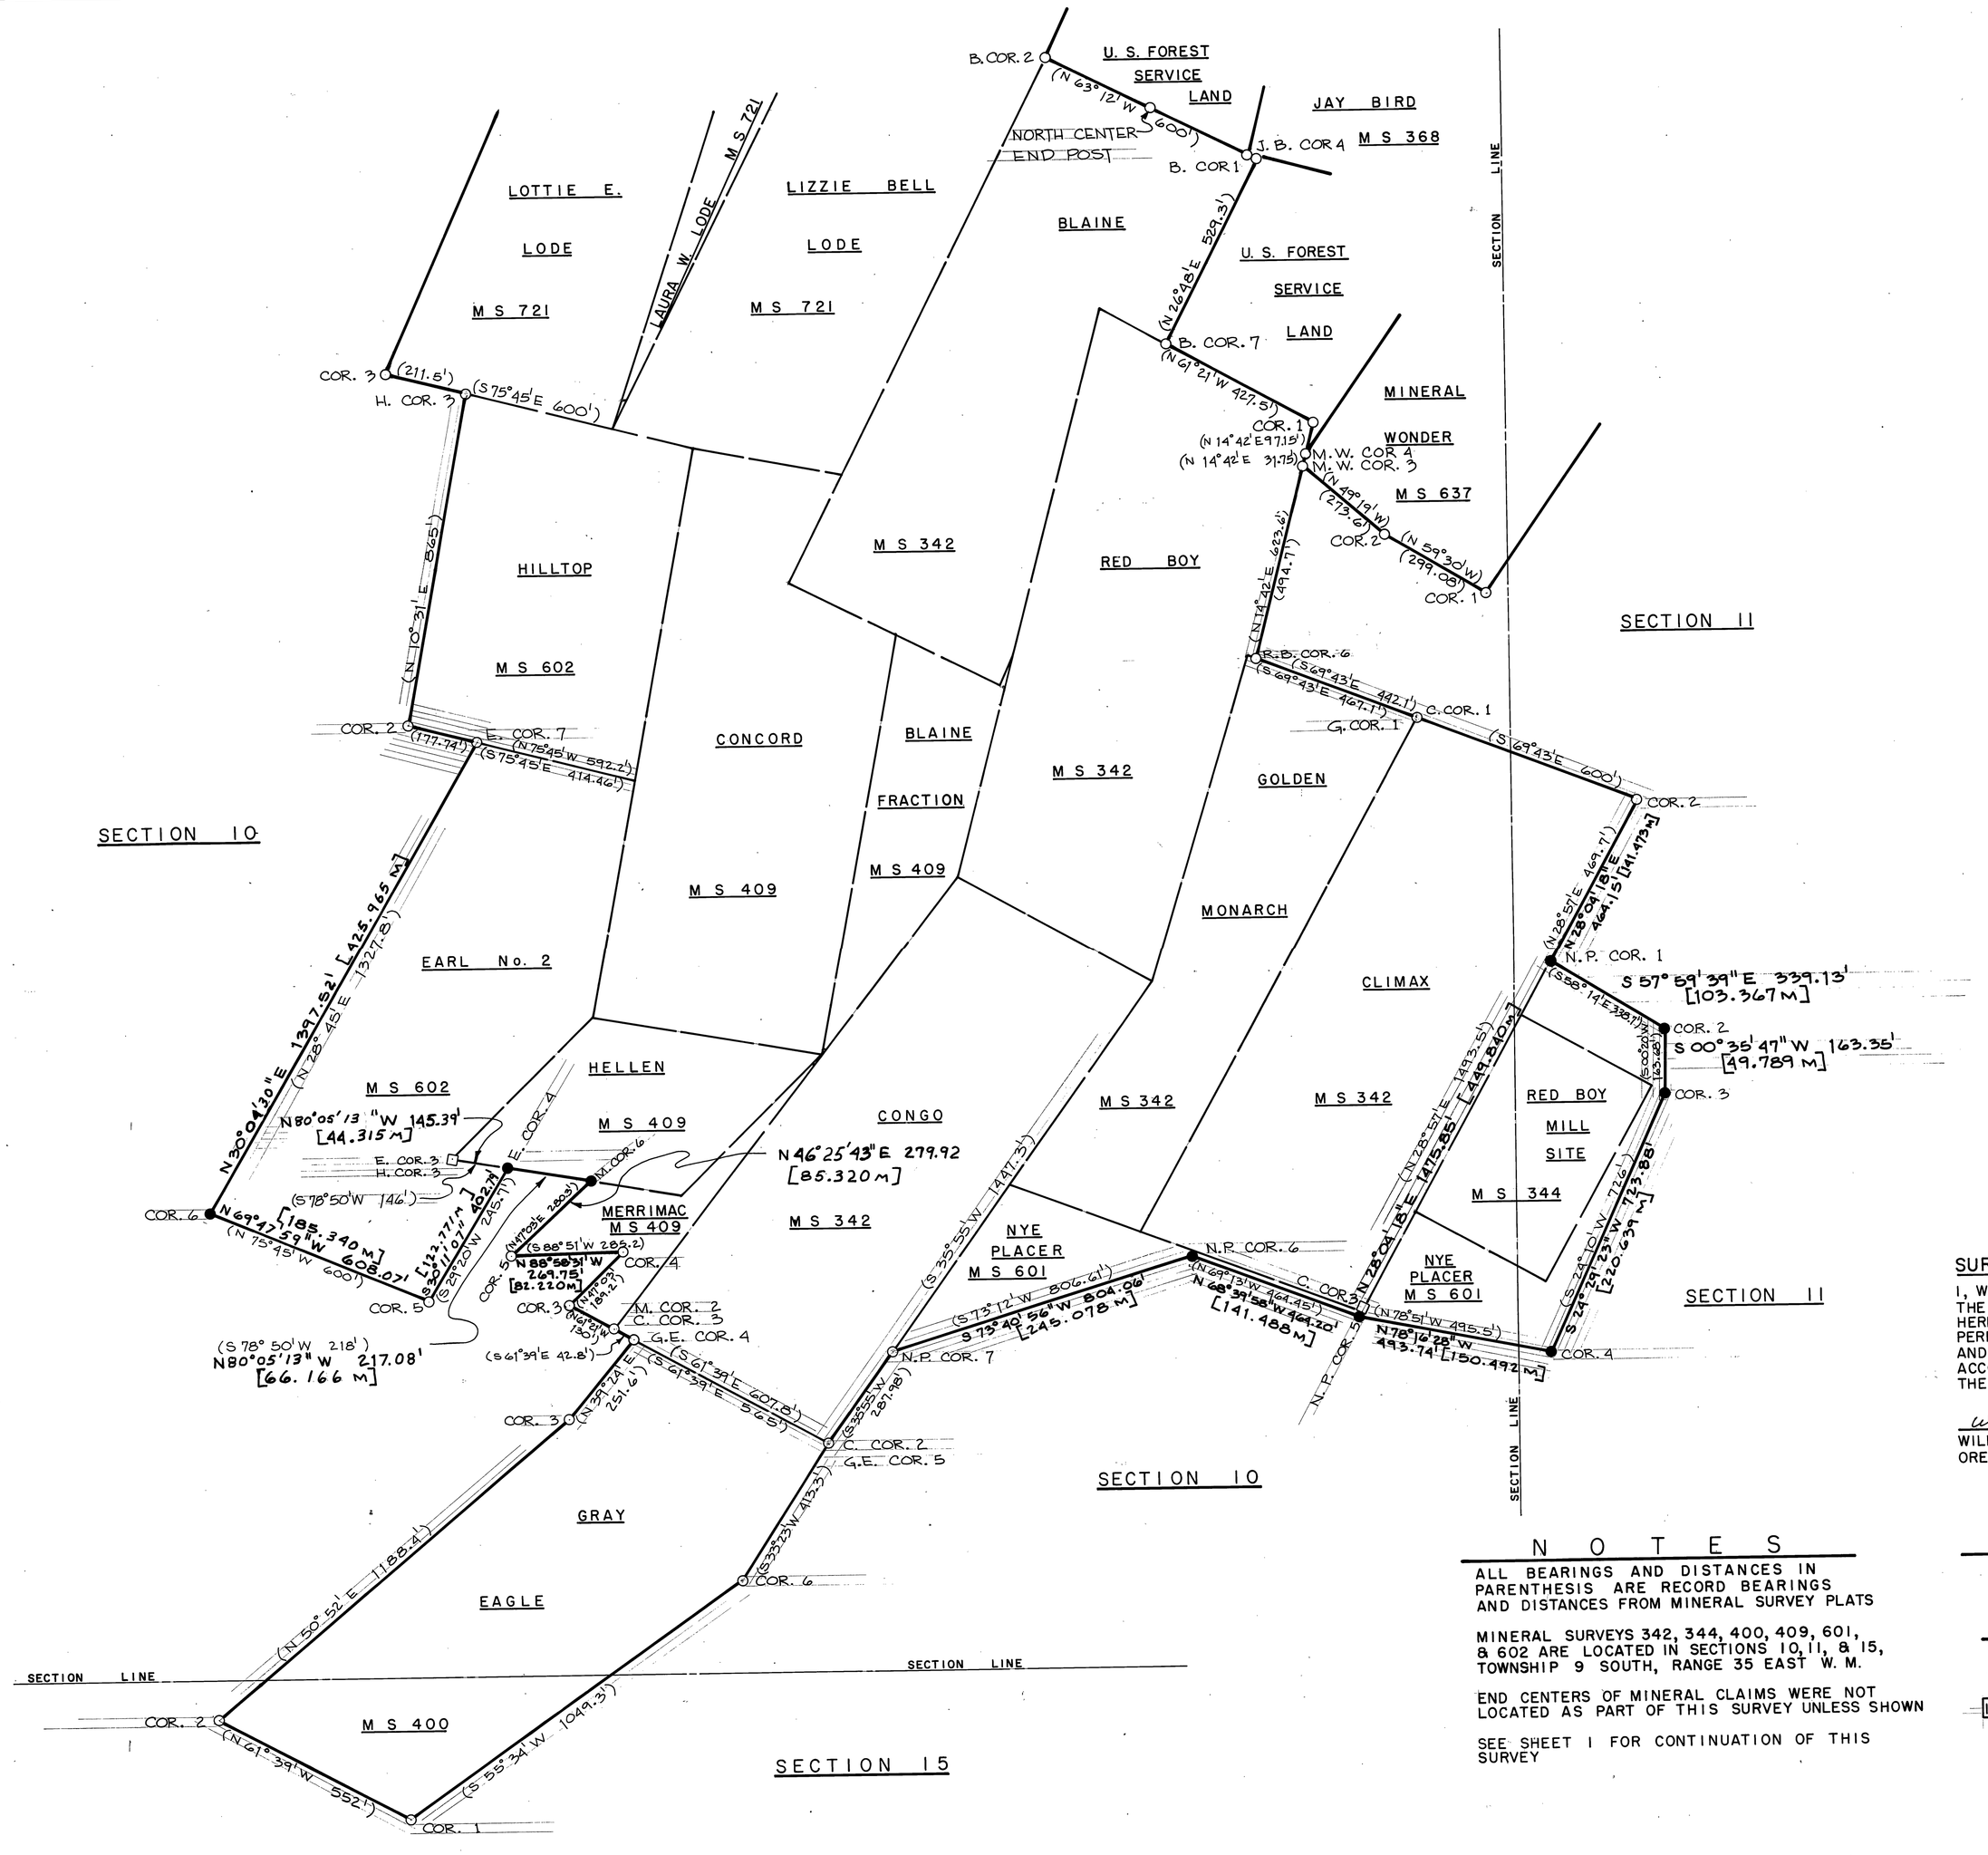

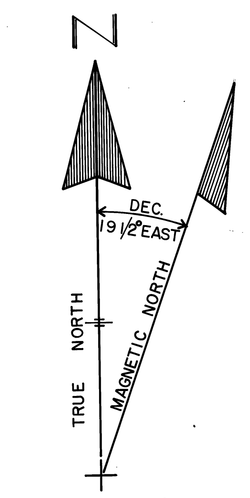

SCALE 1" = 200'

BASIS of BEARINGS for CORNERS RE-ESTABLISHED by TRAVERSE SURVEY: SOLAR OBSERVATION

SURVEYORS CERTIFICATION:

I, WILLIAM R. WELLS, A REGISTERED PROFESSIONAL LAND SURVEYOR IN THE STATE OF OREGON, HEREBY CERTIFY THAT THIS PLAT AND NOTES HEREON, OR ATTACHED, ARE A CORRECT REPRESENTATION OF A SURVEY PERFORMED UNDER MY DIRECT SUPERVISION DURING JUNE, JULY, AUGUST, AND SEPTEMBER, 1978 FOR THE U. S. FOREST SERVICE, IN ACCORDANCE WITH THE STATUTES OF THE STATE OF OREGON AND WITH THE ARTICLES OF THE CONTRACT.

REGISTERED PROFESSIONAL LAND SURVEYOR

William R. Wells

OREGON JULY 22, 1977 WILLIAM R. WELLS 1106

William R. Wells
WILLIAM R. WELLS, P.L.S.
OREGON LICENSE No. 1106

N O T E S

ALL BEARINGS AND DISTANCES IN PARENTHESIS ARE RECORD BEARINGS AND DISTANCES FROM MINERAL SURVEY PLATS

MINERAL SURVEYS 342, 344, 400, 409, 601, & 602 ARE LOCATED IN SECTIONS 10, 11, & 15, TOWNSHIP 9 SOUTH, RANGE 35 EAST W. M.

END CENTERS OF MINERAL CLAIMS WERE NOT LOCATED AS PART OF THIS SURVEY UNLESS SHOWN

SEE SHEET 1 FOR CONTINUATION OF THIS SURVEY

L E G E N D

- ○ SET 2" I.D. GALV. IRON PIPE 30" LONG WITH 2 1/2" BRASS CAP FROM EXISTING EVIDENCE
- ● SET 2" I.D. GALV. IRON PIPE 30" LONG WITH 2 1/2" BRASS CAP BY TRAVERSE
- — LANDS WITHIN HEAVY LINES ARE HELD IN PRIVATE OWNERSHIP
- □ FOUND EVIDENCE OF ORIGINAL CORNER (USED TO ESTABLISH MISSING CORNERS)
- [1.234] MEASURED DISTANCE IN METERS

RECEIVED
OCT 11
Department of Commerce
Lonnie Laurence

WALLULIS PROJECT NO. 78-105

AGENCY PROJECT NO. U.S.F.S. CONTRACT NO. 006828N

PROJECT

DALE 1978 CADASTRAL SURVEY

A SURVEY INCLUDING CORNER SEARCH FOR ORIGINAL MINERAL SURVEY CORNERS AND RE-ESTABLISHMENT OF CERTAIN LOST CORNERS

PERFORMED FOR

UNITED STATES FOREST SERVICE - UMATILLA DISTRICT

WALLULIS & ASSOCIATES INC.
ENGINEERING & PLANNING
5.S.E. NYE AVENUE 108 EAST MAIN
PENDLETON OREGON 97801 HERMISTON, OREGON
503 · 276 · 1598 503 · 567 · 3331

SCALE	DATE	DES BY	DR BY	CK BY
1" = 200' - 0"	SEPT. 8, 1978		C. A. A.	W. R. W.

TITLE
MINERAL SURVEYS 342, 344, 400, 409, 601, 602

REVISIONS

DRAWING 2

SHEET 2 OF 4

MAP OF Survey No 537