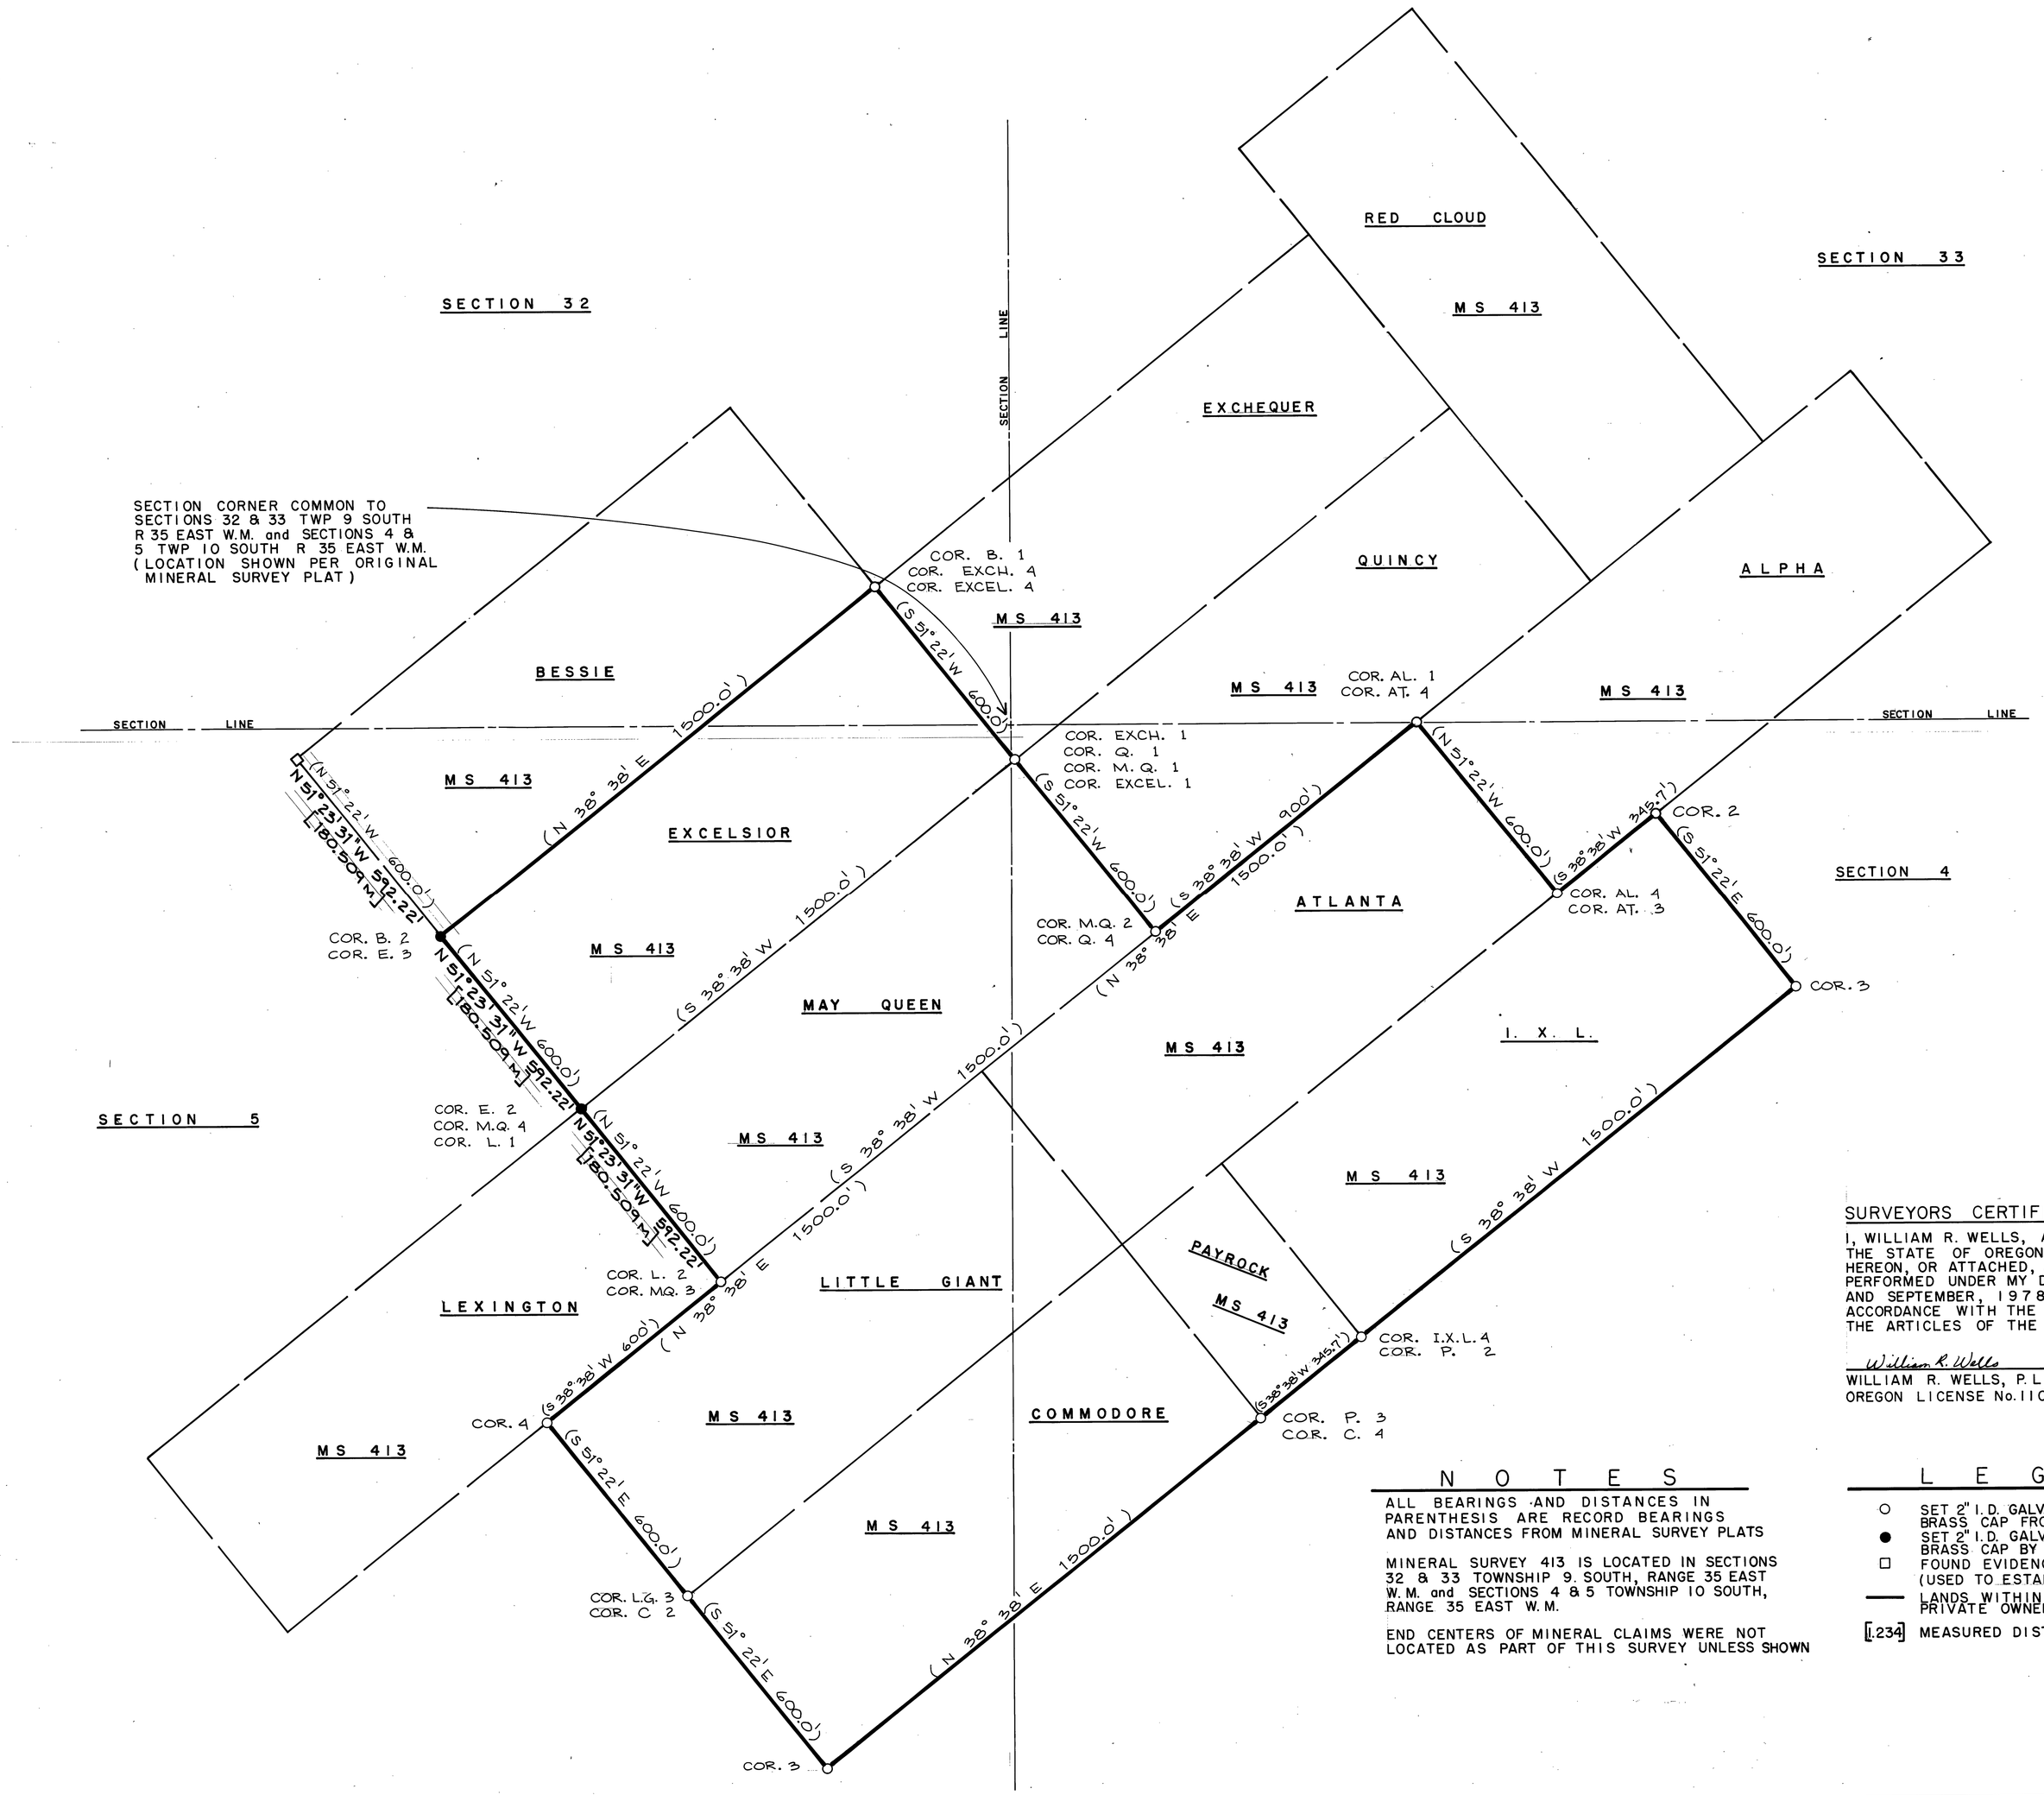

SCALE 1" = 200'

BASIS of BEARINGS for CORNERS RE-ESTABLISHED by TRAVERSE SURVEY: SOLAR OBSERVATION

SURVEYORS CERTIFICATION:

I, WILLIAM R. WELLS, A REGISTERED PROFESSIONAL LAND SURVEYOR IN THE STATE OF OREGON, HEREBY CERTIFY THAT THIS PLAT AND NOTES HEREON, OR ATTACHED, ARE A CORRECT REPRESENTATION OF A SURVEY PERFORMED UNDER MY DIRECT SUPERVISION DURING JUNE, JULY, AUGUST, AND SEPTEMBER, 1978 FOR THE U. S. FOREST SERVICE, IN ACCORDANCE WITH THE STATUTES OF THE STATE OF OREGON AND WITH THE ARTICLES OF THE CONTRACT.

REGISTERED PROFESSIONAL LAND SURVEYOR

William R. Wells

WILLIAM R. WELLS, P.L.S.
OREGON LICENSE No. 1106

OREGON JULY 22, 1977 WILLIAM R. WELLS 1106

N O T E S

ALL BEARINGS AND DISTANCES IN PARENTHESIS ARE RECORD BEARINGS AND DISTANCES FROM MINERAL SURVEY PLATS

MINERAL SURVEY 413 IS LOCATED IN SECTIONS 32 & 33 TOWNSHIP 9 SOUTH, RANGE 35 EAST W.M. and SECTIONS 4 & 5 TOWNSHIP 10 SOUTH, RANGE 35 EAST W.M.

END CENTERS OF MINERAL CLAIMS WERE NOT LOCATED AS PART OF THIS SURVEY UNLESS SHOWN

L E G E N D

- ○ SET 2" I.D. GALV. IRON PIPE 30" LONG WITH 2 1/2" BRASS CAP FROM EXISTING EVIDENCE
- ● SET 2" I.D. GALV. IRON PIPE 30" LONG WITH 2 1/2" BRASS CAP BY TRAVERSE
- □ FOUND EVIDENCE OF ORIGINAL CORNER (USED TO ESTABLISH MISSING CORNERS)
- —— LANDS WITHIN HEAVY LINES ARE HELD IN PRIVATE OWNERSHIP
- [1234] MEASURED DISTANCE IN METERS

RECEIVED FOR RECORD OCT 11 JOHN LUTTRELL, County Clerk By Jeannie Laurence

WALLULIS PROJECT NO. 78-105

AGENCY PROJECT NO. U.S.F.S. CONTRACT NO. 006828N

PROJECT

DALE 1978 CADASTRAL SURVEY

A SURVEY INCLUDING CORNER SEARCH FOR ORIGINAL MINERAL SURVEY CORNERS AND RE-ESTABLISHMENT OF CERTAIN LOST CORNERS

PERFORMED FOR

UNITED STATES FOREST SERVICE - UMATILLA DISTRICT

WALLULIS & ASSOCIATES
ENGINEERING & PLANNING
S.E. NYE AVENUE PENDLETON, OREGON 97801 HERMISTON, OREGON 97838 503 567 3331 503 276 1596

SCALE 1" = 200'-0" | DATE SEPT. 8, 1978 | DES BY | DR BY C.A.A. | CK BY W.R.W.

TITLE
MINERAL SURVEY 413

REVISIONS

DRAWING 4

SHEET 4 OF 4

MAP OF SURVEY No 537