


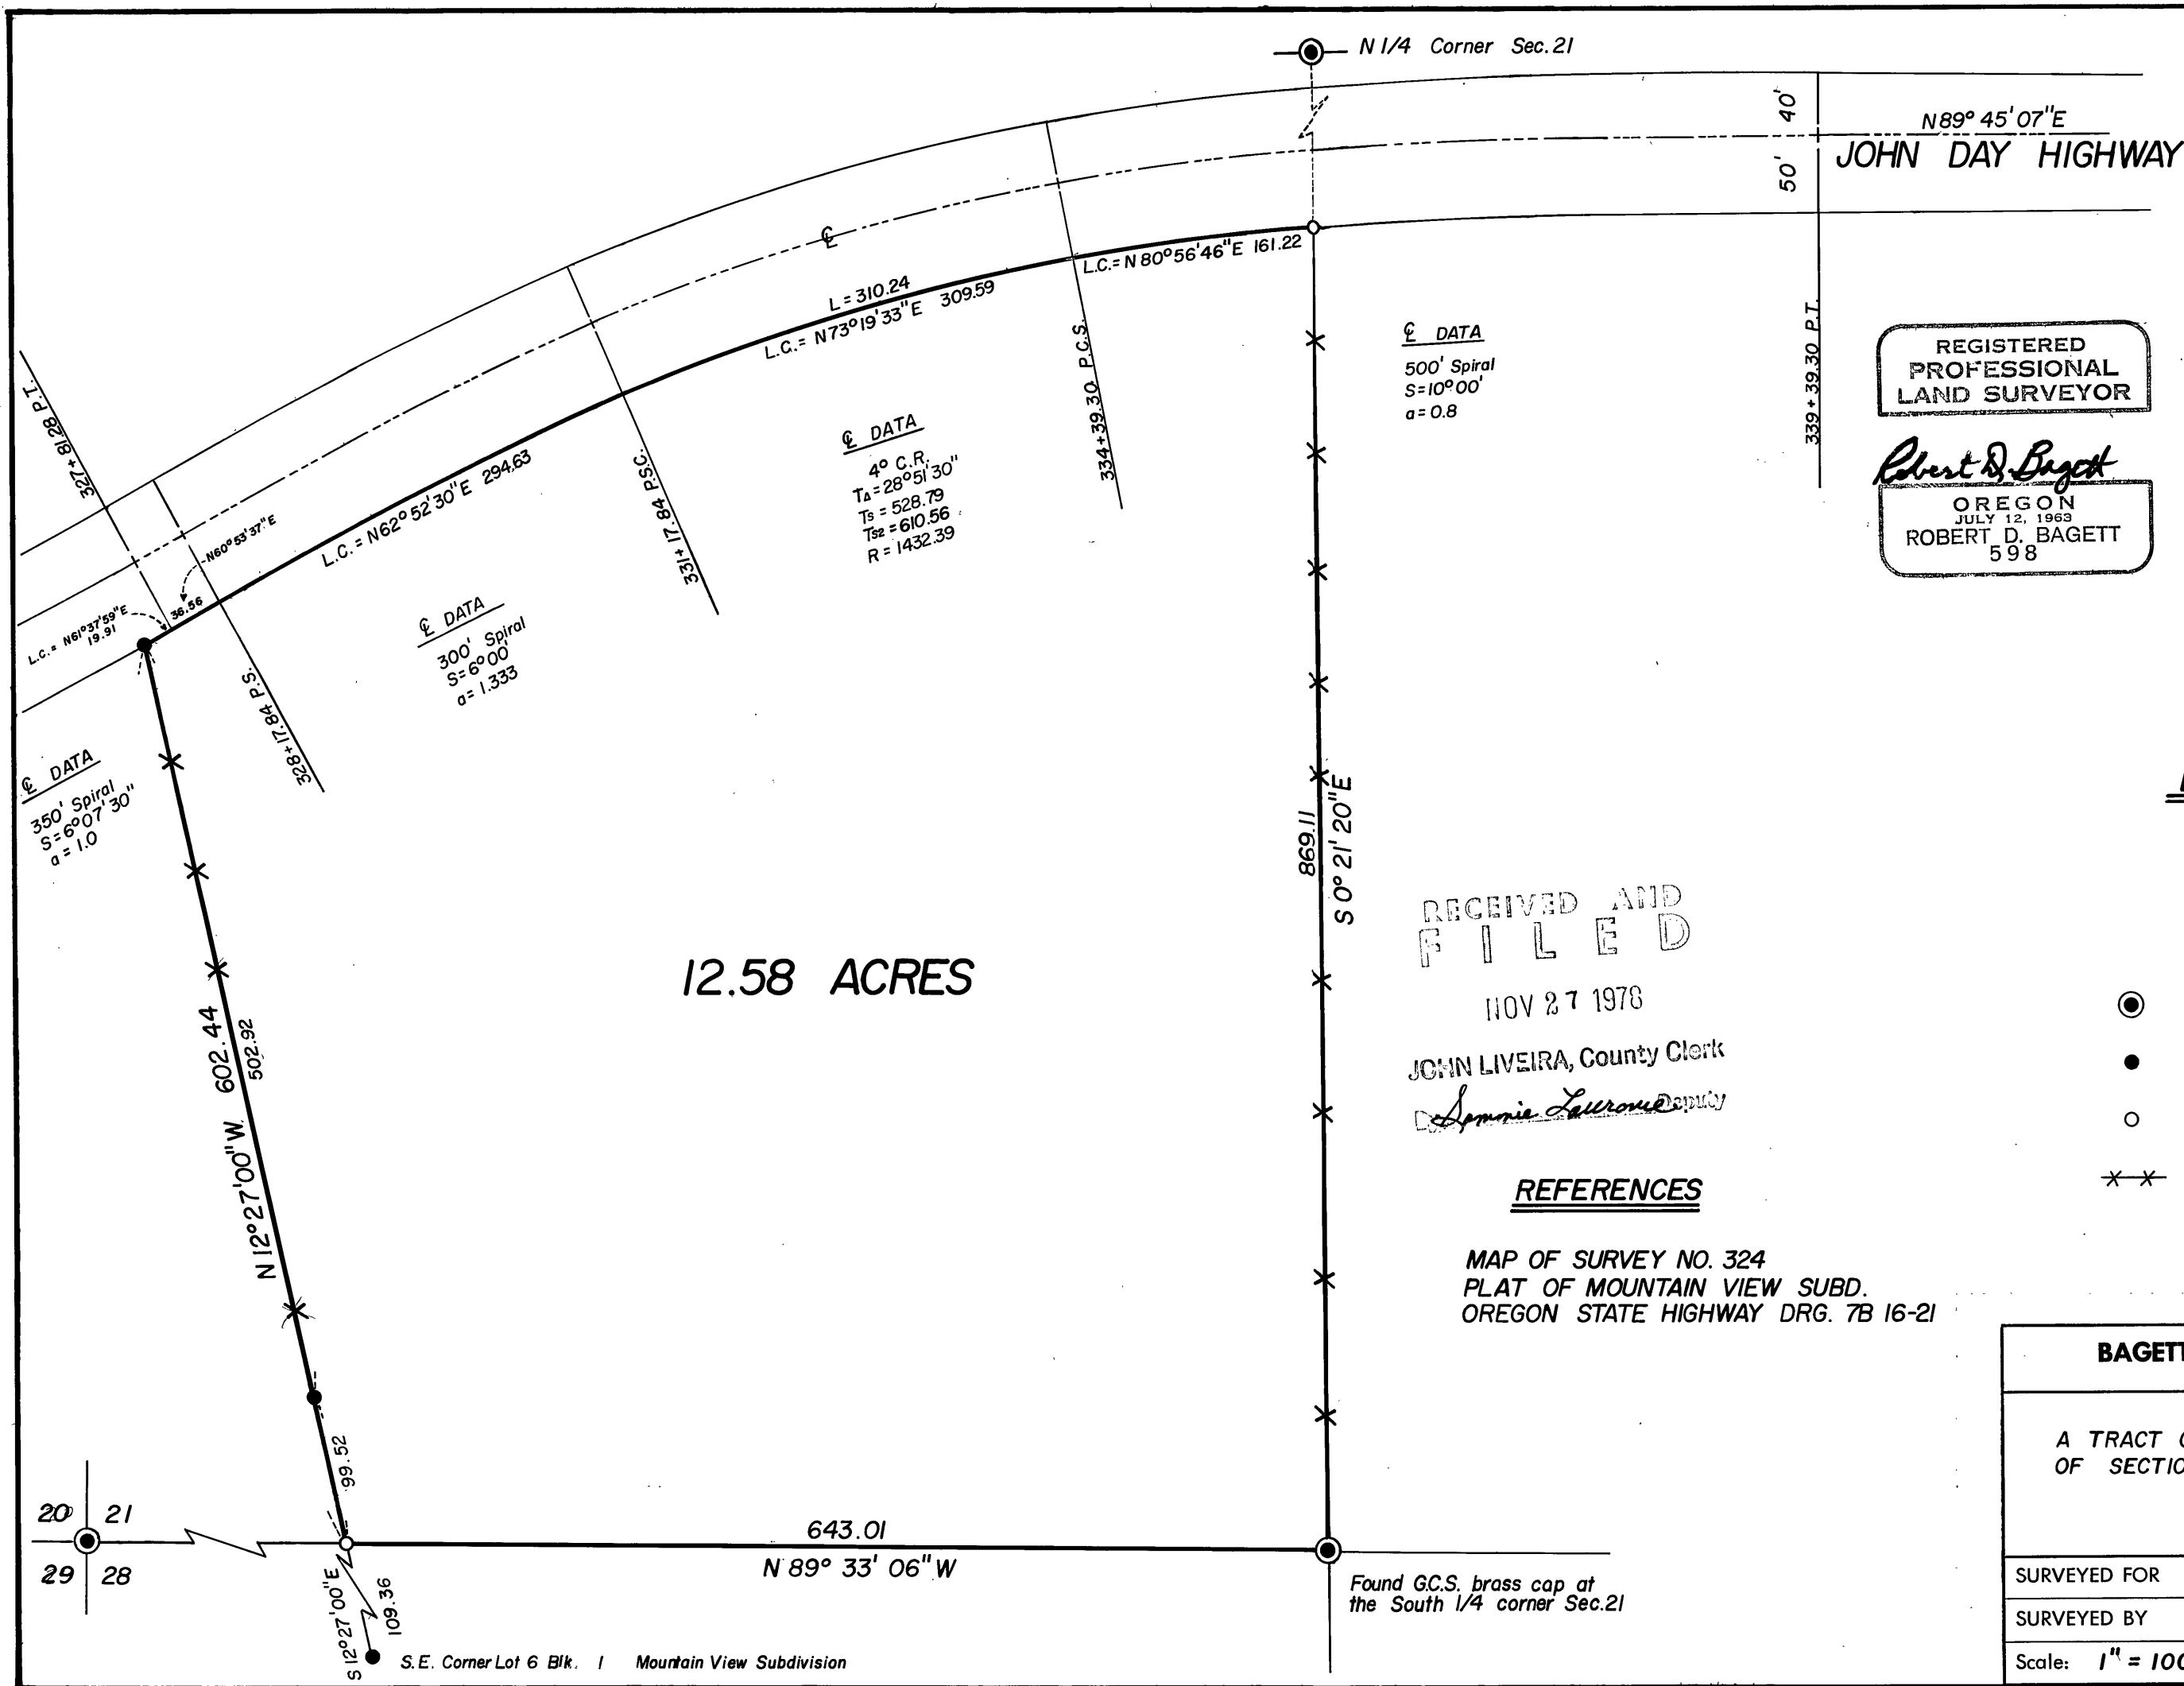

REGISTERED
PROFESSIONAL
LAND SURVEYOR

Robert D. Bagett

OREGON
JULY 12, 1963
ROBERT D. BAGETT
598

BASIS OF BEARINGS
SOLAR OBSERVATION

LEGEND

- Found GRANT CO. SURVEYOR brass cap.
- Found mon. of record, Mountain View Subdivision, Tract A.
- Set 5/8" X 30" iron pin.
- ✕✕ Fence

RECEIVED AND
FILED

NOV 27 1978

JOHN LIVEIRA, County Clerk
Ann Marie Lawrence

REFERENCES

MAP OF SURVEY NO. 324
PLAT OF MOUNTAIN VIEW SUBD.
OREGON STATE HIGHWAY DRG. 7B 16-21

BAGETT, GRIFFITH & ASSOCIATES

John Day, Oregon
Map of Survey

A TRACT OF LAND IN THE SE 1/4 SW 1/4
OF SECTION 21, T.13 S., R.31 E., W.M.

GRANT COUNTY, OREGON

SURVEYED FOR	DUANE CHEADLE	
SURVEYED BY	R.D.B. & S.F.J.	10/78
Scale: 1" = 100'	Drawn by: S.F.J.	10/78