


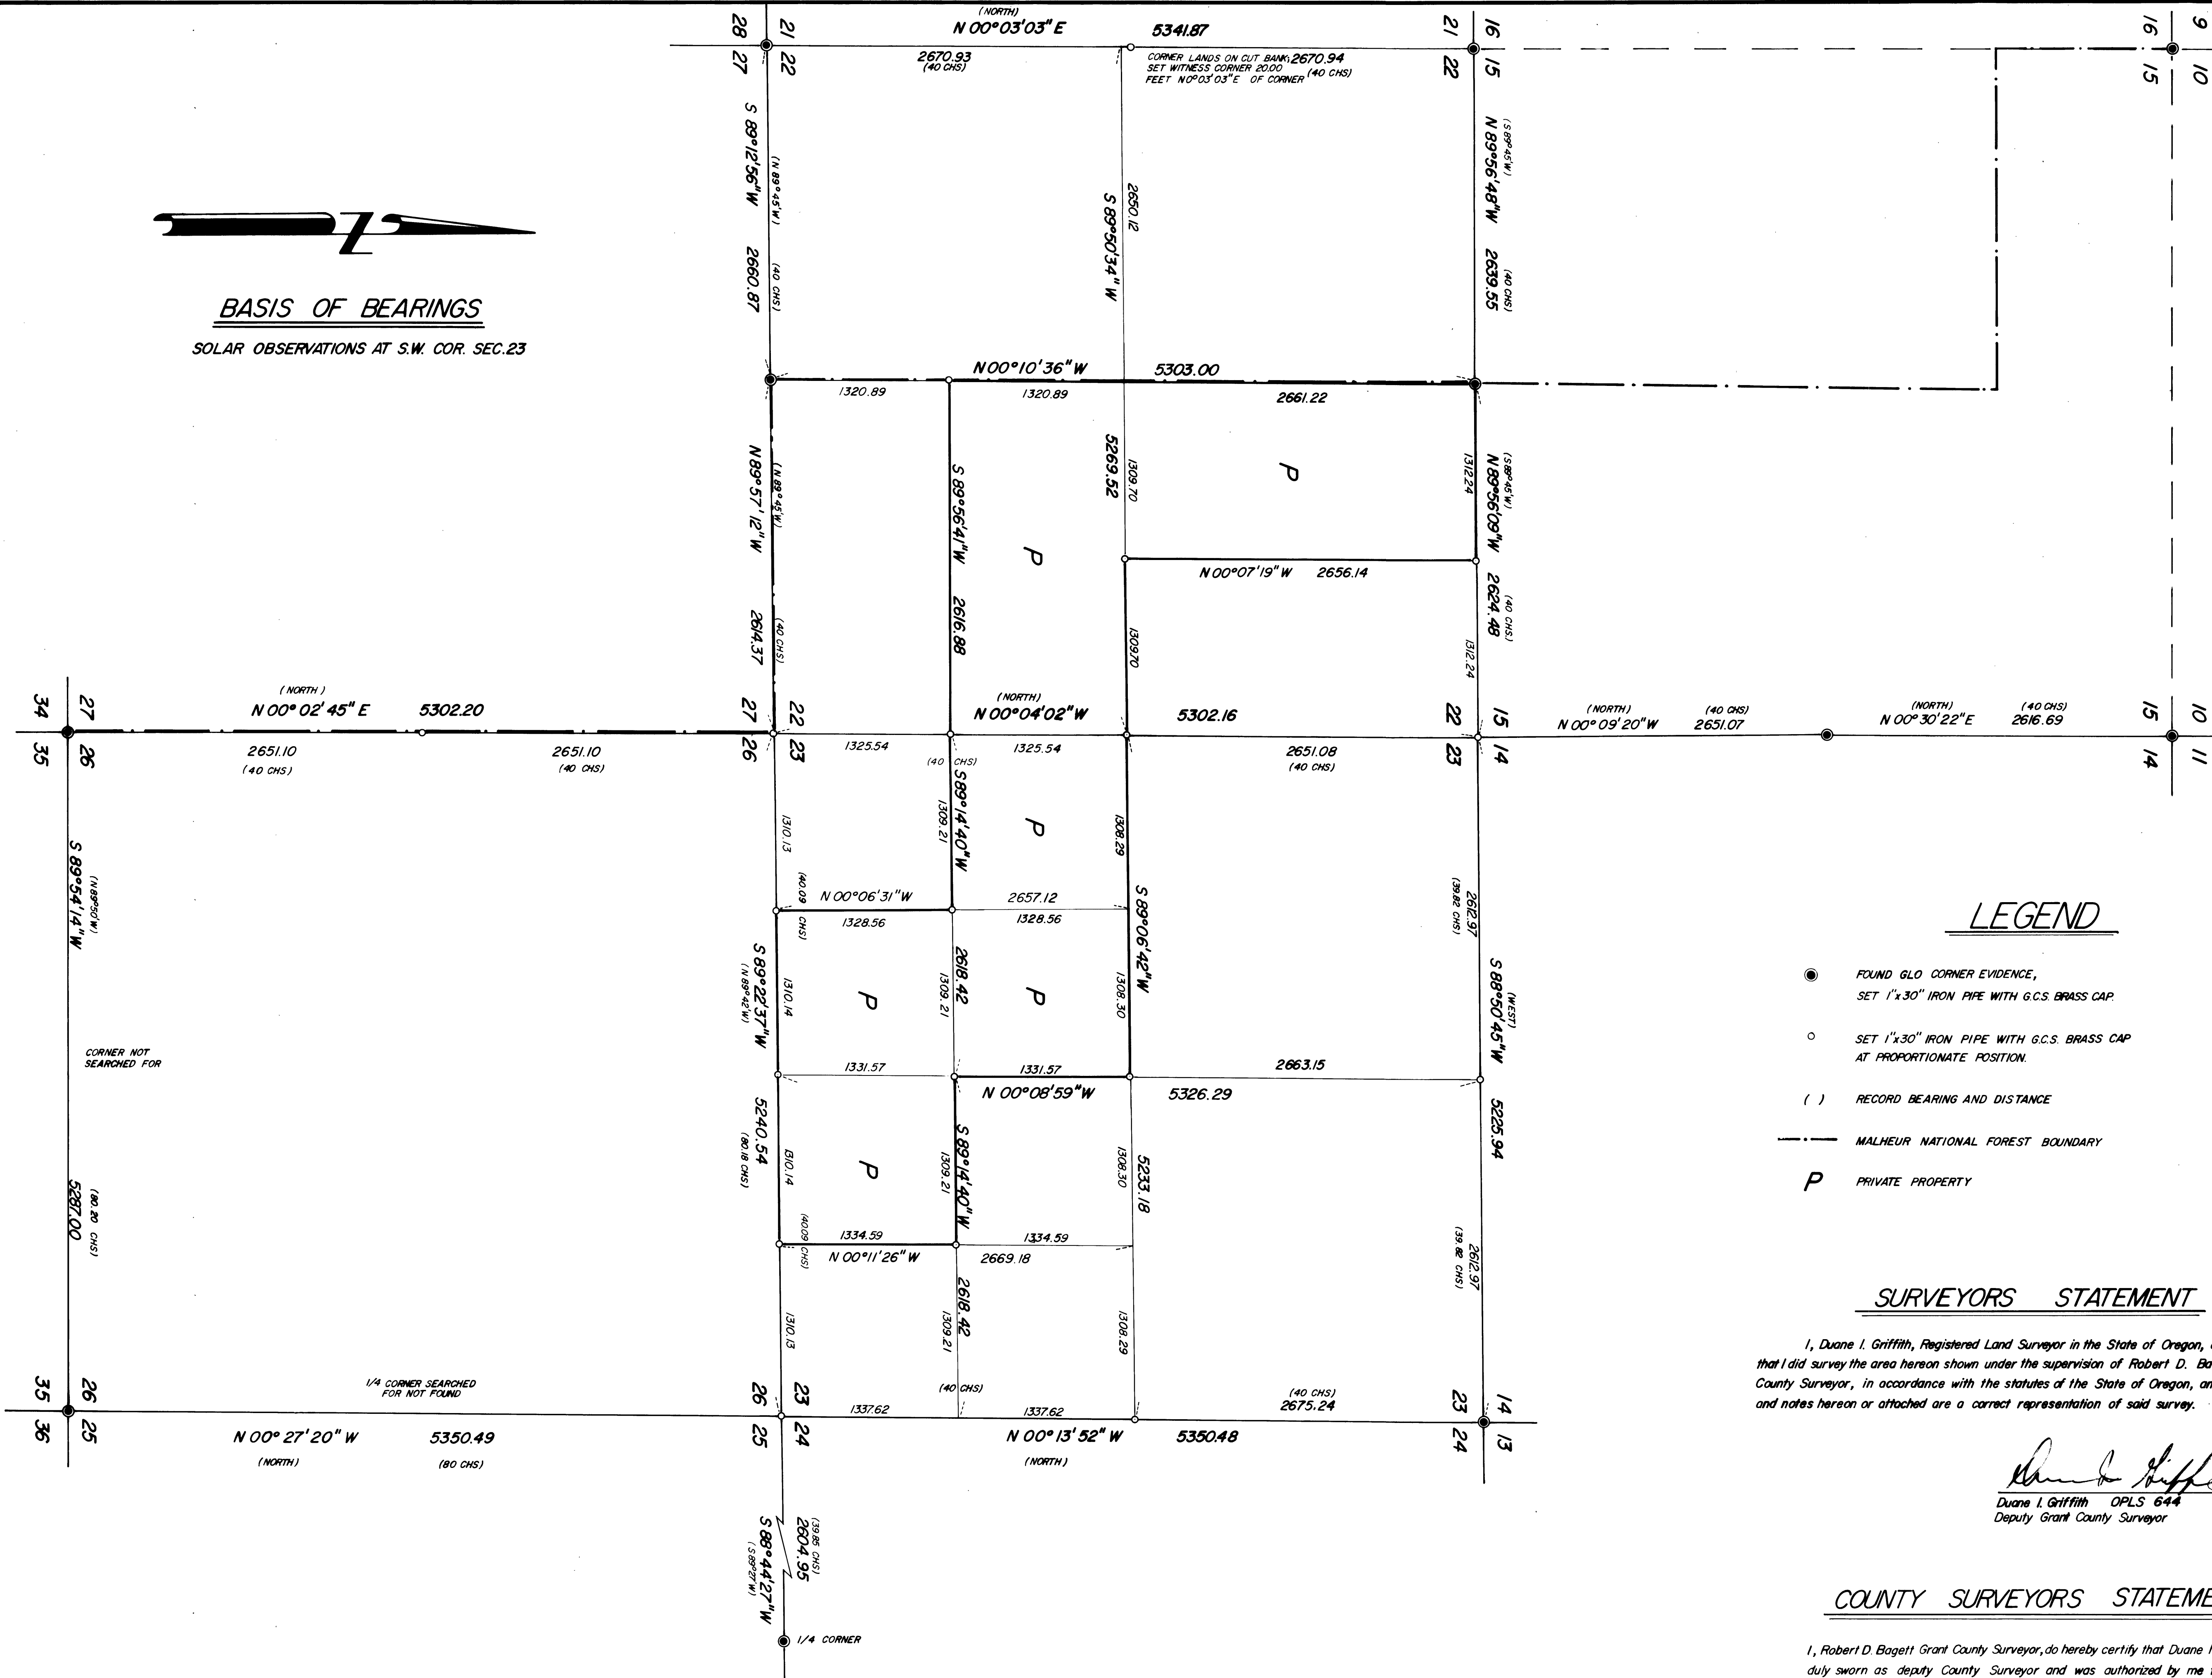

BASIS OF BEARINGS

SOLAR OBSERVATIONS AT S.W. COR. SEC. 23

NOTE
SEE CERTIFIED RECORD OF LAND
CORNER MONUMENTATION SHEETS
RECORDED WITH THIS PLAT FOR
A DESCRIPTION OF EACH MONUMENT
SET AND NEW BEARING TREES TAKEN.



LEGEND

- FOUND GLO. CORNER EVIDENCE,
SET 1"x30" IRON PIPE WITH G.C.S. BRASS CAP.
- SET 1"x30" IRON PIPE WITH G.C.S. BRASS CAP
AT PROPORTIONATE POSITION.
- () RECORD BEARING AND DISTANCE
- MALHEUR NATIONAL FOREST BOUNDARY
- P PRIVATE PROPERTY

SURVEYORS STATEMENT

I, Duane I. Griffith, Registered Land Surveyor in the State of Oregon, do hereby certify that I did survey the area hereon shown under the supervision of Robert D. Baggett, the Grant County Surveyor, in accordance with the statutes of the State of Oregon, and that this plat and notes hereon or attached are a correct representation of said survey.

Duane I. Griffith
Duane I. Griffith OPLS 644
Deputy Grant County Surveyor

COUNTY SURVEYORS STATEMENT

I, Robert D. Baggett Grant County Surveyor, do hereby certify that Duane I. Griffith was duly sworn as deputy County Surveyor and was authorized by me to execute this survey in behalf of the Grant County Surveyor; I also certify that Duane I. Griffith executed said survey under my direction and supervision.

Robert D. Baggett
Robert D. Baggett OPLS 598
Grant County Surveyor
Nov 20, 1978

RECEIVED AND
FILED
DEC 21 1978
JOHN D. BERRY, County Clerk
John D. Berry

REGISTERED
PROFESSIONAL
LAND SURVEYOR
Duane I. Griffith
OREGON
JULY 10, 1964
DUANE I. GRIFFITH
644

BAGETT, GRIFFITH & ASSOCIATES		
John Day, Oregon Map of Survey		
PRIVATE PROPERTY IN SECTIONS 22 and 23 T12S, R34E, W.M. GRANT COUNTY, OREGON		
SURVEYED FOR	MALHEUR NATIONAL FOREST	
SURVEYED BY	DIG	
Scale: 1"=600'	Drawn by: RGR	Sept - Nov, 1978 DEC, 1978