


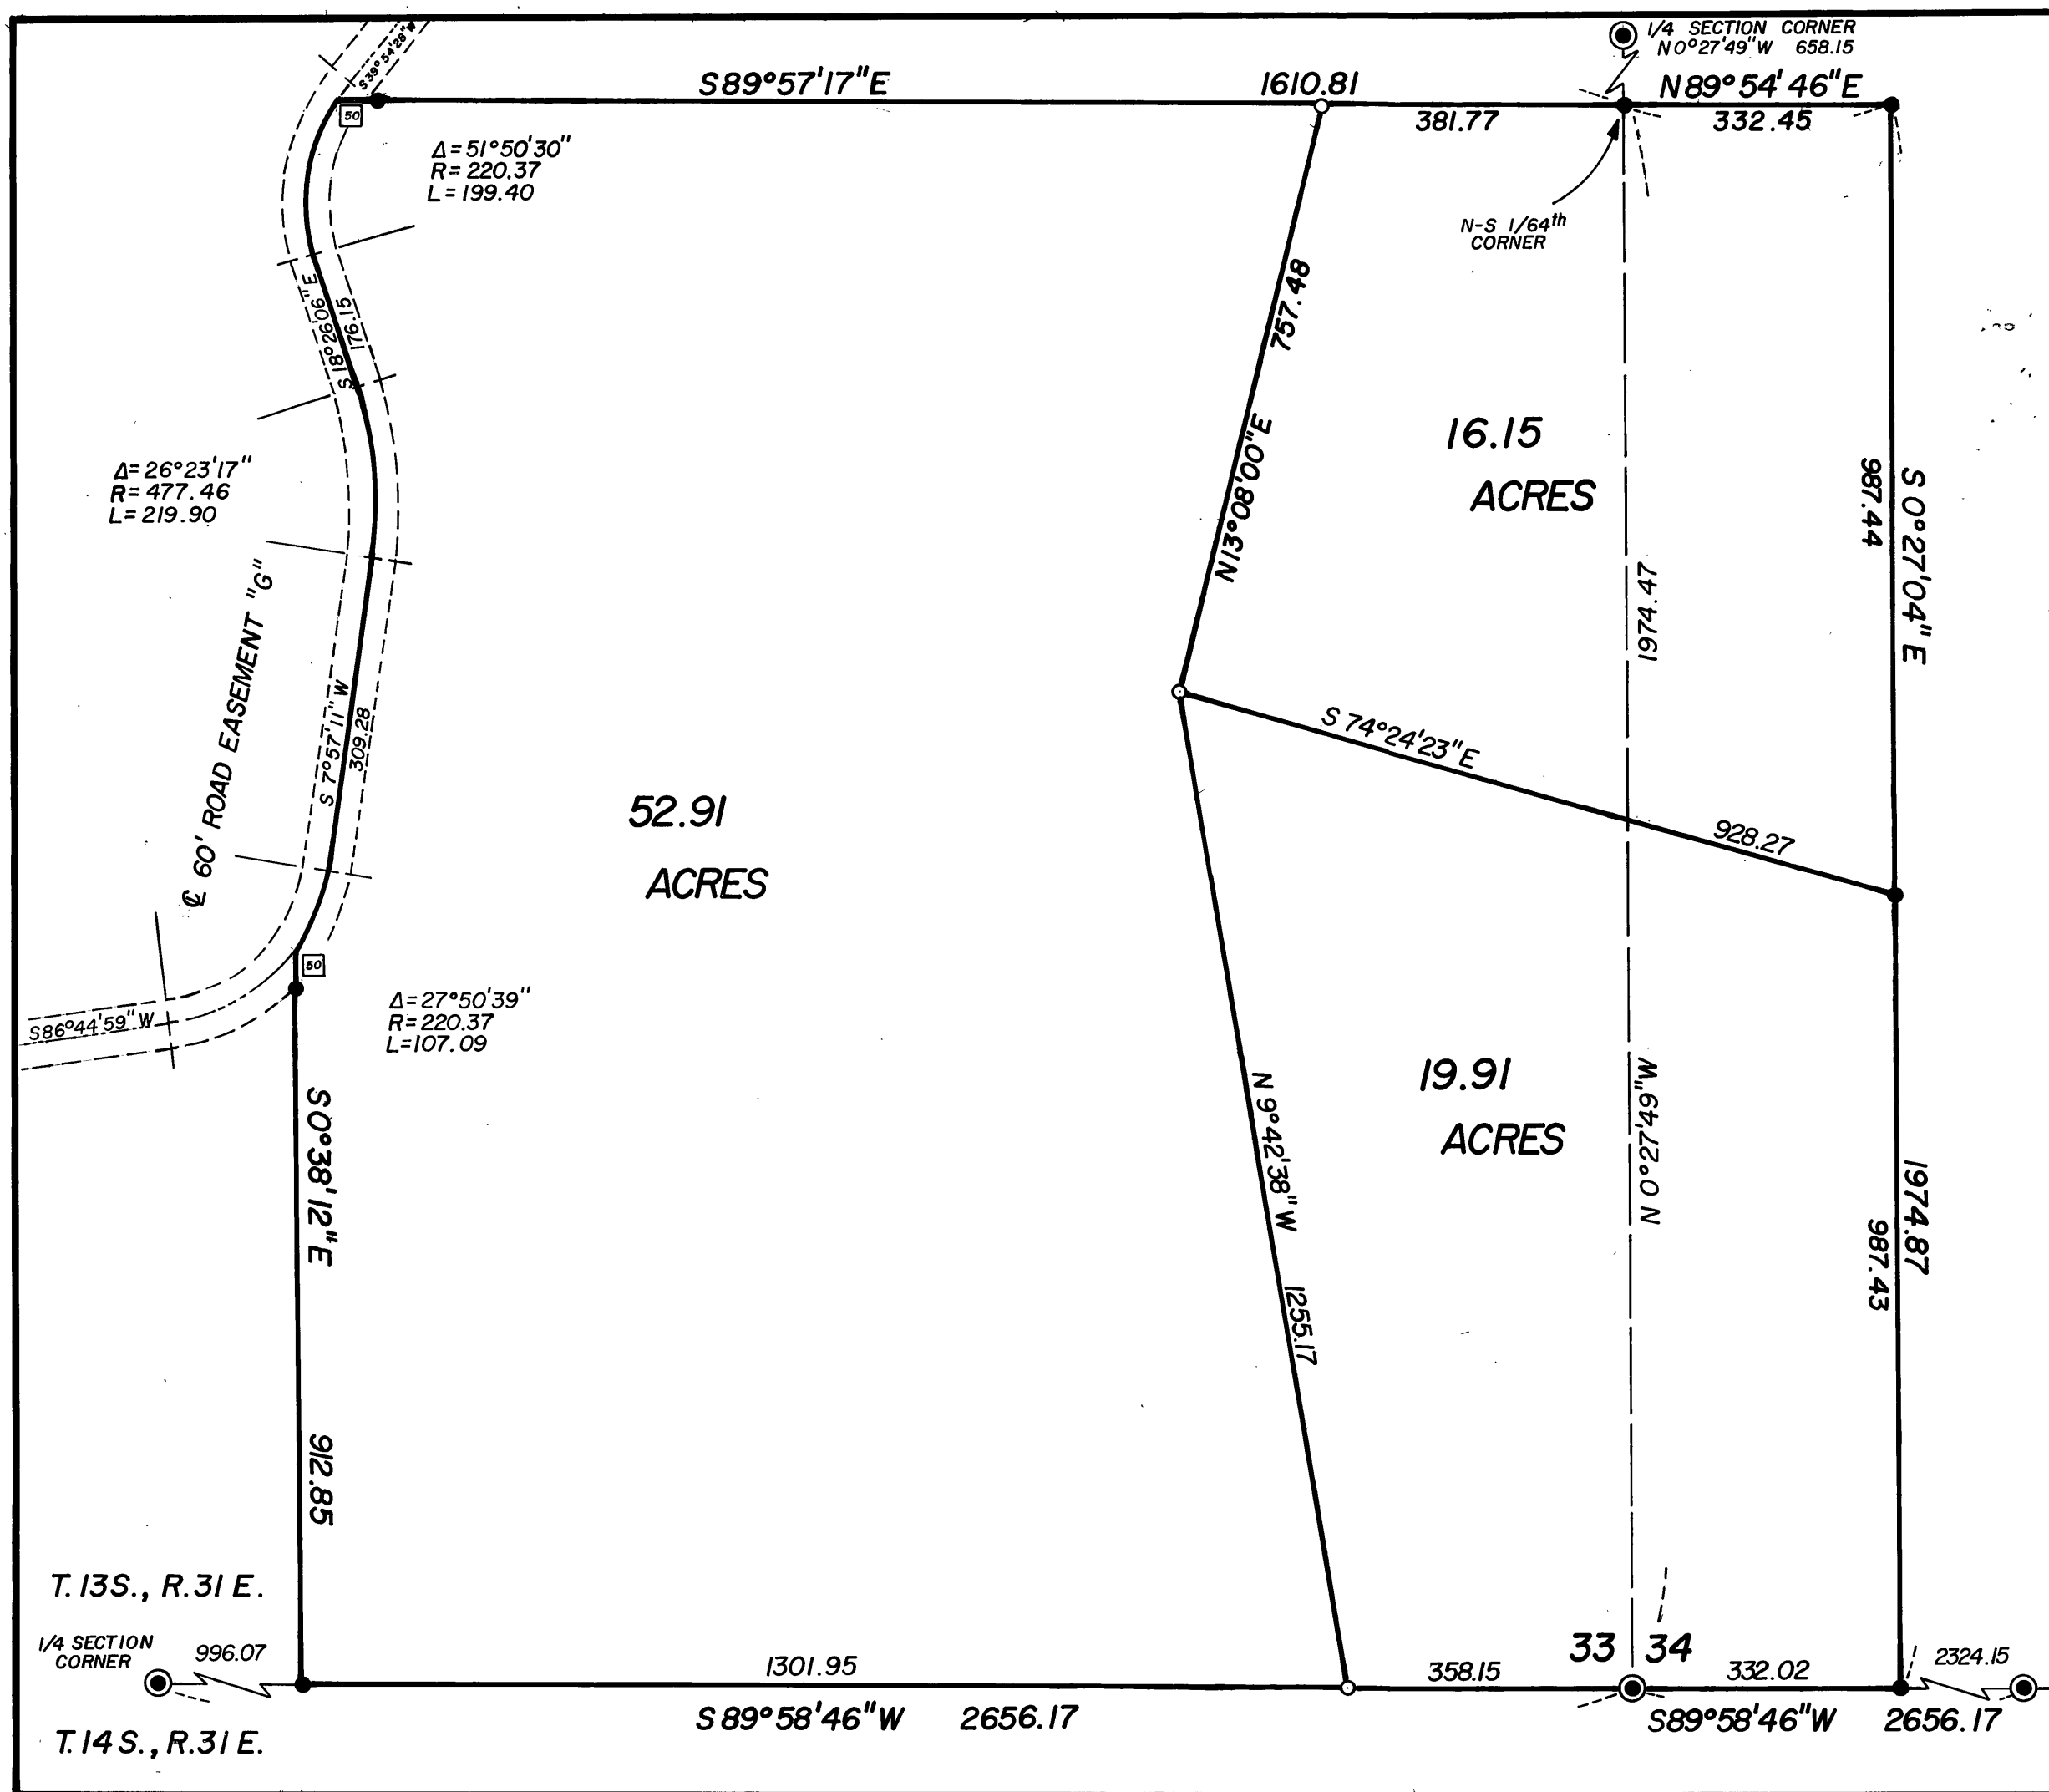

REGISTERED
PROFESSIONAL
LAND SURVEYOR

Robert D. Bagett

OREGON
JULY 12, 1963
ROBERT D. BAGETT
598

BASIS OF BEARINGS
SOLAR OBSERVATION

- LEGEND**
- Found G.C.S. Brass-cap
 - Found 5/8" X 30" IRON PIN
 - Set 5/8" X 30" IRON PIN
 - 50 Offset distance from E road to pin.

REFERENCES

MAP OF SURVEY NO. 324
MAP OF SURVEY NO. 334

NOTE: True dimensions of tracts are shown,
offset distances are not a part of
the true dimensions.

RECEIVED AND
FILED

NOV 27 1978

JOHN LIVEIRA, County Clerk
Amnie Leuninger

BAGETT, GRIFFITH & ASSOCIATES
John Day, Oregon

Map of Survey

TRACTS IN THE E 1/2 SE 1/4 SEC 33, AND
THE W 1/2 W 1/2 W 1/2 SW 1/4 SEC 34,
T.13 S., R.31 E., W.M.,
WEST BENCH
GRANT COUNTY, OREGON

SURVEYED FOR	JAMES TATE	
SURVEYED BY	R.D.B. & S.F.J.	10-28-78
Scale: 1" = 200'	Drawn by: S.F.J.	11-02-78