


TOWNSHIP 17 SOUTH, RANGE 32 EAST, W.M.

DEPENDENT RESURVEY

BRIDGE CREEK MEADOW
GRANT COUNTY, OREGON

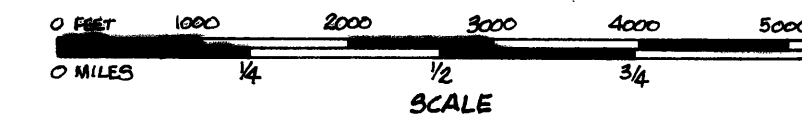

LEGEND

- ◆ ORIGINAL GLO CORNER FOUND
- CORNER ESTABLISHED BY B.L.M.
- ORIGINAL GLO CORNER FOUND AND MONUMENTED
- INTERIOR CORNER ESTABLISHED AND MONUMENTED
- ++++ NAT'L FOREST BOUNDARY POSTED

NOTES:

1. Original Survey performed by Henry W. Cooke, under contract No. 494, dated January 16, 1984. Original distances and bearings are shown in parenthesis.
2. Bearings are based on solar observations.
3. All lands shown as U.S.A. are administered by the U.S. Forest Service.

CERTIFICATION:

I, Charles F. Palmer, Land Surveyor registered in accordance with the Laws of the State of Oregon, do hereby certify that this plat and the notes attached, are a correct representation of a survey I performed during October and November 1978 for Barbara Pons and the U.S. Forest Service in accordance with the statutes of the State of Oregon.

Charles F. Palmer 11/17/78
Charles F. Palmer - Ore. P.L.S. No. 1287

RECEIVED AND
FILED

NOV 21 1978

JOHN LIVEIRA, County Clerk
James Lawrence Deputy

BARBARA PONS / MALHEUR NATIONAL FOREST			
DEPENDENT RESURVEY			
TOWNSHIP 17 SOUTH, RANGE 32 EAST, W.M., GRANT CO., ORE.			
Scale: <i>Noted</i>	Date: <i>November 9, 1978</i>	Job: <i>348/371</i>	
Dwn: -	M. A. Palmer & Sons ENGINEERING & SURVEYING 254 N. Alder - Box 61 Bums, Oregon 97720		Sht. No. of <i>1</i>
Dwn: <i>C.F.P.</i>			
Ckd: <i>M.A.P.</i>			

MAP OF SURVEY NO. 547