


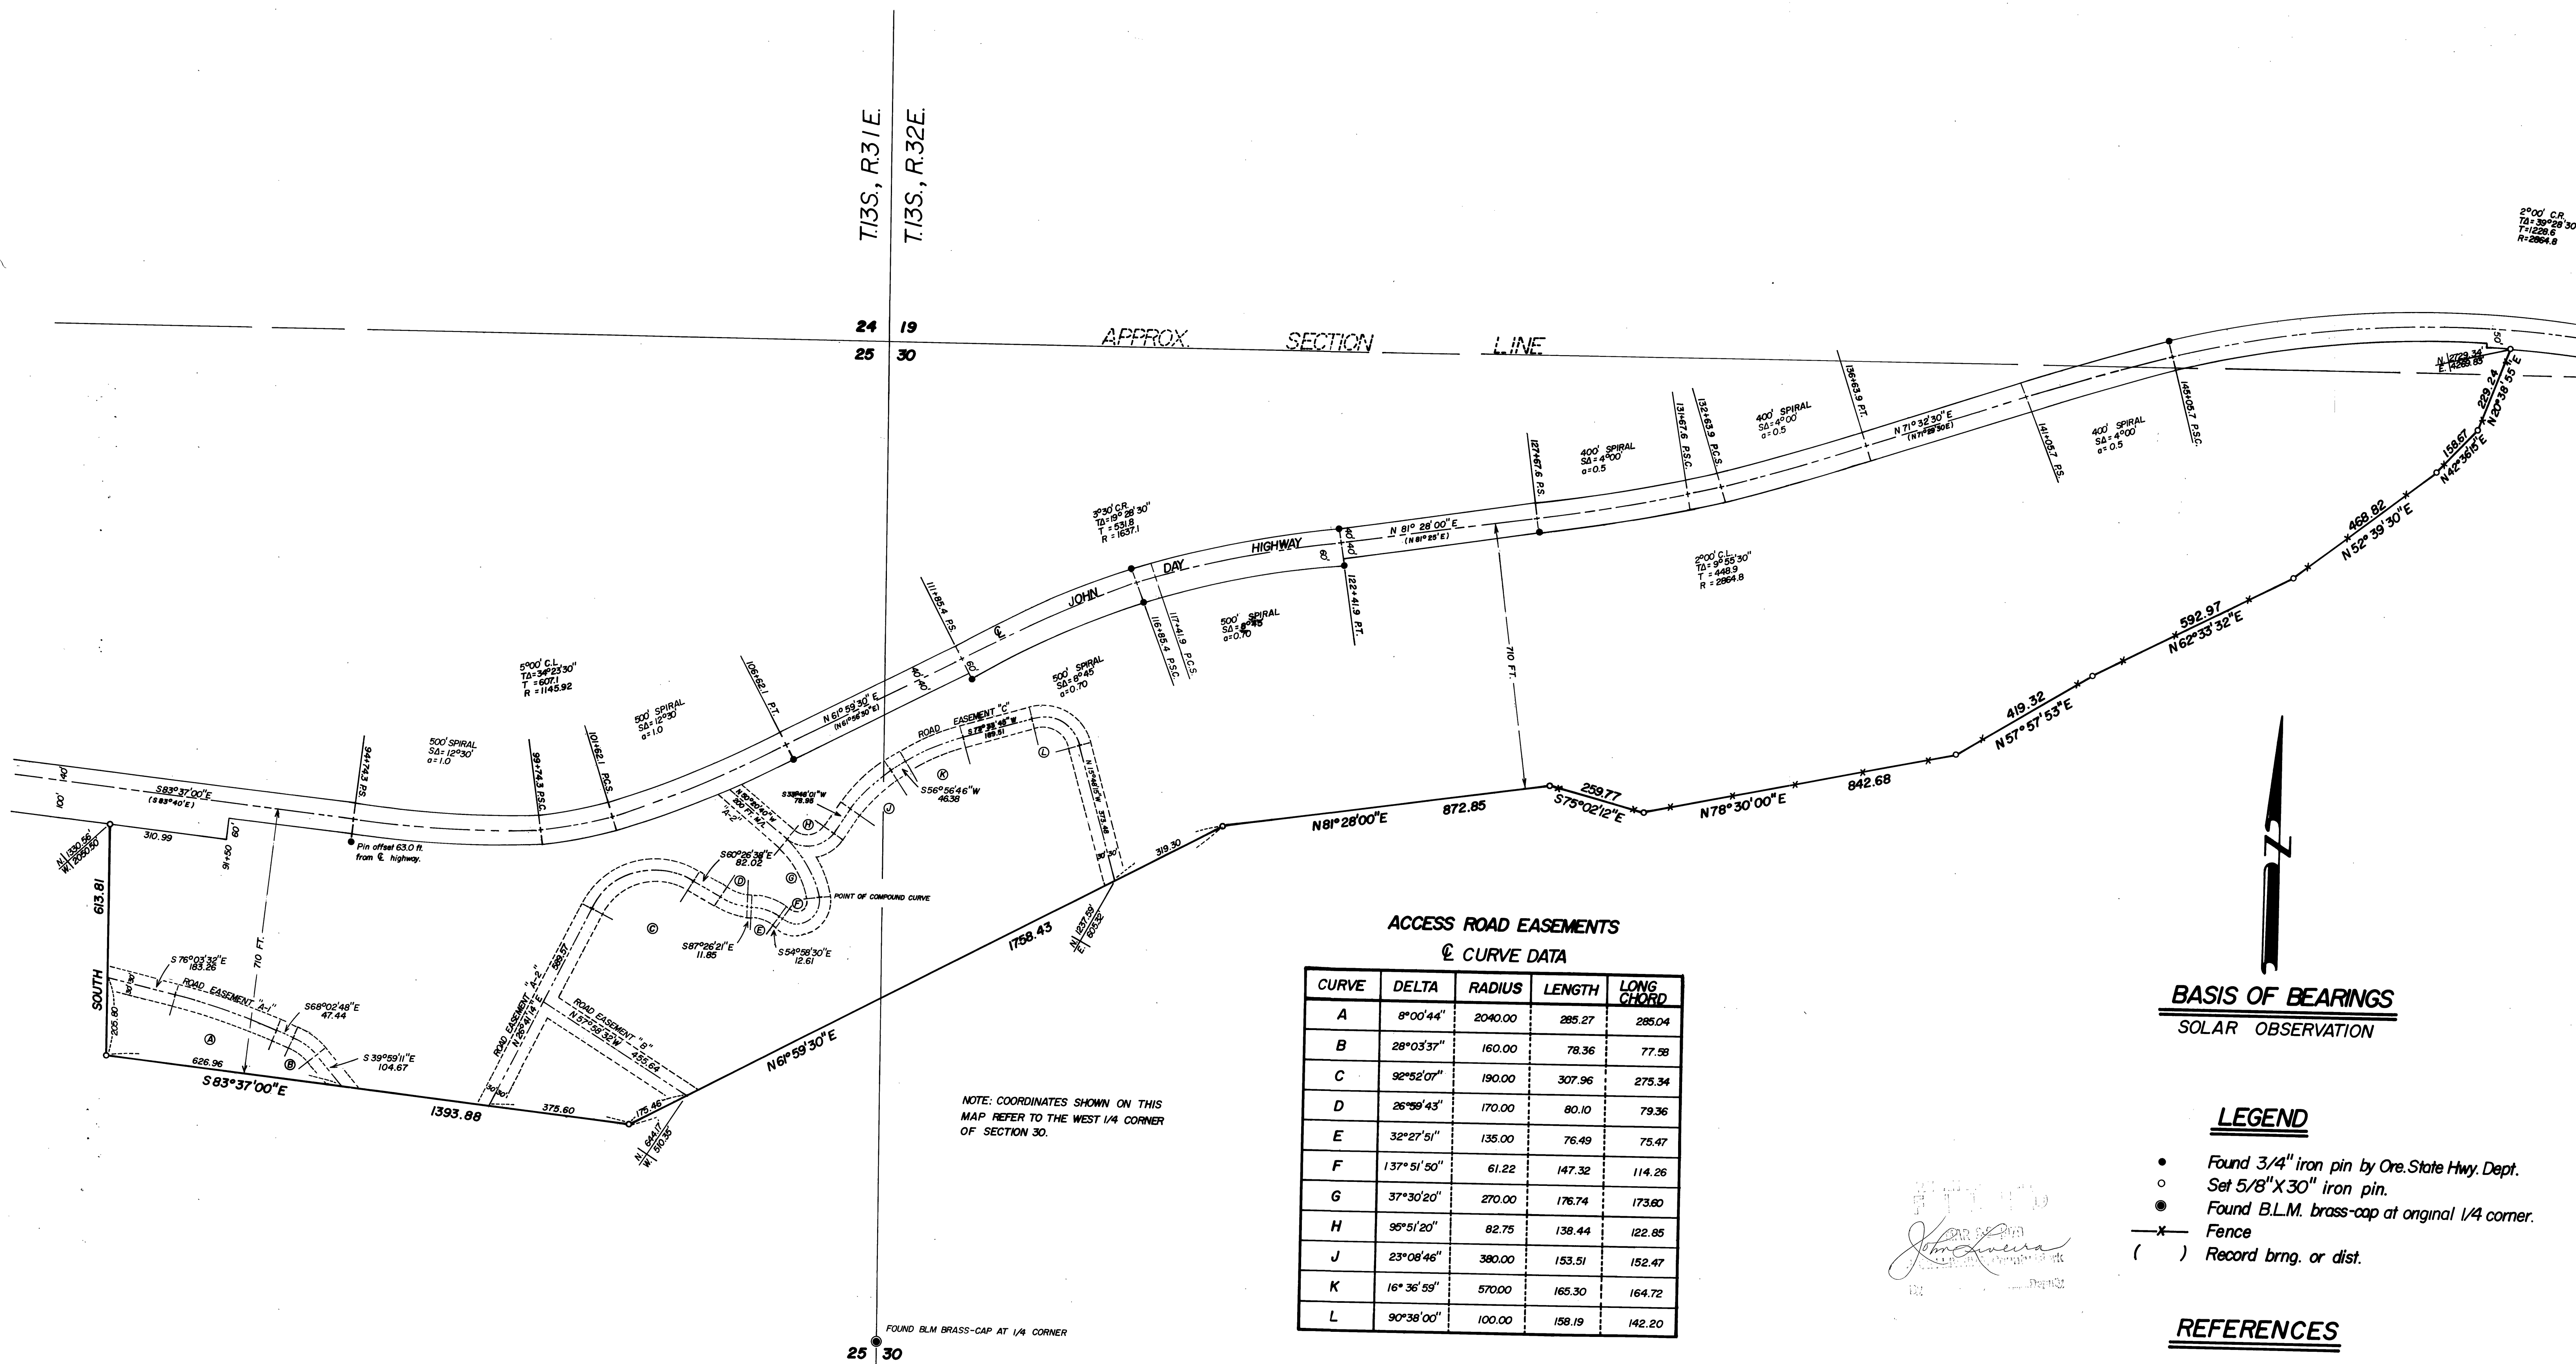

BASIS OF BEARINGS
SOLAR OBSERVATION

LEGEND

- Found 3/4" iron pin by Ore. State Hwy. Dept.
- Set 5/8" X 30" iron pin.
- Found B.L.M. brass-cap at original 1/4 corner.
- Fence
- Record brng. or dist.

REFERENCES

OREGON STATE HWY. DEPT. DRG. 5B-11-10

REGISTERED
PROFESSIONAL
LAND SURVEYOR

Robert D. Baggett
JULY 1, 1989
558

BAGETT, GRIFFITH & ASSOCIATES John Day, Oregon		
A TRACT OF LAND SITUATED IN THE NE 1/4 OF SECTION 25, TWP. 13 S., R. 31 E., W.M., AND IN THE N. 1/2 OF SECTION 30, AND THE S.E. 1/4 OF SECTION 19, TWP. 13 S., R. 32 E., W.M., GRANT COUNTY, OREGON		
SURVEYED FOR	HAY TIMBER	
SURVEYED BY	R.D.B. & S.F.J.	MARCH, 1979
Scale: 1" = 200'	Drawn by: S.F.J.	MARCH, 1979