


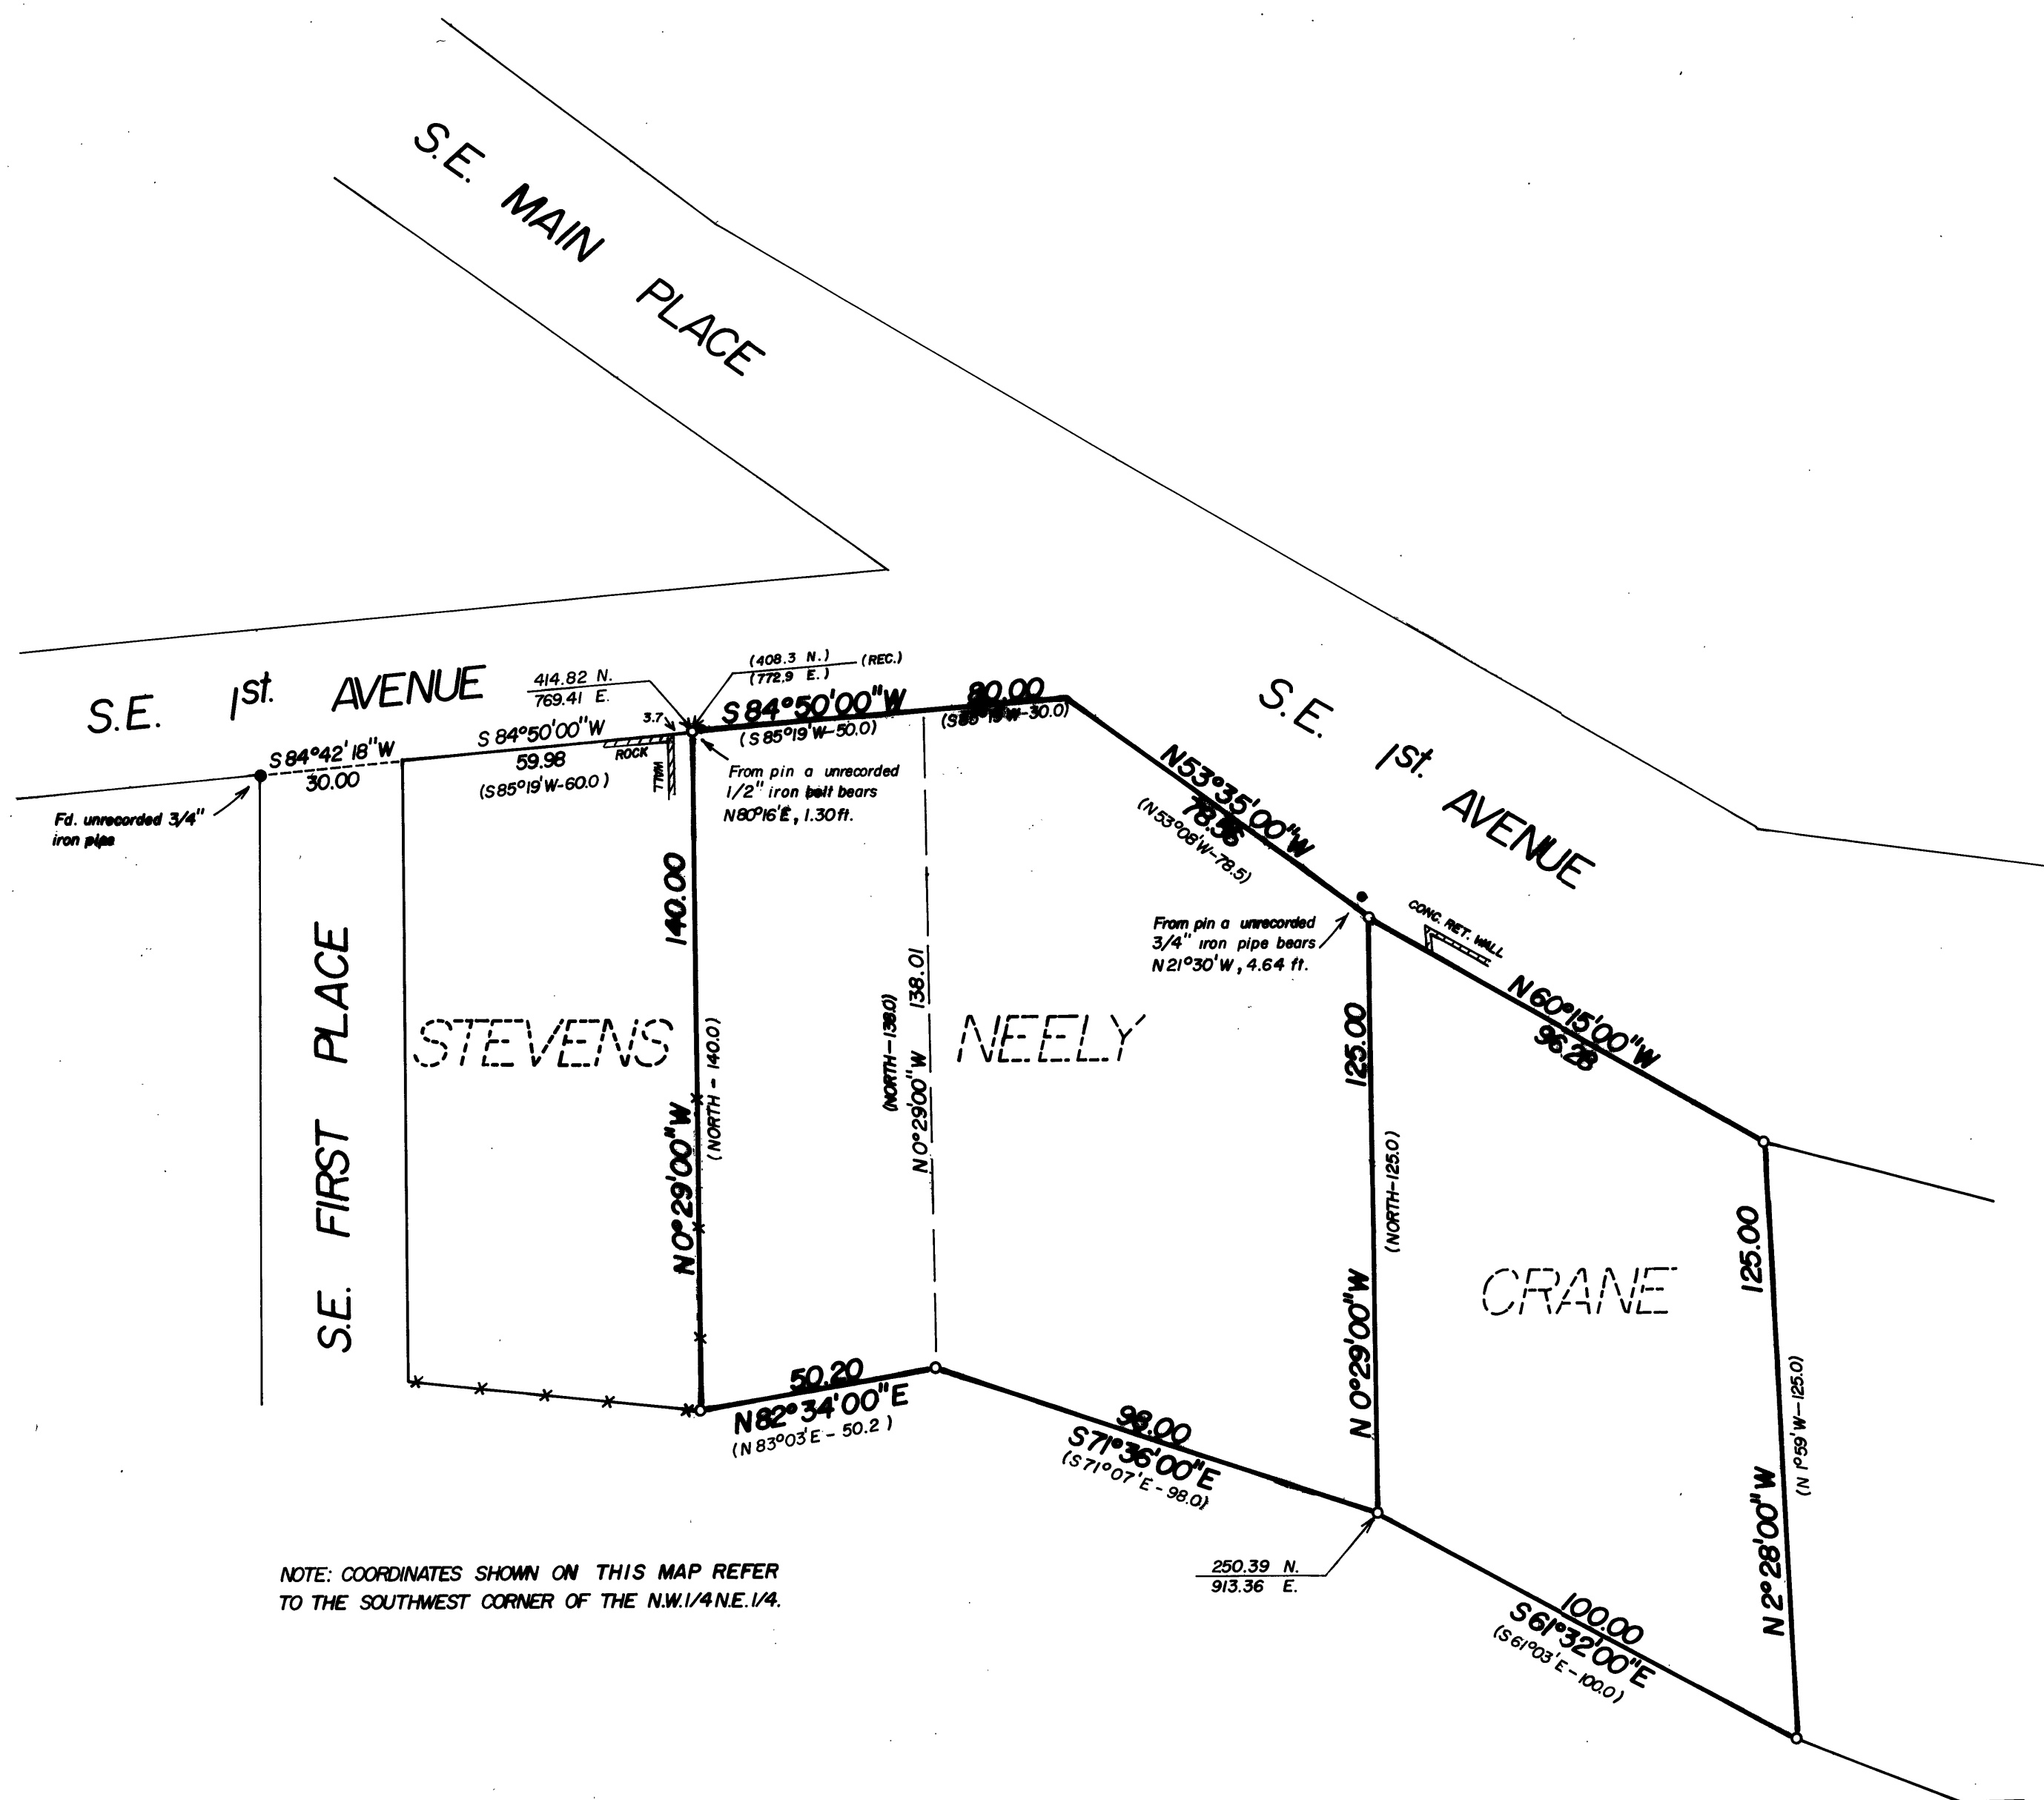

BASIS OF BEARINGS
SOLAR OBSERVATION

LEGEND

- FOUND UNRECORDED PIPE OR BOLT.
- SET 5/8" IRON PIN.
- X-X- FENCE
- () RECORD BEARING & DISTANCE.

RECEIVED AND
FILED

MAR 28 1979
JOHN LIVEIRA, County Clerk
Deputy

REGISTERED
PROFESSIONAL
LAND SURVEYOR

Robert D. Baggett
OREGON
JULY 12, 1965
ROBERT D. BAGGETT
558

BAGETT, GRIFFITH & ASSOCIATES John Day, Oregon Map of Survey		
PARCELS IN THE NW 1/4 N.E. 1/4 OF SEC. 26 T.13S., R.31E., W.M., AND IN THE CITY OF JOHN DAY, GRANT COUNTY, OREGON.		
GRANT COUNTY, OREGON		
SURVEYED FOR	JIM NEELY & STEVE CRANE	
SURVEYED BY	R.D.B. & S.F.J.	March, 1979
Scale: 1" = 30'	Drawn by: S.F.J.	March, 1979