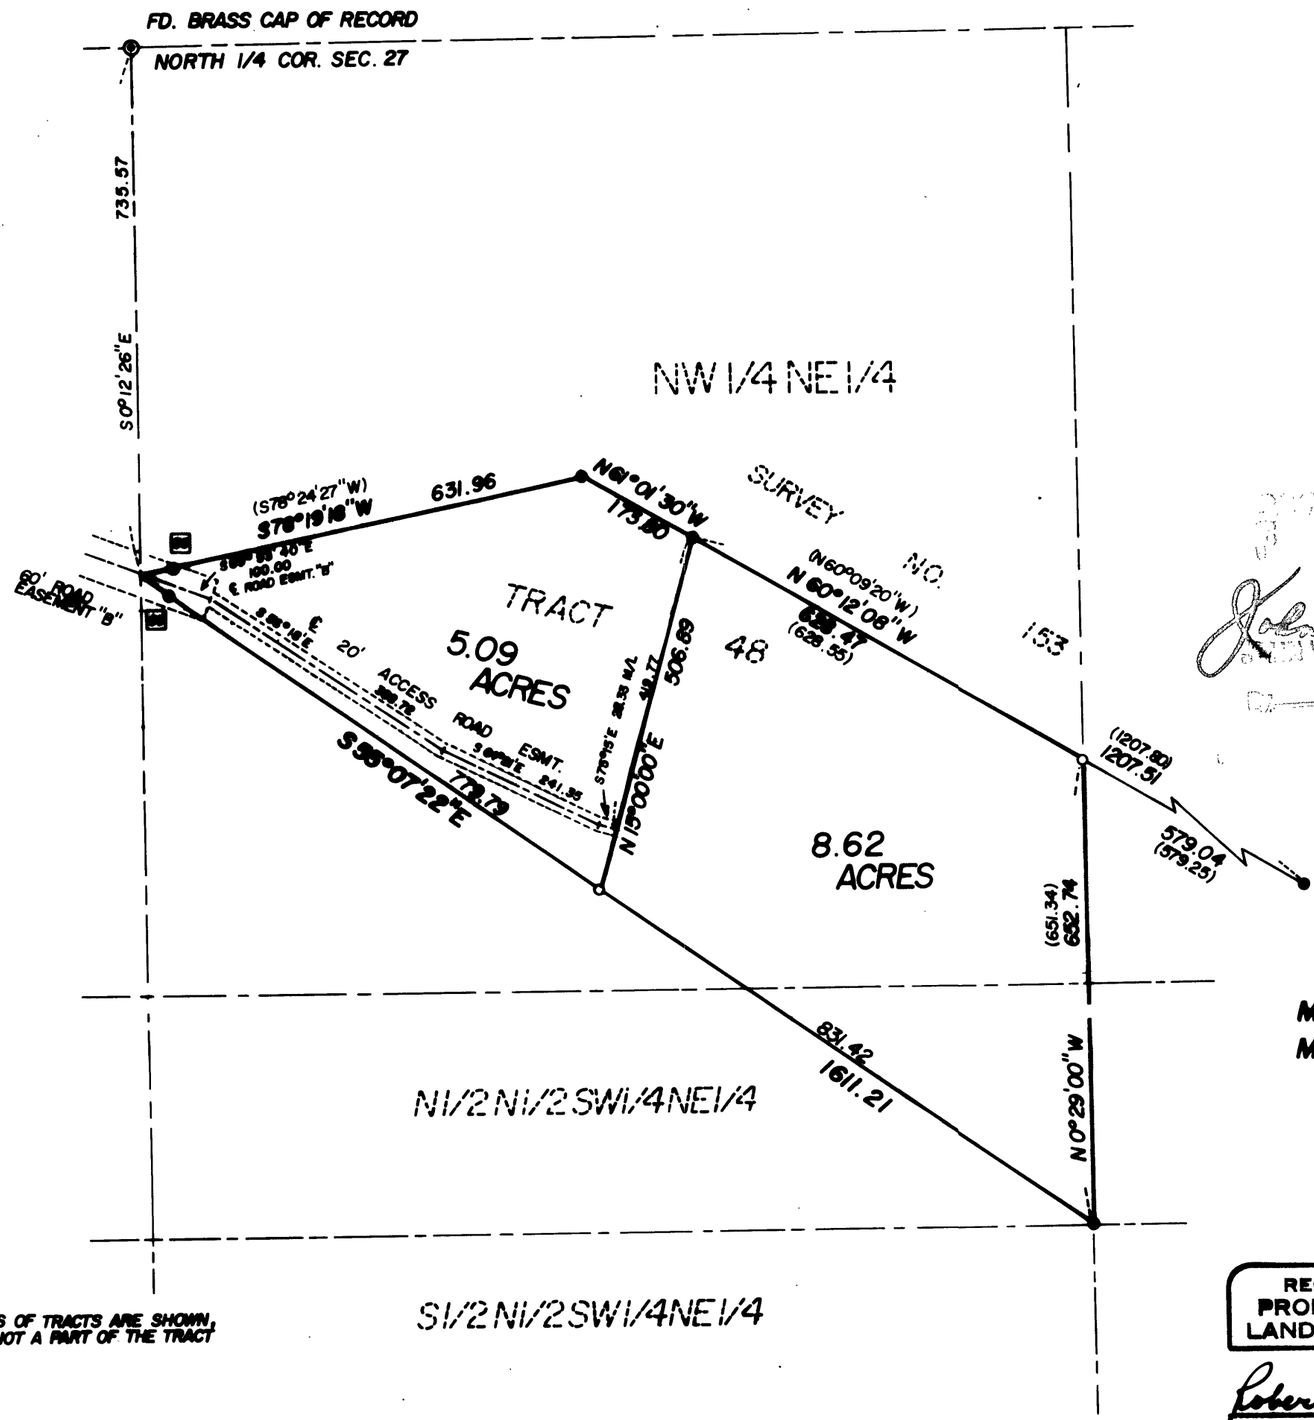

NOTE: TRUE DIMENSIONS OF TRACTS ARE SHOWN, OFFSET DISTANCES ARE NOT A PART OF THE TRACT DIMENSIONS.

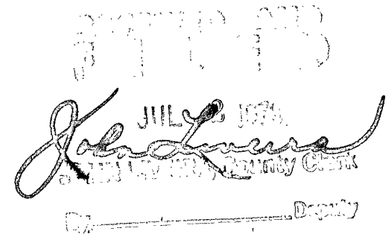

N

BASIS OF BEARINGS
SOLAR OBSERVATION

LEGEND

- ⊙ FOUND BRASS-CAP OF RECORD.
- ● FOUND 5/8" IRON PIN.
- ○ SET 5/8" X 30" IRON PIN.
- [50] OFFSET DIST. ℄ ROAD TO PIN.
- ( ) RECORD BEARING & DISTANCE.

REFERENCES

MAP OF SURVEY NO. 153
MAP OF SURVEY NO. 324

REGISTERED
PROFESSIONAL
LAND SURVEYOR

Robert D. Bagett

OREGON
JULY 12, 1963
ROBERT D. BAGETT
598

BAGETT, GRIFFITH & ASSOCIATES
John Day, Oregon
Map of Survey

DIVISION OF TRACT 48 OF THE WESTERNER LAND PARTITION, SITUATED IN THE NW1/4 NE1/4, AND IN THE SW1/4 NE1/4 OF SEC. 27, T.13S., R.31E., W.M.

GRANT COUNTY, OREGON

SURVEYED FOR	EILEEN SHEEDY	
SURVEYED BY	R.D.B., S.F.J.	MAY , 1974
Scale: 1" = 200'.	Drawn by: S.F.J.	MAY , 1974

MAP OF SURVEY NO. 560