


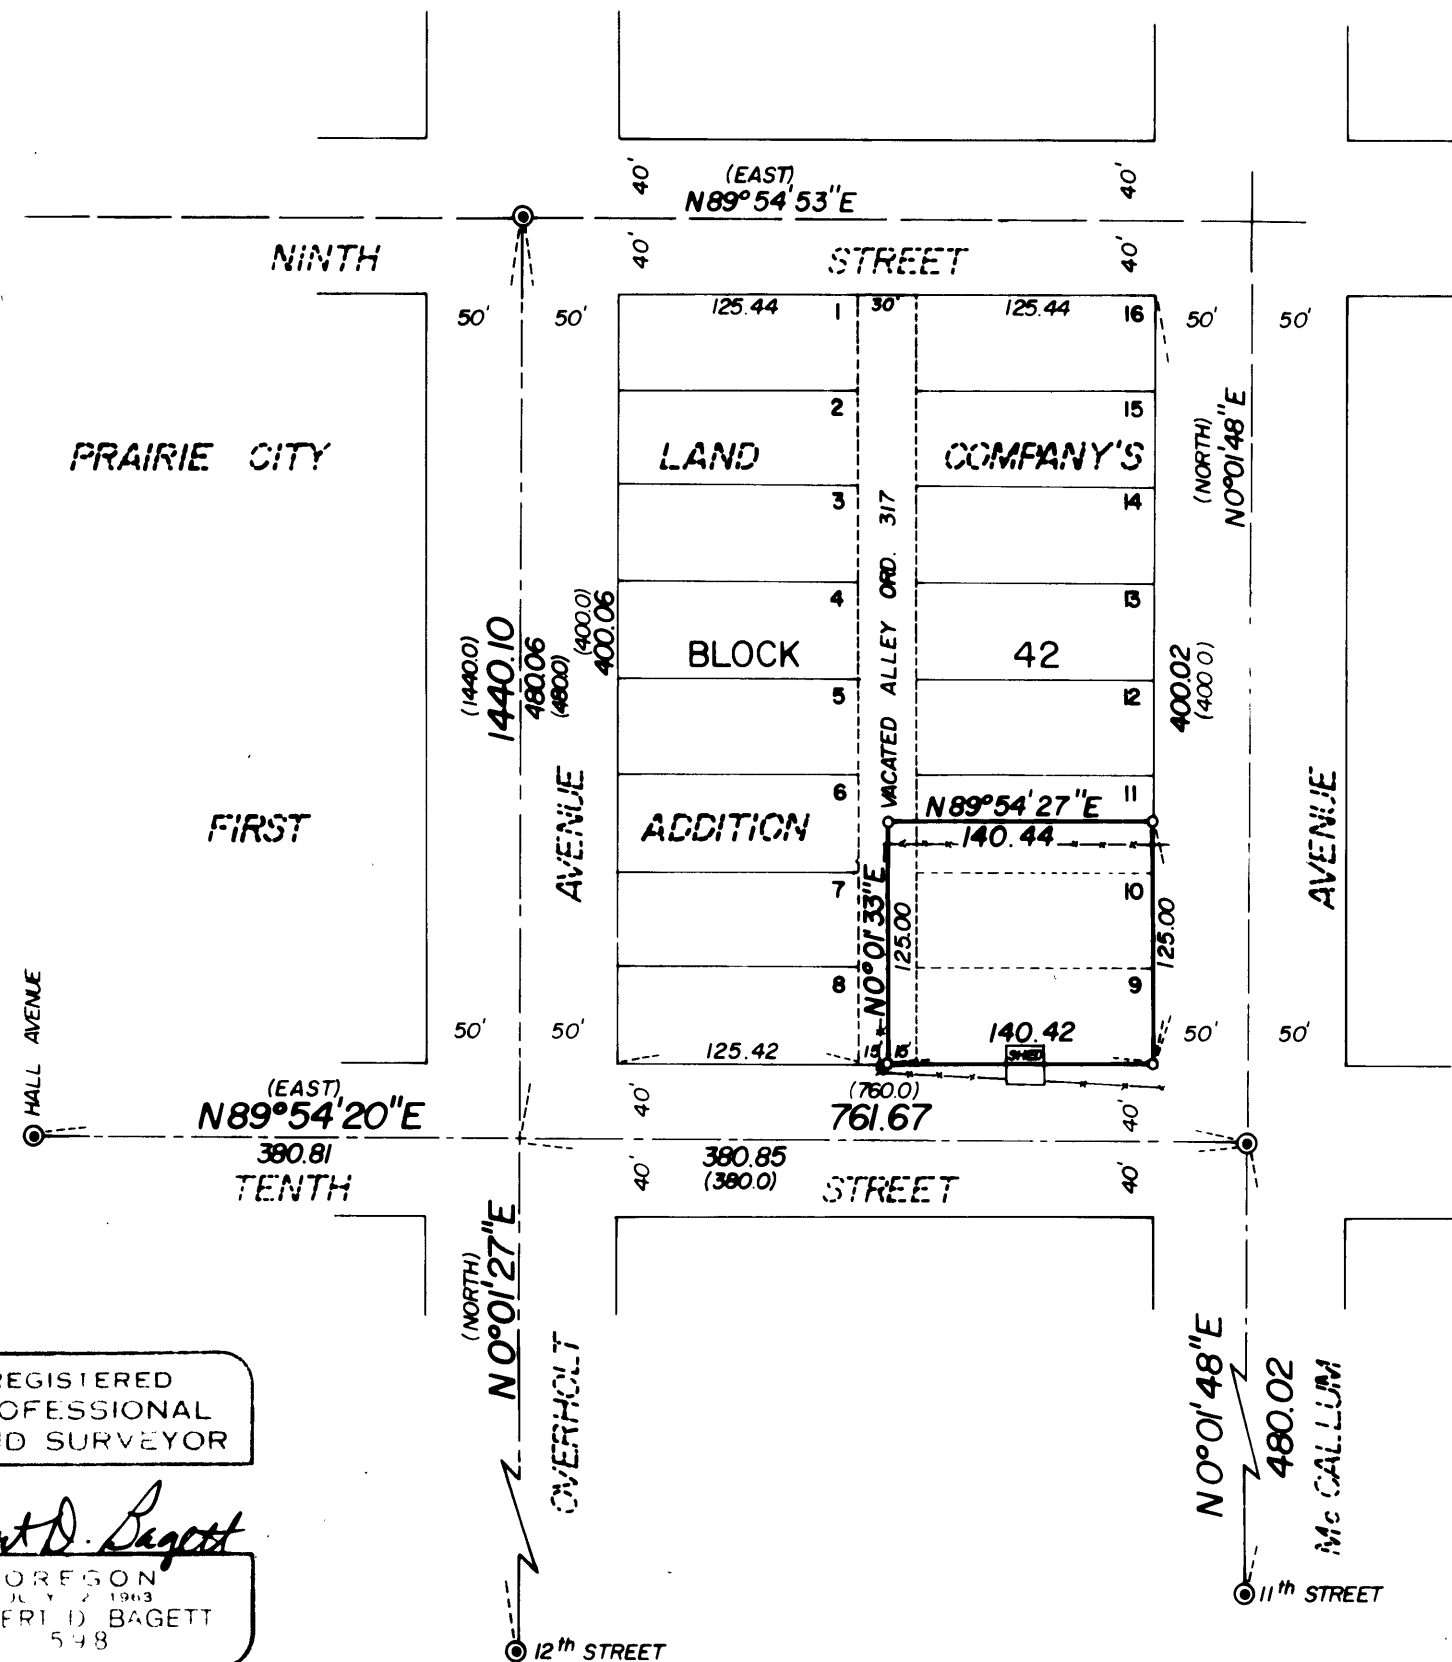

REGISTERED
PROFESSIONAL
LAND SURVEYOR

Robert D. Baggett

OREGON
JULY 2, 1963
ROBERT D. BAGGETT
548

RECEIVED AND
FILED

MAY 18 1979

JOHN LIVEIRA, County Clerk
By *Lennie Laurence*

REFERENCES

MAP OF SURVEY NO. 491.
PLAT OF PRAIRIE CITY LAND
COMPANY'S FIRST ADDITION.



BASIS OF BEARINGS
MAP OF SURVEY NO. 491

LEGEND

- ⊙ FOUND CONCRETE MONUMENT WITH BRASS-CAP AT INTERSECTION OF STREET CENTERLINES.
- SET 5/8" X 30" IRON PIN.
- () RECORD BEARING AND DISTANCE PRAIRIE CITY LAND COMPANY FIRST ADDITION PLAT.
- *- FENCE

BAGETT, GRIFFITH & ASSOCIATES

John Day, Oregon

Map of Survey

LOTS 9, 10 & THE 1/2 LOT 11 BLOCK 42
OF THE PRAIRIE CITY LAND COMPANY'S
FIRST ADDITION TO PRAIRIE CITY.

GRANT COUNTY, OREGON

SURVEYED FOR	JES WOOD	
SURVEYED BY	R.D.B. & S.F.J.	MAY, 1979
Scale: 1" = 100'	Drawn by: S.F.J.	MAY, 1979

MAP OF SURVEY NO. 561