


Found Original Stone,
Set 2-1/2"x30" Iron Pipe
With 2-1/2" Brass Cap
New Bearing Trees
A Pine 20" dia. Bears N85°W, 72.7'
A Fir 16" dia. Bears N13°E, 21.1'
A Fir 7" dia. Bears S71°E, 9.7'
A Pine 26" dia. Bears S15 1/2°W 18.1'

(S 89° 51' W)
S 89° 52' 48" W
2628.02
(2649.24)

T10 S R29 E
S 5
S 8

Found Original Stone
Set 2-1/2"x30" Iron Pipe
With 2-1/2" Brass Cap
New Bearing Trees
A Pine 14" dia. Bears S61°E 41.3'
A Pine 24" dia. Bears N29°E, 18.9'

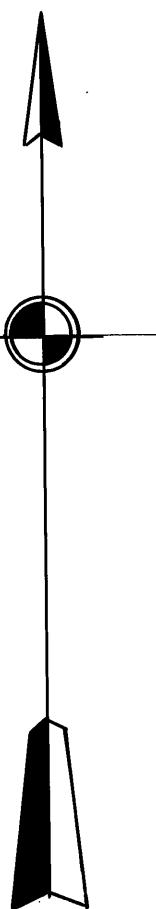

BASIS OF BEARINGS

RECORD BEARING, WEST LINE
SEC. 8, T. 10 S., R. 29 E., W. M.

LEGEND

○ SET 2-1/2"x30" IRON PIPE WITH
2-1/2" BRASS CAP

—— NATIONAL FOREST BOUNDARY
MARKED WITH STEEL POSTS &
BOUNDARY SIGNS

() RECORD BEARING & DISTANCES
FROM ORIGINAL NOTES

NOTE: See Monumentation Sheets
Accompanying This Plat for
Complete Description of
History, Evidence Found,
Monuments Set & Accessory
Material Taken at Each Cor.

Original Evidence Not
Found, At Proportion
Position, Set 2-1/2"x30"
Iron Pipe With 2-1/2"
Brass Cap
New Bearing Trees
A Juniper 20" dia. Bears S24°W 42.8'
A Juniper 30" dia. Bears N86°E 97.0'

T10 S R29 E
S 7
S 8

(N 0° 38' 00" E)
N 0° 38' 00" E
2642.30
(2640.0)

Found Original Stone,
Set 2-1/2"x30" Iron Pipe
With 2-1/2" Brass Cap
New Bearing Trees
A Fir 10" dia. Bears N30°W 30.0'
A Pine 14" dia. Bears S68°E 46.2'
A Pine 6" dia. Bears S5°W 12.0'
A Fir 10" dia. Bears N4°E 35.0'


T10 S R29 E
S 7
S 8
S 18
S 17

RECEIVED AND
FILED

MAY 23 1979

JOHN LIVEIRA, County Clerk
By *Carol Deigt* Deputy

SCALE

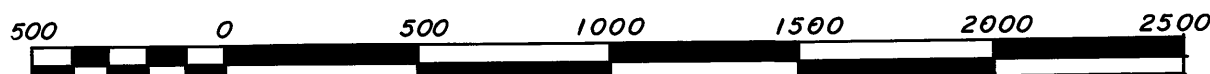

REGISTERED
PROFESSIONAL
LAND SURVEYOR

Douglas M. Ferguson
OREGON
JULY 19, 1969
DOUGLAS M. FERGUSON

OREGON EAST ENGINEERING, INC.

MT. VERNON OR.

Map of Survey
ESTABLISH SECTION LINES & COR.

SECTIONS 7 & 8

T. 10 S., R. 29 E., W. M.
GRANT COUNTY ORE.

FOR: Malheur Nat. Forest BY: D.M.F. & M.F.

Date: March 79

Scale 1" = 50'

Drawn By D.M.F.

MAP OF SURVEY No 566