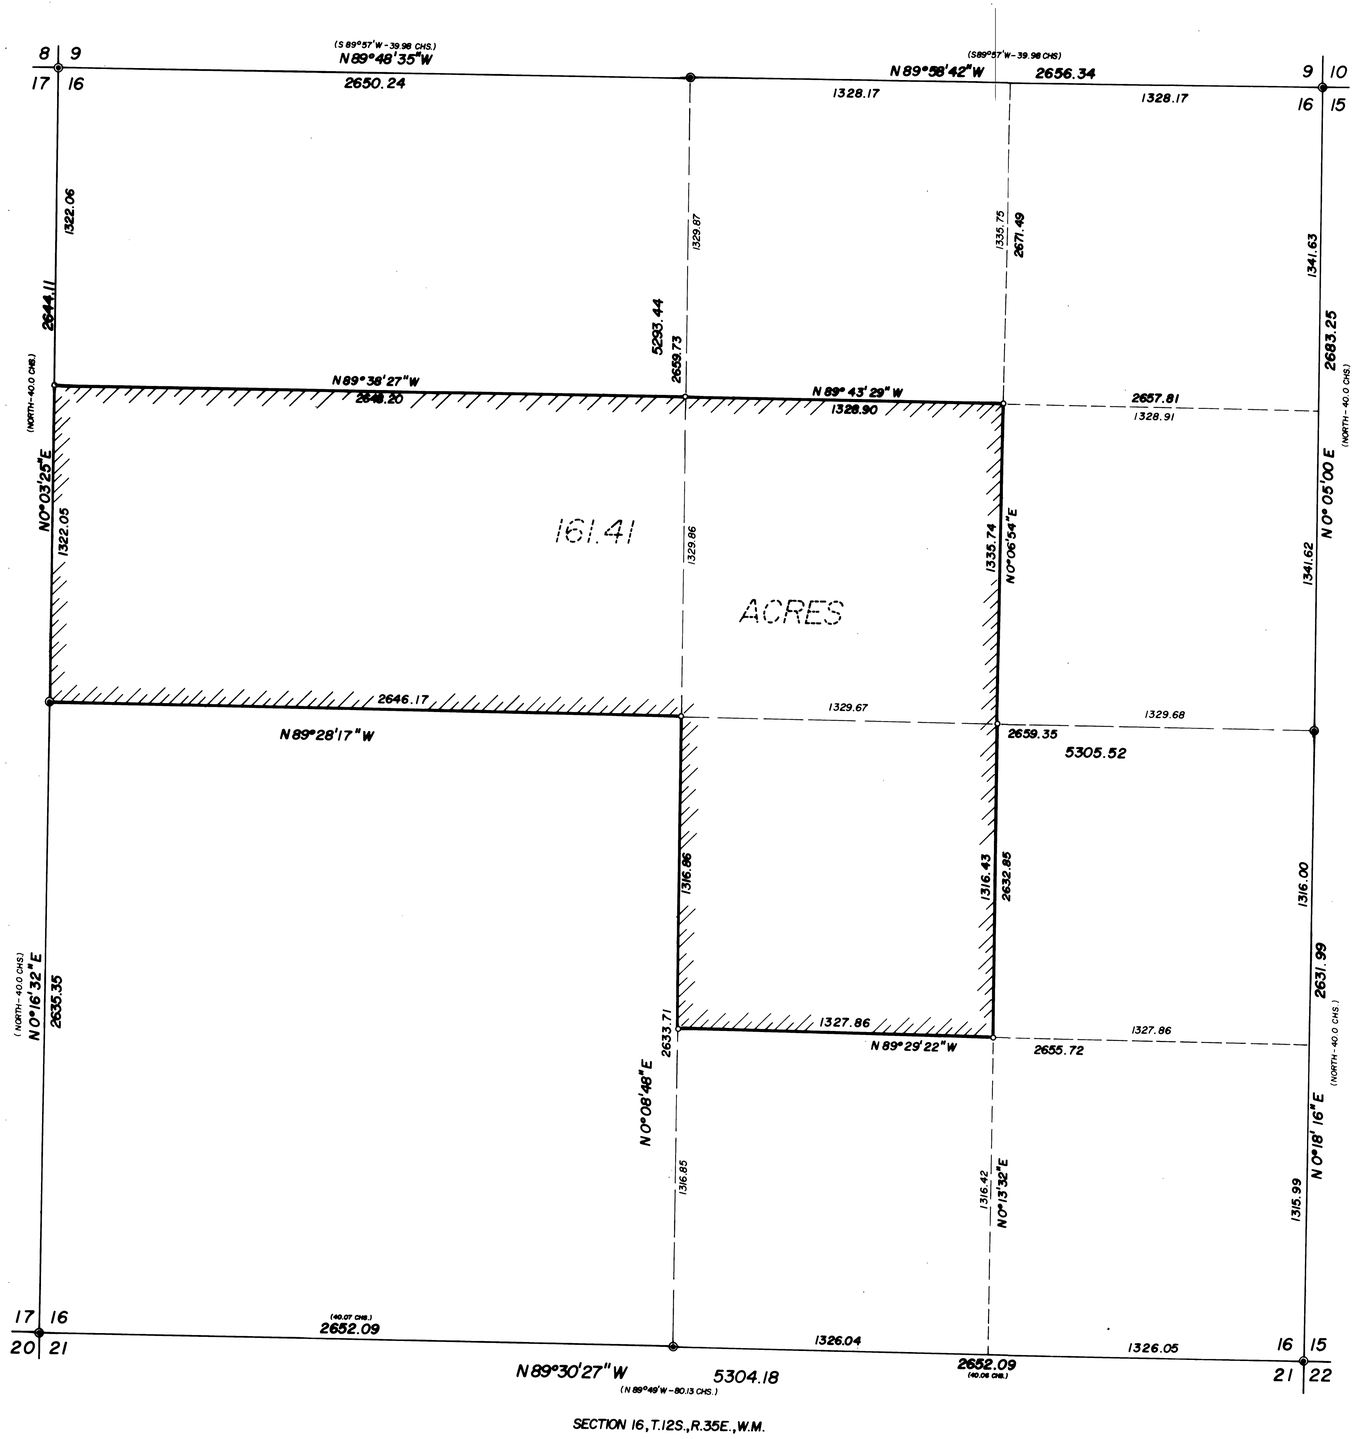

SECTION 16, T.12S., R.35E., W.M.

BASIS OF BEARINGS

SOLAR OBSERVATION

LEGEND

⊕	FOUND EVIDENCE OF ORIGINAL CORNER SET BY BAMFORD ROBB UNDER CONTRACT NO. 383 DATED MARCH 26, 1881 — SET 1 1/2" X 30" IRON PIPE WITH G.C.S. BRASS-CAP.
◉	SET 1 1/2" X 30" IRON PIPE WITH G.C.S. BRASS-CAP AT PROPORTIONATE POSITION.
○	SET 5/8" X 30" IRON PIN.
( )	RECORD BEARING & DISTANCE.

REFERENCES

GLO FIELD NOTES

NOTE: SEE CORNER REMONUMENTATION SHEETS RECORDED WITH THIS PLAT FOR A DESCRIPTION OF EVIDENCE FOUND, OF EACH MONUMENT SET AND OF EACH NEW BEARING TREE TAKEN.

RECEIVED AND FILED
JUL 2 1979
JOHN LIVELY, COUNTY CLERK
Deputy

REGISTERED PROFESSIONAL LAND SURVEYOR
Robert D. Bagett
OREGON
JULY 12, 1963
ROBERT D. BAGETT
598

BAGETT, GRIFFITH & ASSOCIATES
John Day, Oregon
Map of Survey

SUBDIVISION OF SECTION 16
T.12S., R.35E., W.M.

GRANT COUNTY, OREGON

SURVEYED FOR	JOE LANE	
SURVEYED BY	R.D.B. & S.F.J.	JUNE, 1979
Scale: 1" = 300'	Drawn by: S.F.J.	JUNE, 1979