


A PORTION OF THE
SHEEP ROCK UNIT
JOHN DAY FOSSIL BEDS
NATIONAL MONUMENT

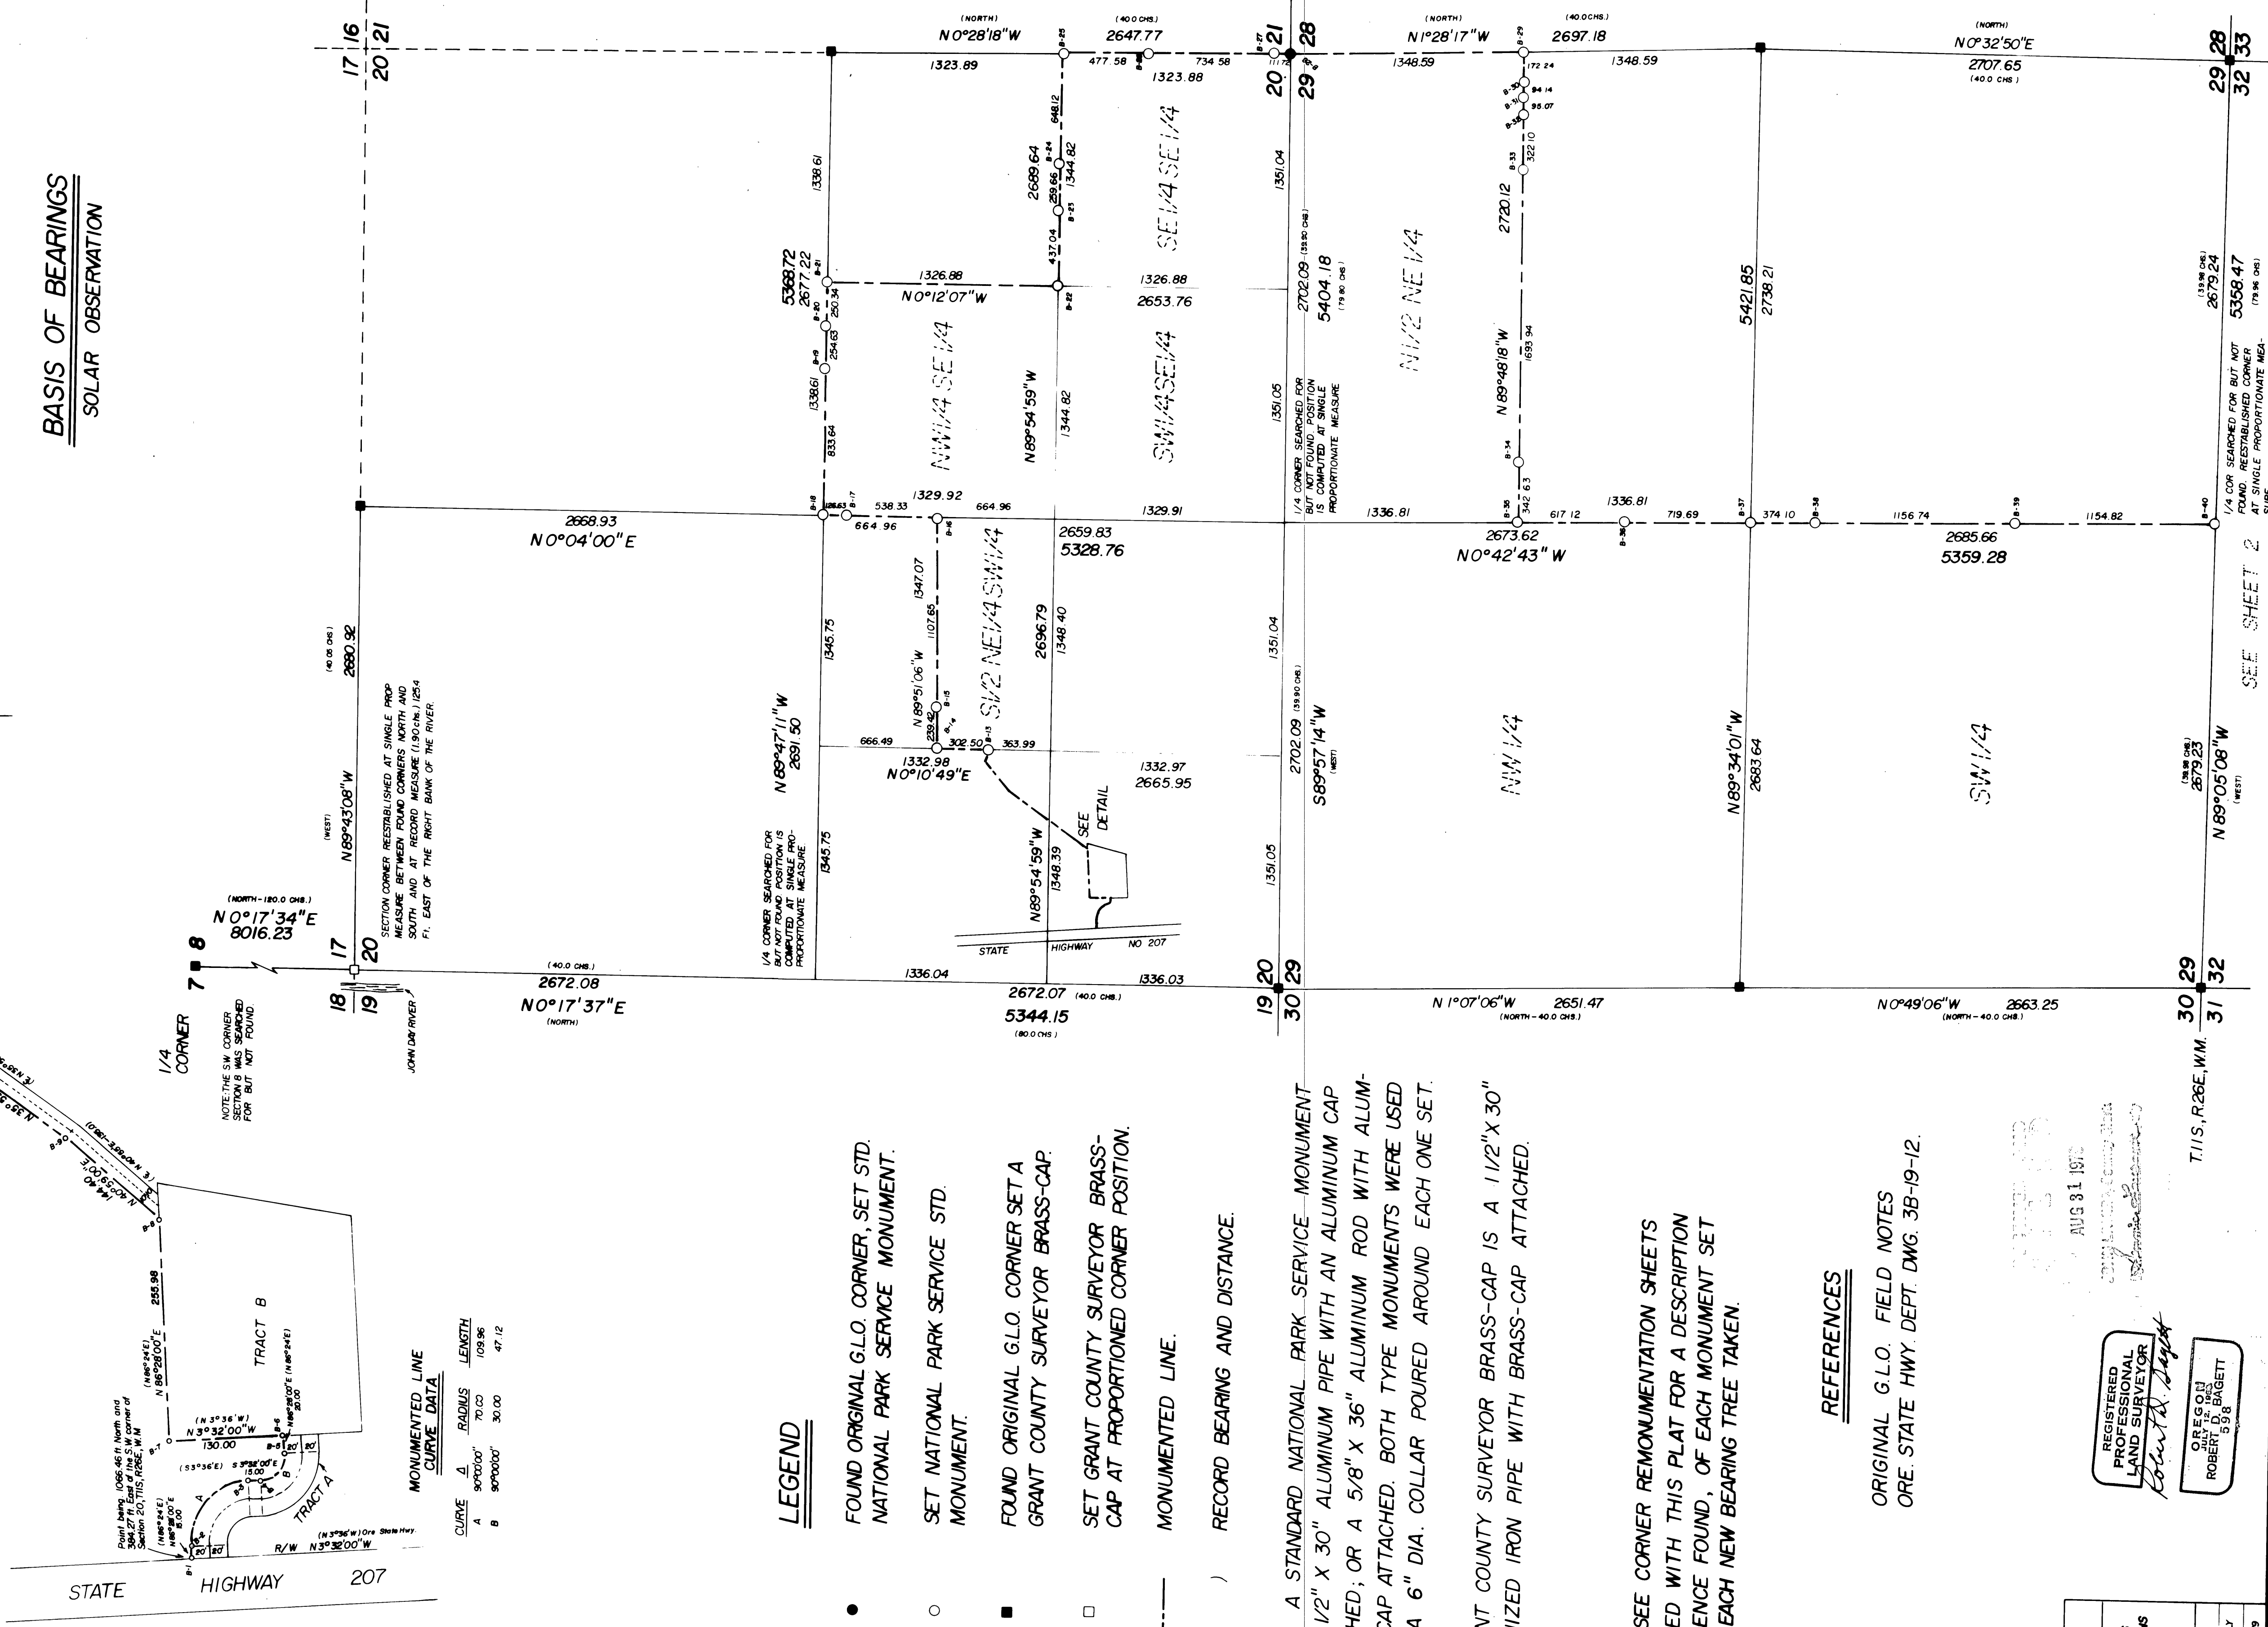

BASIS OF BEARINGS
SOLAR OBSERVATION

DETAIL
SCALE: 1"=100'



- LEGEND**
- FOUND ORIGINAL G.L.O. CORNER, SET STD. NATIONAL PARK SERVICE MONUMENT.
 - SET NATIONAL PARK SERVICE STD. MONUMENT.
 - FOUND ORIGINAL G.L.O. CORNER SET A GRANT COUNTY SURVEYOR BRASS-CAP.
 - SET GRANT COUNTY SURVEYOR BRASS-CAP AT PROPORTIONED CORNER POSITION.
 - MONUMENTED LINE.
 - () RECORD BEARING AND DISTANCE.

NOTE: A STANDARD NATIONAL PARK SERVICE MONUMENT IS A 2 1/2" X 30" ALUMINUM PIPE WITH AN ALUMINUM CAP ATTACHED; OR A 5/8" X 36" ALUMINUM ROD WITH ALUMINUM CAP ATTACHED. BOTH TYPE MONUMENTS WERE USED WITH A 6" DIA. COLLAR POURED AROUND EACH ONE SET.

A GRANT COUNTY SURVEYOR BRASS-CAP IS A 1 1/2" X 30" GALVANIZED IRON PIPE WITH BRASS-CAP ATTACHED.

NOTE: SEE CORNER REMONUMENTATION SHEETS RECORDED WITH THIS PLAT FOR A DESCRIPTION OF EVIDENCE FOUND, OF EACH MONUMENT SET AND OF EACH NEW BEARING TREE TAKEN.

REFERENCES

ORIGINAL G.L.O. FIELD NOTES
ORE STATE HWY DEPT DWG. 3B-19-12.

BAGGETT, GRIFFITH & ASSOCIATES John Day, Oregon Map of Survey	
A PORTION OF THE JOHN DAY FOSSIL BEDS NATIONAL MONUMENT LOCATED IN SECTIONS 20 & 29, T.11S, R.26E, W.1W.	
GRANT COUNTY, OREGON	
SURVEYED FOR	NATIONAL PARK SERVICE
SURVEYED BY	RDB, DIG, K.L., L.M., B.S.E. MAR-JULY 1979
Scale: 1" = 800'	Drawn by: S.F.J. JULY, 1979

REGISTERED
PROFESSIONAL
LAND SURVEYOR
Robert L. Baggett
OREGON
JULY 15, 1963
ROBERT L. BAGGETT
598