


A PORTION OF THE
SHEEP ROCK UNIT
JOHN DAY FOSSIL BEDS
NATIONAL MONUMENT



BASIS OF BEARINGS
SOLAR OBSERVATION

SEE SHEET 1

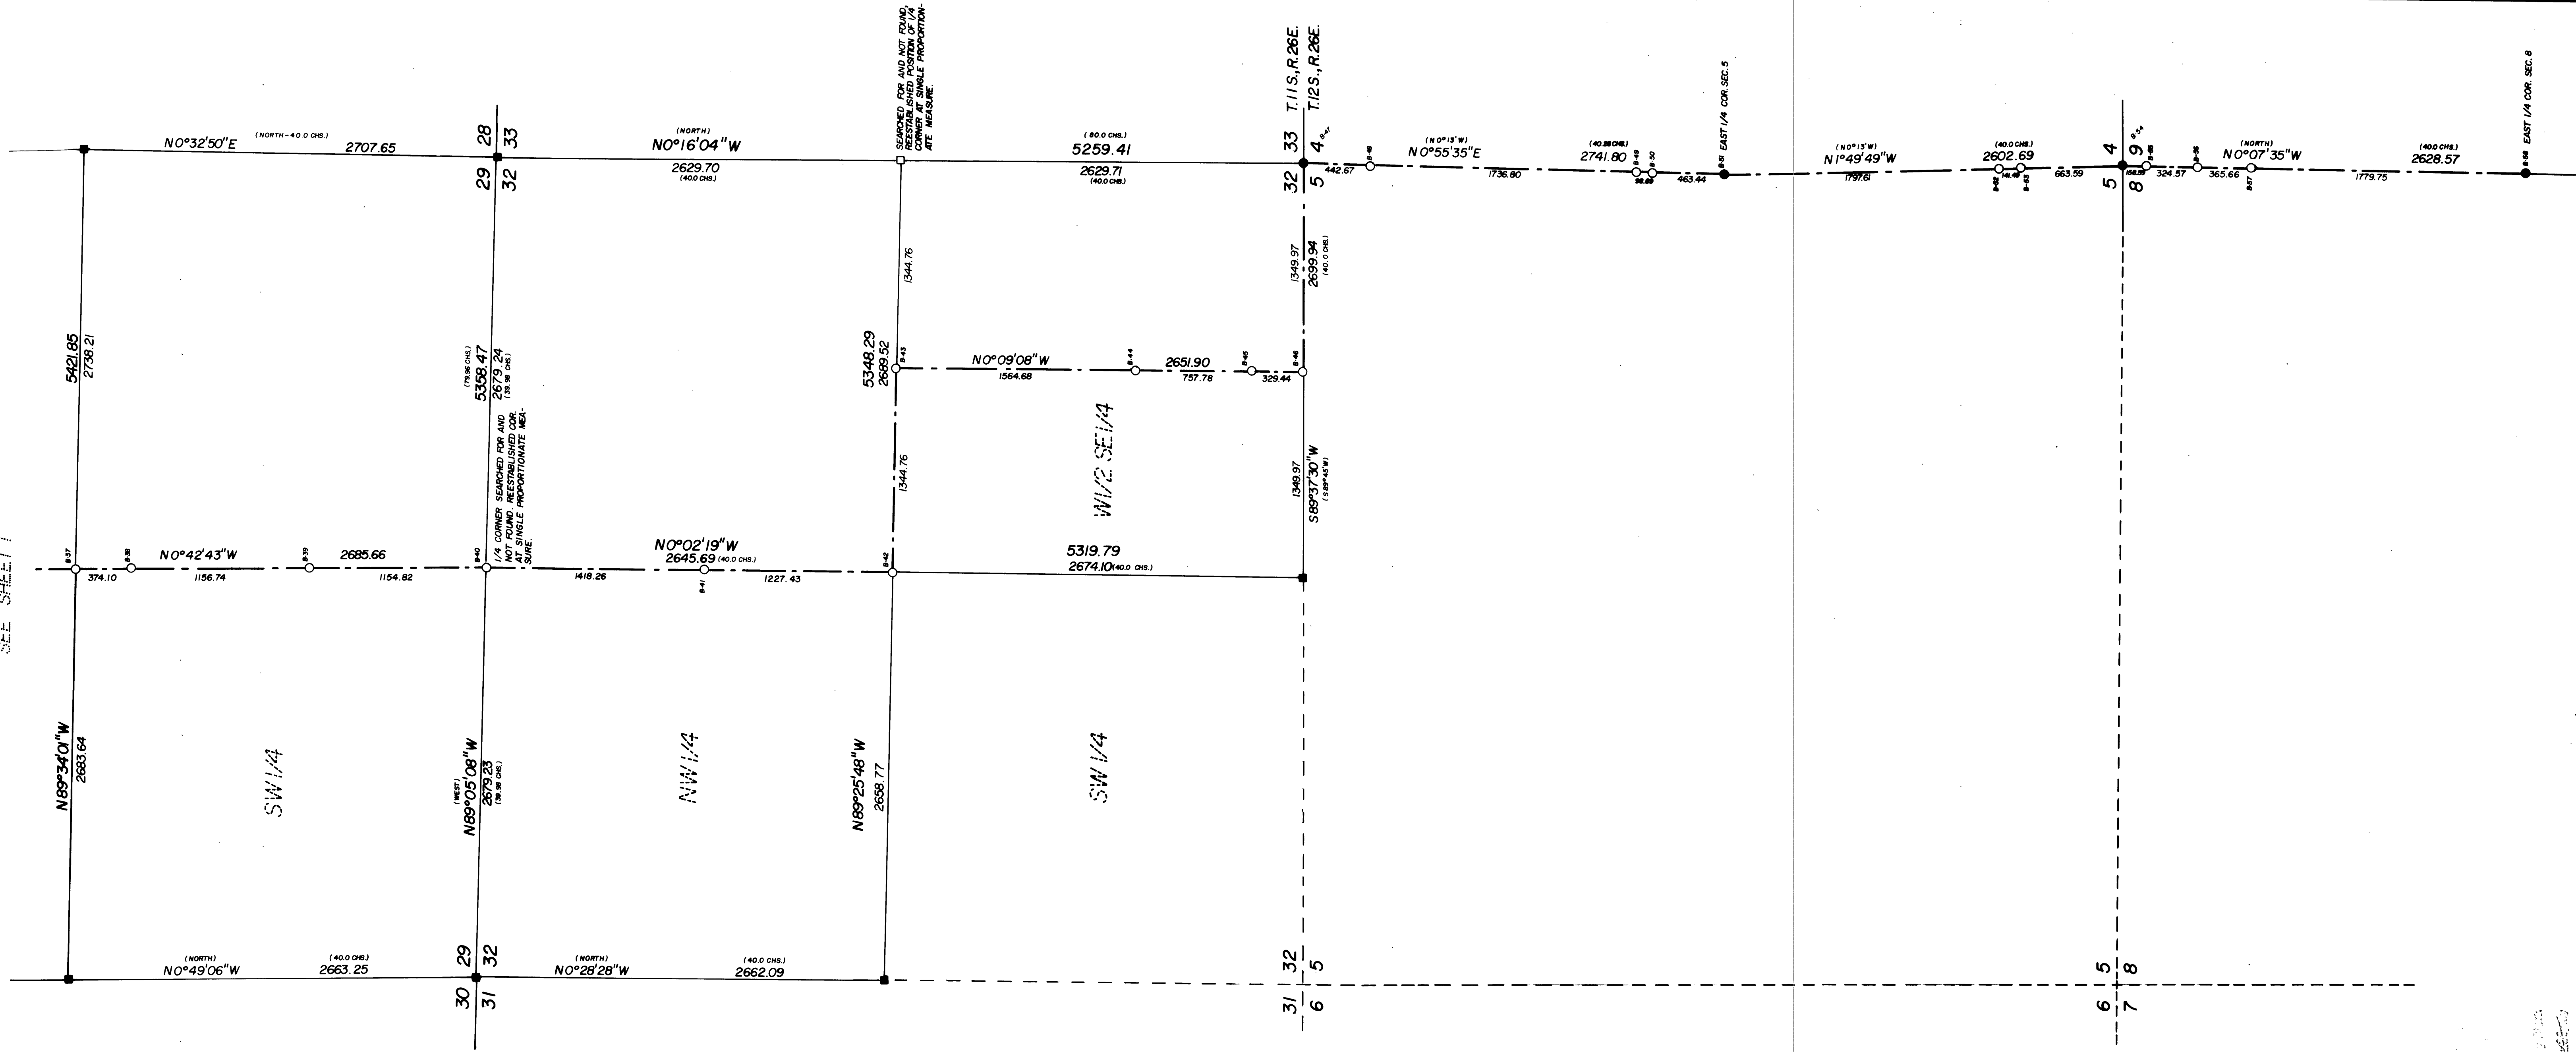

BAGGETT, GRIFFITH & ASSOCIATES Map of Survey	
A PORTION OF THE JOHN DAY FOSSIL BEDS NATIONAL MONUMENT T.12S., R.26E., S.10E.	
SURVEYED FOR	NATIONAL PARK SERVICE
SURVEYED BY	R.D.S., J.L.B., K.L.L., L.M., B.G.E., MAR.-JULY, 1979
Scale: 1" = 800'	Drawn by: S.F.J. JULY, 1979

REGISTERED
PROFESSIONAL
LAND SURVEYOR
Robert S. Baggett
OREGON
JULY 12, 1965
ROBERT S. BAGGETT

AUG 31 1979
Robert S. Baggett