


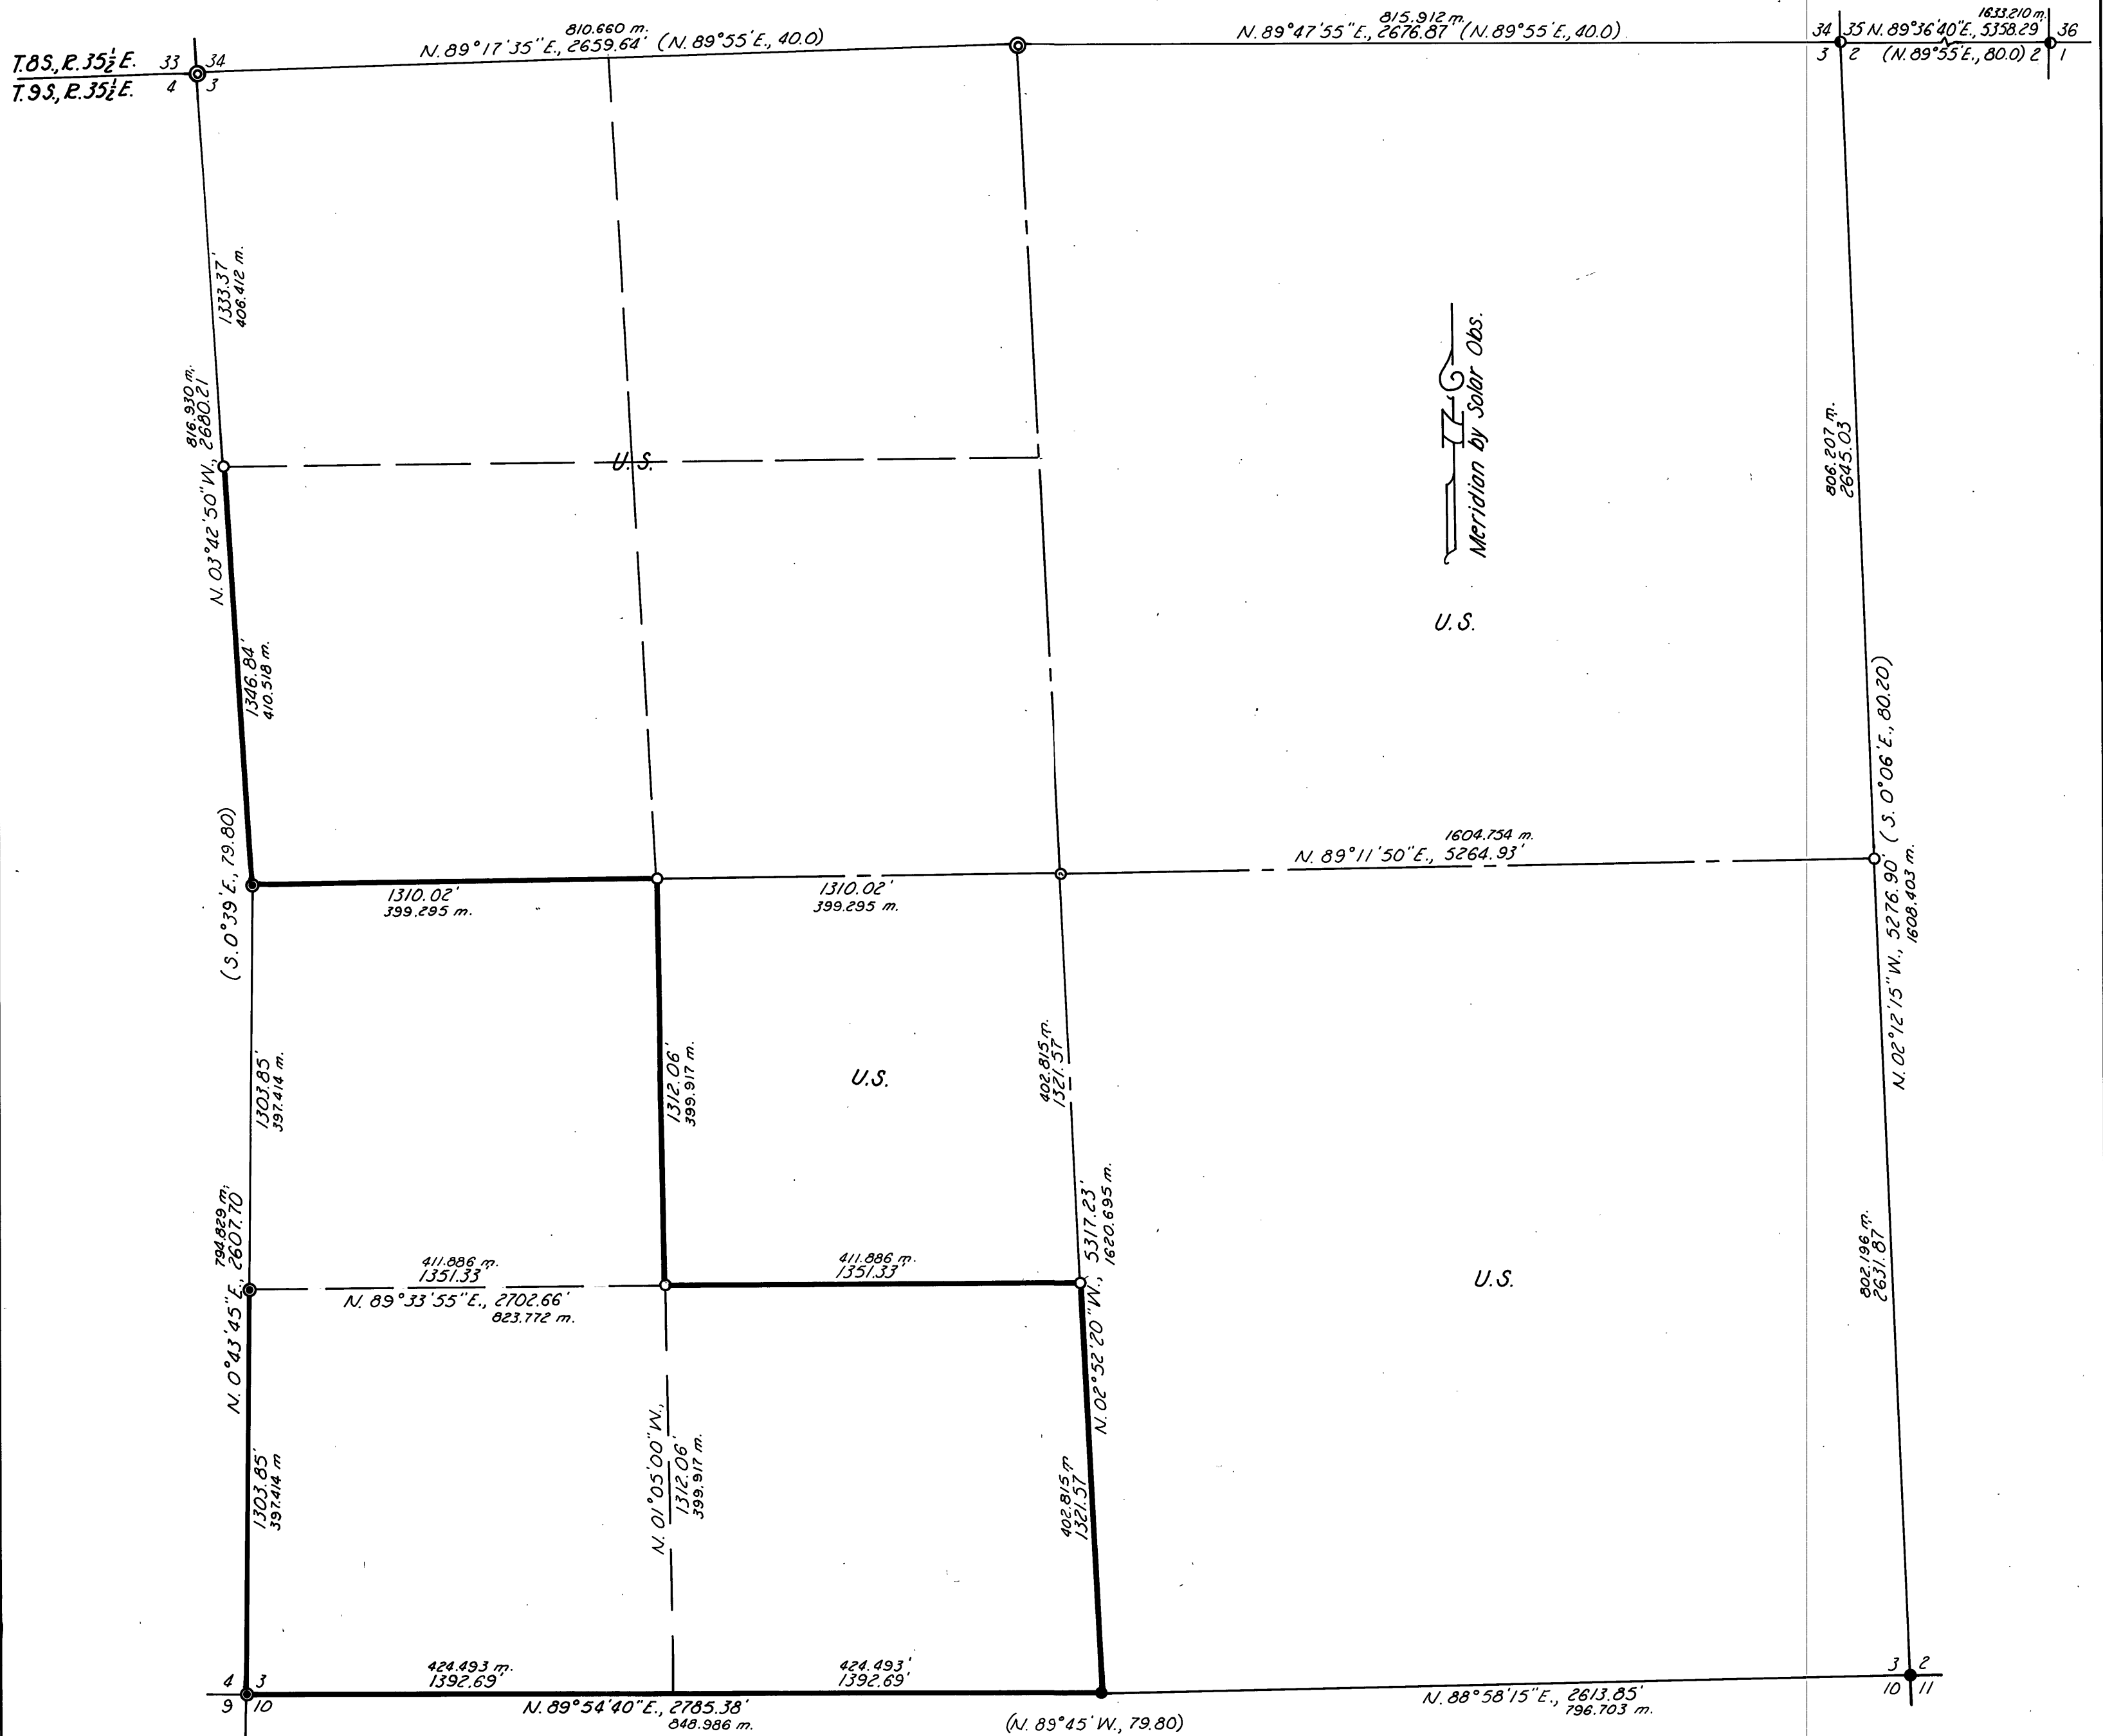

U. S. GOVERNMENT LAND LOCATED IN
SECTION 3, T.9 S., R.35 E., W.1 M.
THE NW 1/4, THE NE 1/4, THE SE 1/4 & THE NE 1/4 SW 1/4

NOTE
FOR MONUMENTATION RECORDS SEE CERTIFIED RECORD
OF CORNER MONUMENTATION SHEETS FILED SEPARATELY.

SOLAR OBS. DATA

TRANSIT STA. NO. 1 =
S. 79°37'40"E., 729.31 FT. FROM
NE COR. SECTION 2
NOVEMBER 10, 1978
LATITUDE 44°49'05"
DECLINATION 17°10'57"
VERTICAL ANGLE 21°45'12"
MEAN DECLINATION 19°10'E.

LEGEND

- FOUND BEASS CAP MONUMENT
- FOUND G.L.O. CORNER; SET 2 1/2" BEASS CAP ON 2" IRON PIPE.
- SET 2 1/2" BEASS CAP ON 2" IRON PIPE AT PROPORTIONATE DISTANCE.
- FOUND CORNER MONUMENT; NOT REMONUMENTED
- FOUND CORNER MONUMENT; REMONUMENTED WITH 2 1/2" BEASS CAP ON 2" IRON PIPE
- () G.L.O. RECORD BEARING AND DISTANCE
- PROPERTY BOUNDARY POSTED

SURVEYOR'S STATEMENT

I, WILLIAM L. HANLEY, A REGISTERED LAND SURVEYOR IN THE STATE OF OREGON, HEREBY CERTIFY THAT THIS PLAT AND THE NOTES HEREON, OR ATTACHED, ARE A CORRECT REPRESENTATION OF A SURVEY PERFORMED BY ME DURING NOVEMBER, 1978 AND JUNE, 1979 FOR THE U.S. FOREST SERVICE, IN ACCORDANCE WITH THE STATUTES OF THE STATE OF OREGON AND WITH THE ARTICLES OF MY CONTRACT.

William L. Hanley
OELS 1639

RECORD OF SURVEY PLAT

SUMPTER-GRANITE CADASTRAL SURVEY

U.S. FOREST SERVICE CONTRACT NO. 53-04HI-8-7079N

Surveyed Nov. 10, 1978 to June 6, 1979

Scale 1" = 400'

SURVEYED BY HANLEY ENGINEERING

RECEIVED AND
FILED

JUL 13 1979

JOHN LIVEIRA, County Clerk

REGISTERED
PROFESSIONAL
LAND SURVEYOR

William L. Hanley

OREGON
JULY 14, 1978
WILLIAM L. HANLEY
1639