

U.S. GOVERNMENT LAND LOCATED IN
SECTION 1, T.9S., R.35E., W.M.

THE SW $\frac{1}{4}$, THE SE $\frac{1}{4}$, THE SW $\frac{1}{4}$ NE $\frac{1}{4}$, THE SE $\frac{1}{4}$ NW $\frac{1}{4}$

SOLAR OBS. DATA

TRANSIT STA. NO. 202 =
N. 19° 36' 45" E., 565.01 ft. FROM
SE COR. SECTION 1.
NOVEMBER 27, 1978
LATITUDE 44° 48' 28"
DECLINATION 21° 08' 54"
VERTICAL ANGLE 15° 22' 08"
MEAN DECLINATION 19° E

LEGEND

- FOUND BRASS CAP MONUMENT
- FOUND G.L.O. CORNER; SET 2 $\frac{1}{2}$ " BRASS CAP ON 2" IRON PIPE
- SET 2 $\frac{1}{2}$ " BRASS CAP ON 2" IRON PIPE AT PROPORTIONATE DISTANCE
- ⊙ FOUND CORNER MONUMENT; NOT REMONUMENTED
- ⊙ FOUND CORNER MONUMENT; REMONUMENTED WITH 2 $\frac{1}{2}$ " BRASS CAP ON 2" IRON PIPE
- () G.L.O. RECORD BEARING AND DISTANCE (SENIOR)
- [] G.L.O. RECORD BEARING AND DISTANCE (JUNIOR)
- PROPERTY BOUNDARY POSTED

NOTES

FOR MONUMENTATION RECORDS SEE CERTIFIED RECORD OF CORNER MONUMENTATION SHEETS FILED SEPARATELY.

THE SOLAR OBSERVATION IS FOR AZIMUTH CHECK ONLY - THE BASIS OF BEARING IS SURVEY OF SECTION 3, T.9S., R.35E., W.M., UNDER SAME CONTRACT.

SURVEYOR'S STATEMENT


I, WILLIAM L. HANLEY, A REGISTERED LAND SURVEYOR IN THE STATE OF OREGON, HEREBY CERTIFY THAT THIS PLAT AND THE NOTES HEREON, OR ATTACHED, ARE A CORRECT REPRESENTATION OF A SURVEY PERFORMED BY ME DURING NOVEMBER, 1978 AND MAY AND JUNE, 1979 FOR THE U.S. FOREST SERVICE, IN ACCORDANCE WITH THE STATUTES OF THE STATE OF OREGON AND WITH THE ARTICLES OF MY CONTRACT.

William L. Hanley
OELS 1639

REGISTERED
PROFESSIONAL
LAND SURVEYOR

William L. Hanley

OREGON
JULY 14, 1978
WILLIAM L. HANLEY
1639

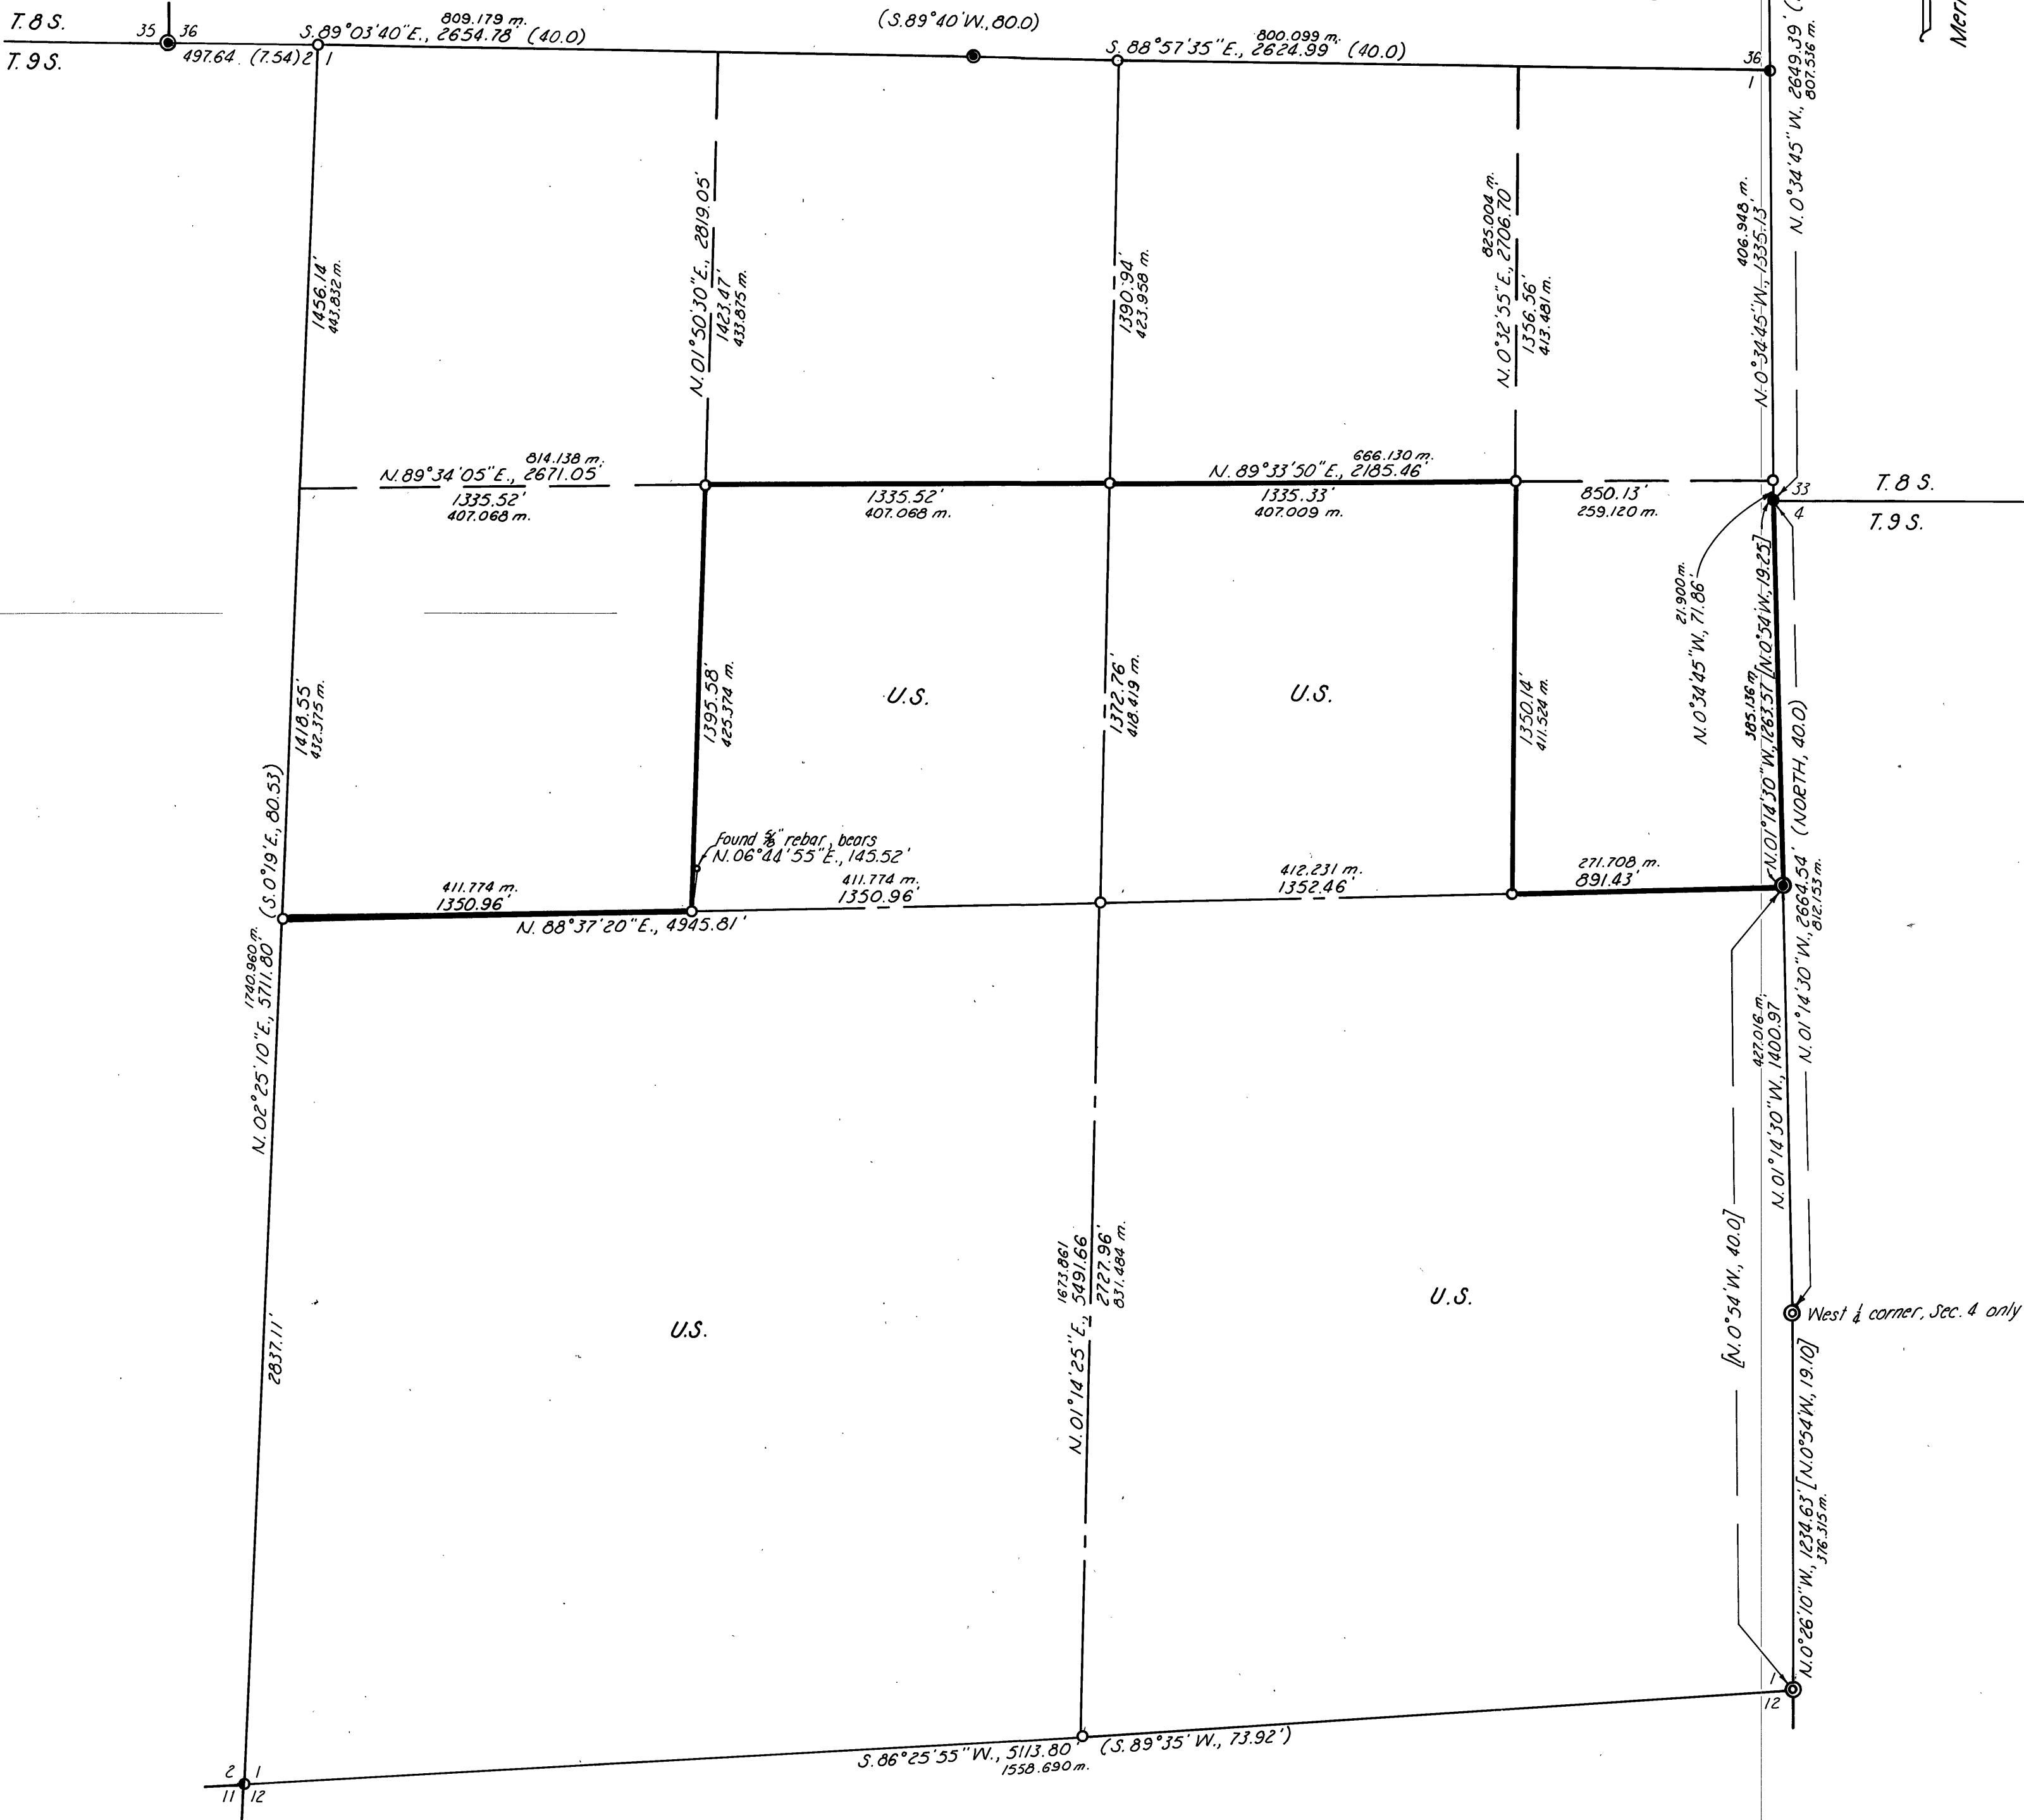

RECORD OF SURVEY PLAT
SUMPTER-GRANITE CADASTRAL SURVEY

U.S. FOREST SERVICE CONTRACT NO. 53-04HI-8-7079N

Surveyed Nov. 24, 1978 to June 15, 1979

Scale 1" = 400'

SURVEYED BY HANLEY ENGINEERING

RECEIVED AND
FILED

JUL 13 1979

JOHN L. VEIRA, County Clerk
Barbara Lawrence Deputy