


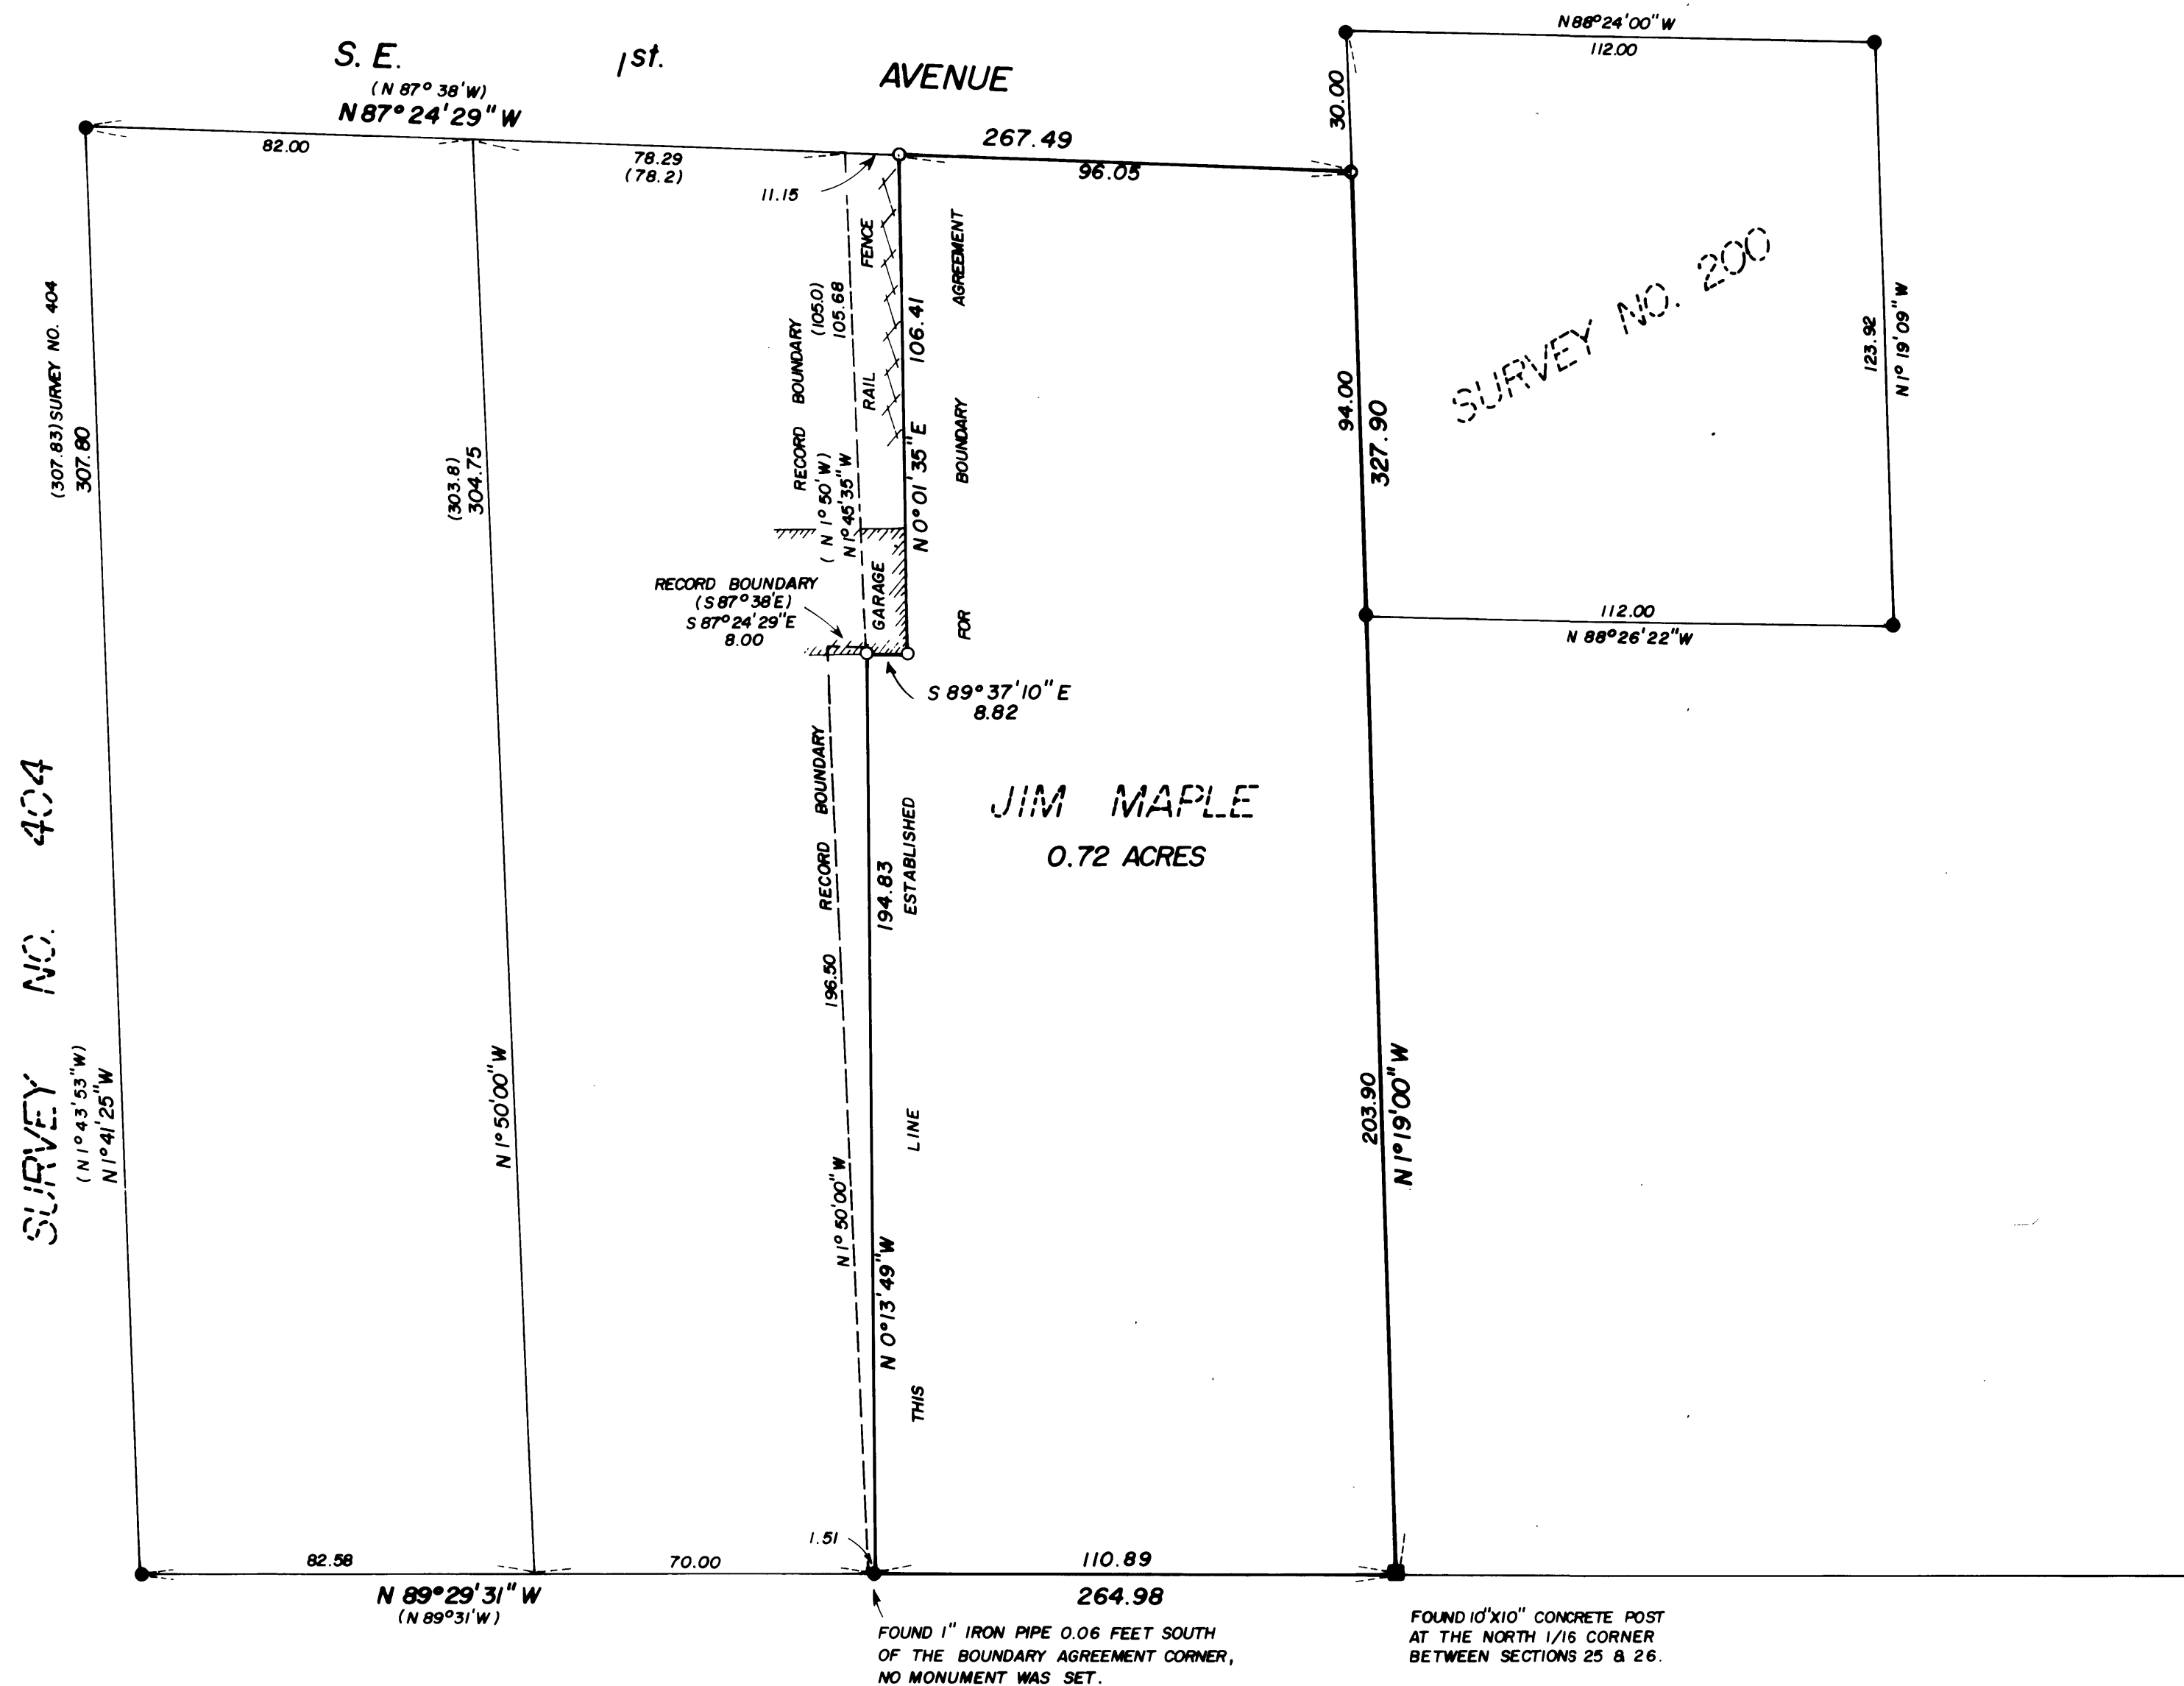

BASIS OF BEARINGS
SOLAR OBSERVATION

- LEGEND**
- FOUND 5/8" IRON PIN.
 - SET 5/8" X 30" IRON PIN.
 - () RECORD BEARING & DISTANCE.

REFERENCES
MAP OF SURVEY NO. 200
MAP OF SURVEY NO. 404

RECEIVED AND
FILED

SEP 18 1979

JOHN LIVEIRA, County Clerk
John Liveira

REGISTERED
PROFESSIONAL
LAND SURVEYOR

Robert D. Bagett
OREGON
JULY 12, 1963
ROBERT D. BAGETT
598

BAGETT, GRIFFITH & ASSOCIATES John Day, Oregon		
Map of Survey TRACT OF LAND IN THE NE1/4NE1/4 SECTION 26, T.13S., R.31E., W.M. 8 IN THE CITY OF JOHN DAY, GRANT COUNTY, OREGON		
SURVEYED FOR	JIM MAPLE JR.	
SURVEYED BY	R.D.B. & S.F.J.	AUG., 1979
Scale: 1" = 30'	Drawn by: S.F.J.	AUG., 1979

MAP OF SURVEY NO. 578