


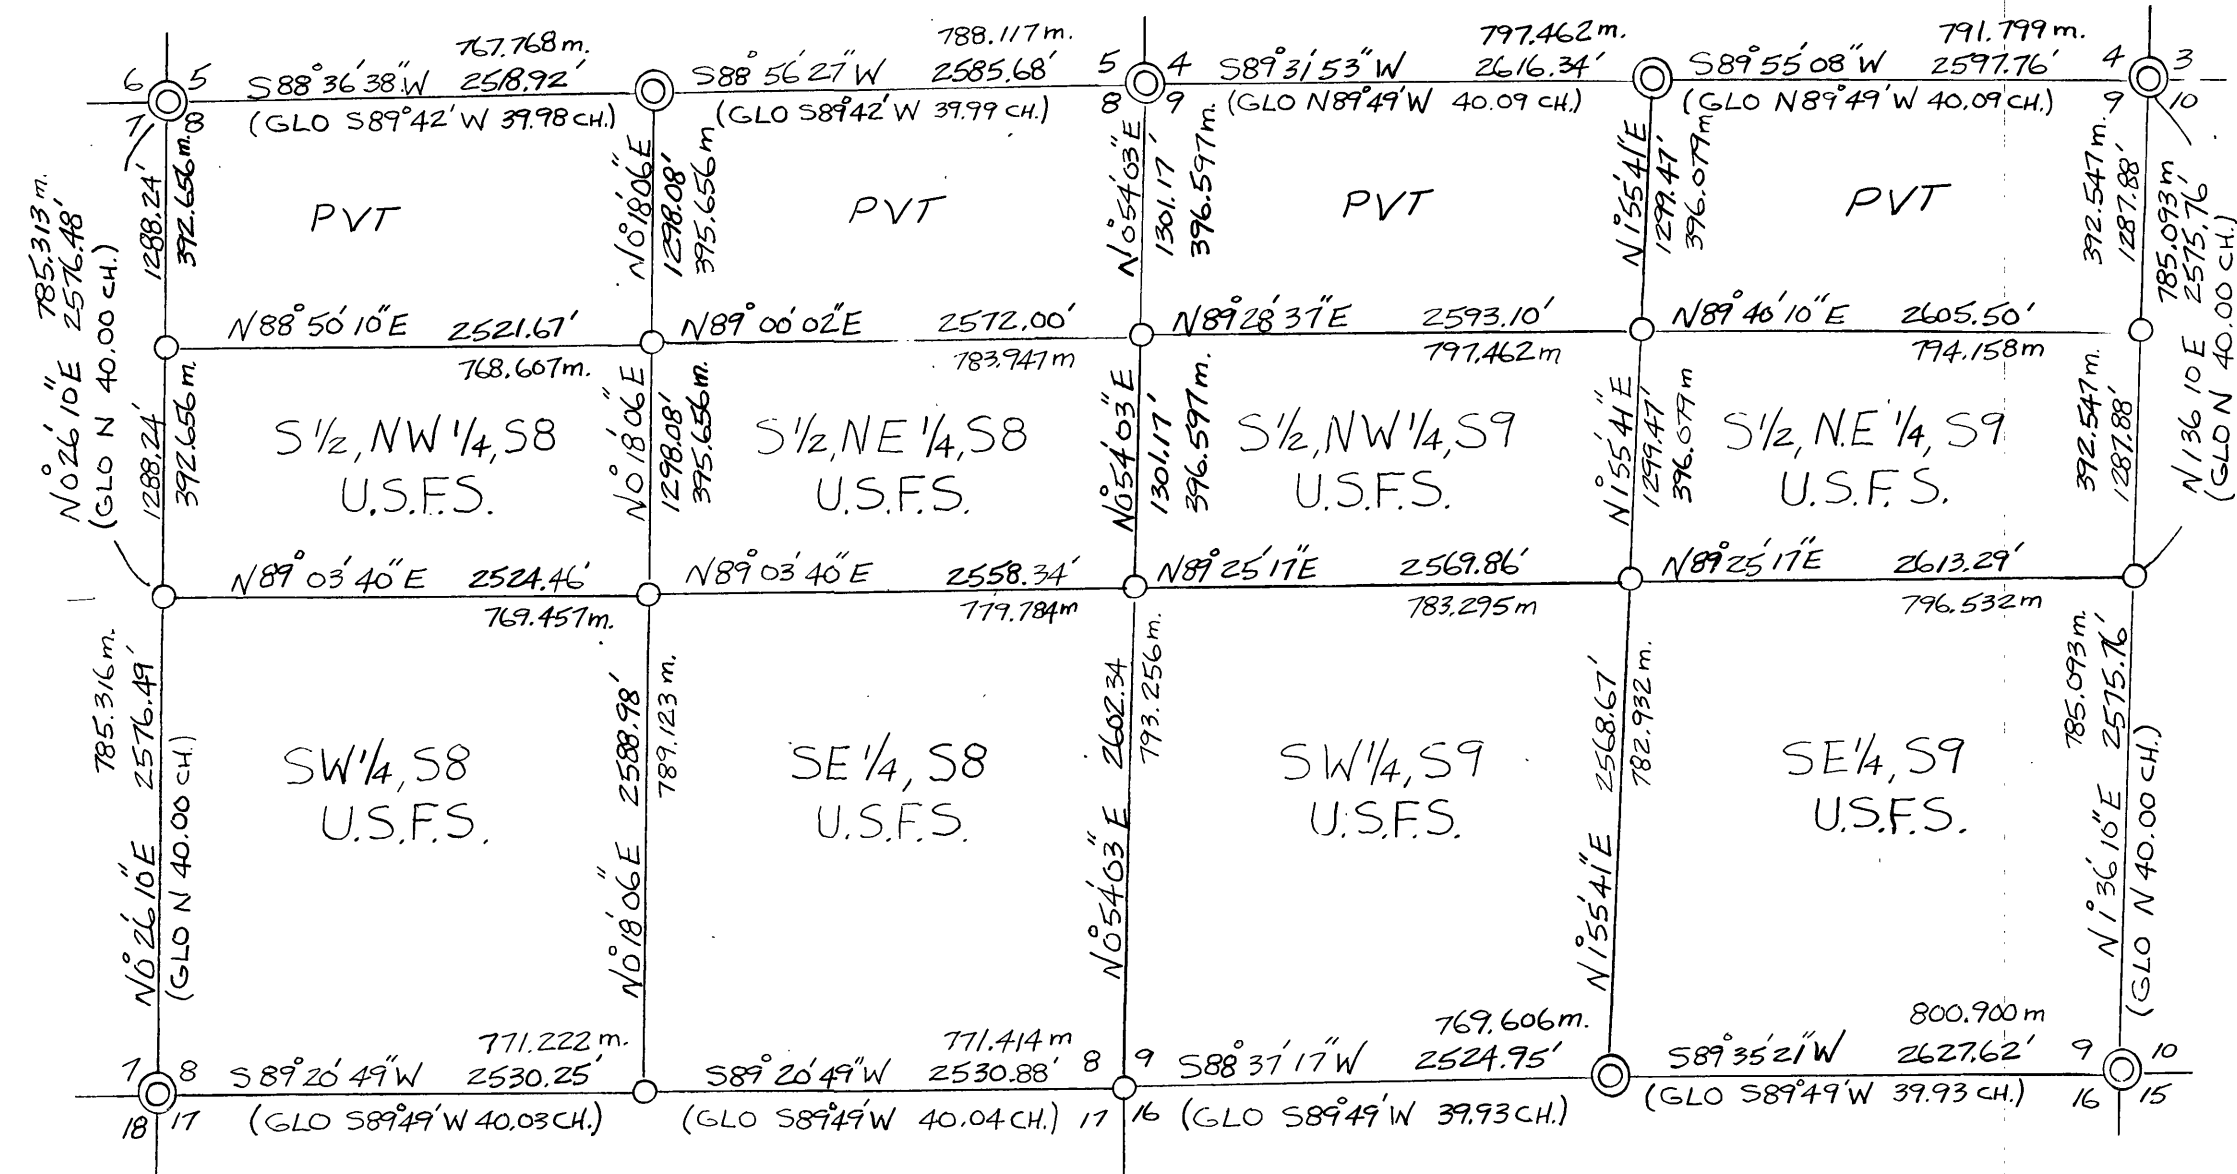

BASIS OF BEARINGS
SOLAR OBSERVATIONS

MEAN MAGNETIC
DECLINATION = 20°14' E

I, WAYNE O. HARRIS, A REGISTERED LAND SURVEYOR IN THE STATE OF OREGON, HEREBY CERTIFY THAT THIS PLAT AND THE NOTES HEREON, OR ATTACHED, ARE A CORRECT REPRESENTATION OF A SURVEY I PERFORMED DURING JULY-SEPTEMBER, 1979, FOR THE U.S. FOREST SERVICE, IN ACCORDANCE WITH THE STATUTES OF THE STATE OF OREGON AND WITH THE ARTICLES OF MY CONTRACT.

RECEIVED AND
FILED
OCT 15 1979
JOHN LIVEIRA, County Clerk
Jimmie Lawrence, Deputy

REGISTERED
PROFESSIONAL
LAND SURVEYOR

WAYNE O. HARRIS
346

SET 2"X32" FLANGED IRON PIPE WITH BR. CAP MON. STAMPED IN ACCORDANCE WITH THE 1973 MANUAL

☒ CORNER ESTABLISHED FROM ORIGINAL EVIDENCE
☐ CORNER ESTABLISHED BY PROPORTIONATE MEASUREMENT

DESCRIPTIONS OF CORNER EVIDENCE AND MONUMENTS FILED WITH CO. SURVEYOR ON U.S.F.S. FORM R6-7100-57

RECORD OF SURVEY PLAT
FOR U.S. FOREST SERVICE
T7S, R26E, WM.
GRANT CO., OREGON

WAYNE HARRIS CO. INC.
SURVEYORS PENDLETON, ORE.

SCALE	DATE	DWN	CHK	DWG. NO.
1"=1000'	9-17-79	FSM	GKS	79-168B