


BASIS OF BEARING

POLARIS OBSERVATION
AUG. 8, 1979

MEAN MAGNETIC DECLINATION

N 19° E

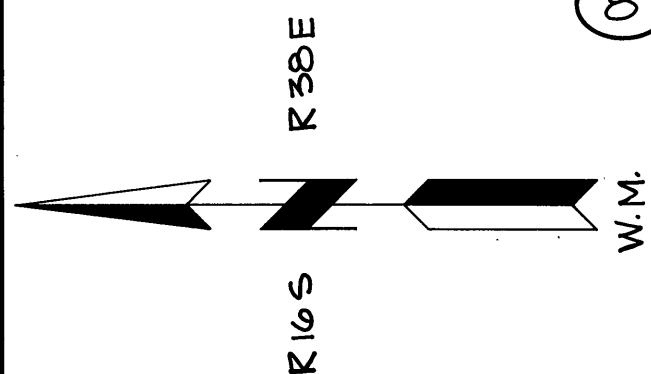

LEGEND

- SET MONUMENT AS DESCRIBED ON ATTACHED U.S.F.S. FORM R6-7100-57 FROM ORIGINAL CORNER EVIDENCE.
- SET MONUMENT AS DESCRIBED ON ATTACHED U.S.F.S. FORM R6-7100-57 BASED ON SURVEY.
- FOUND EXISTING MONUMENT STAMPED AS SHOWN
- () RECORD DATA
- [] METRIC DISTANCES
- *-* POSTED U.S.F.S. BOUNDARY LINE
- ⑧ SECTION NUMBER

REFERENCE MATERIALS

GLO NOTES & PLAT FOR T16S, R38E, W.M.
FIELD BOOKS 3-6 FOR LUCE CREEK & VESTER CREEK CADASTRAL SURVEY

U.S. FOREST SERVICE LANDS

SECTION 17; ALL EXCEPT THE SE 1/4 OF THE SW 1/4.
SECTION 20; ALL EXCEPT THE N 1/2 OF THE NW 1/4 & THE SW 1/4 OF THE NW 1/4.


REFER TO THE FOLLOWING U.S.F.S. FORMS R6-7100-57 FOR INDEX FILE NUMBERS: L-7, M-6, M-7, N-5, N-6, N-9, O-6, O-7, P-6, P-7 & R-7 T16S, R28E, W.M. THESE HAVE BEEN FILED WITH THE GRANT COUNTY SURVEYOR IN CANYON CITY, OREGON.

RECEIVED AND
FILED

OCT 5 1979

JOHN LIVEIRA, County Clerk

By *Annmarie Lawrence* Deputy

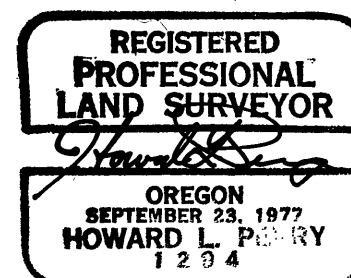

I, HOWARD L. PERRY, a registered land surveyor in the state of Oregon, hereby certify that this plat and the notes hereon, or attached, are a correct representation of a survey performed during July - Sept, 1979, for the U.S. Forest Service, in accordance with the statutes of State of Oregon and with the articles of my contract.

Howard L. Perry

Howard L. Perry
Registered Land Surveyor
Oregon License 1294

SECTIONS 17 & 20, T16S, R28E, W.M.


FOR U.S.F.S. MALHEUR NATIONAL FOREST

SCALE:

1" = 600'

DATE:

1979

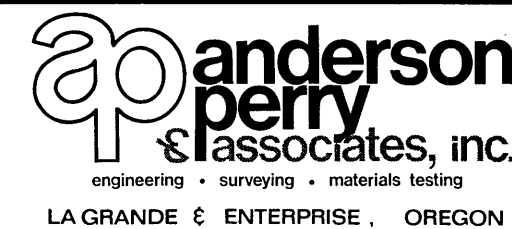

SHEET NO.

1

1