



MONUMENTS SET

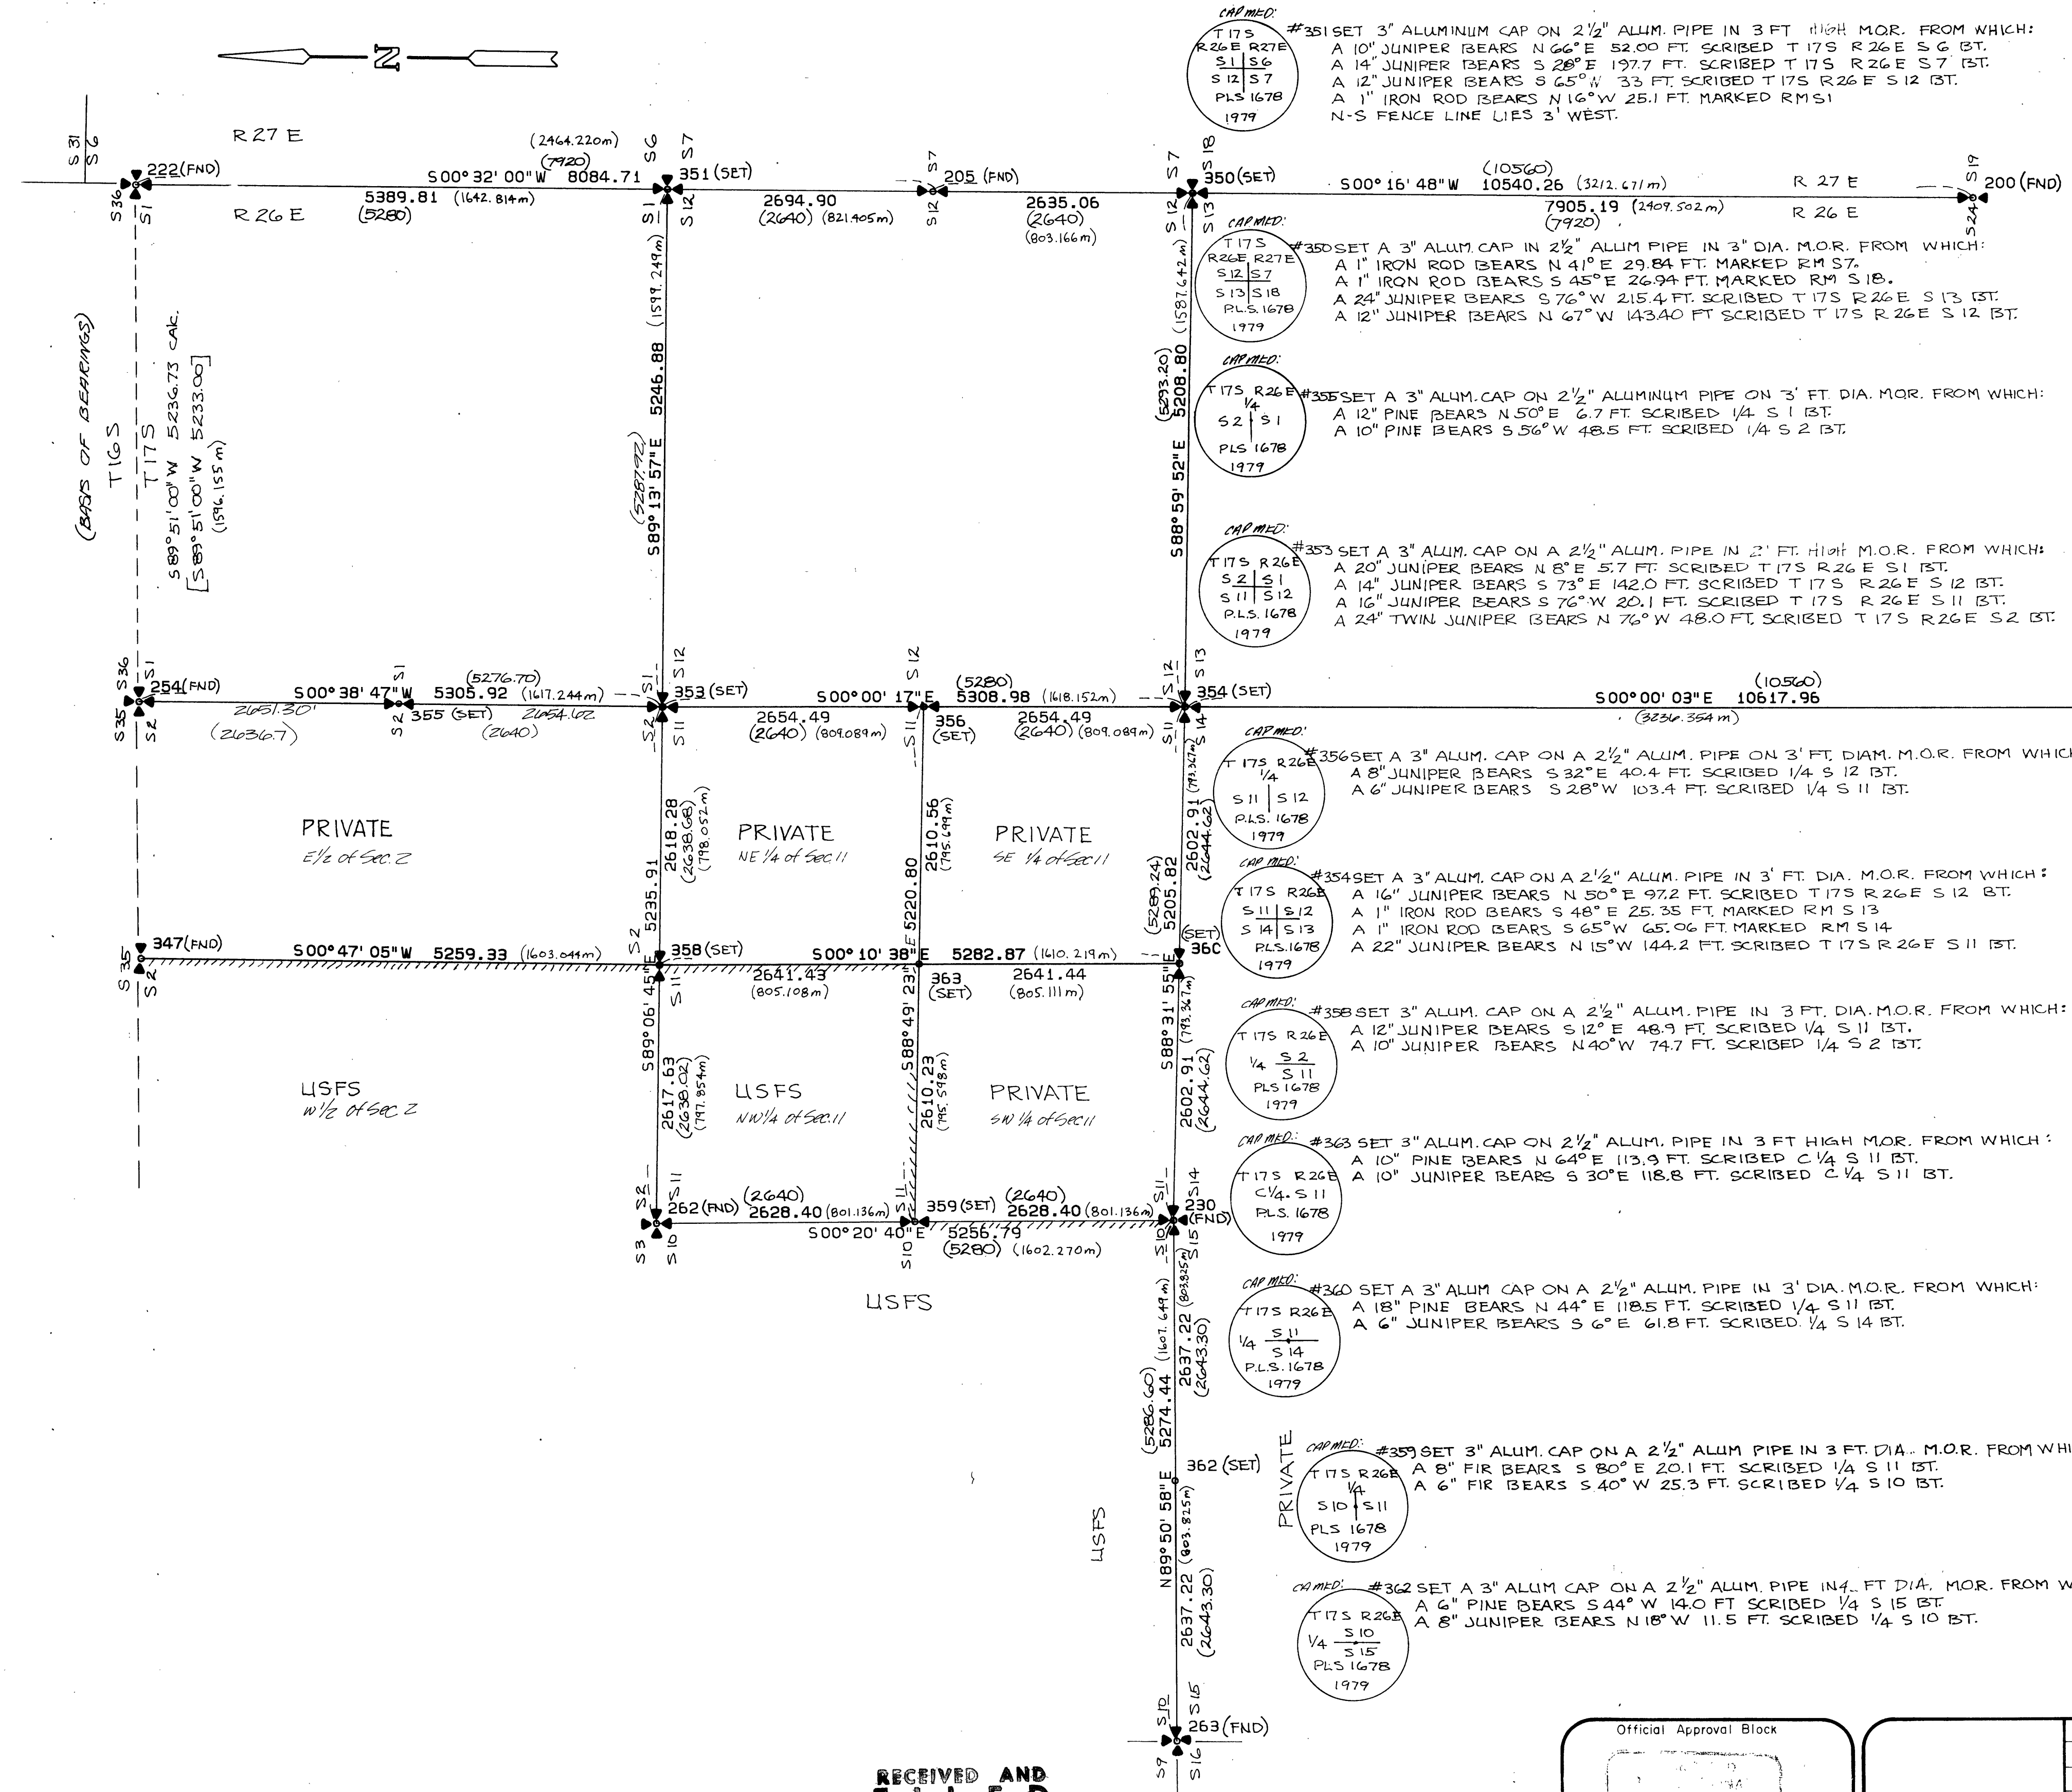

MONUMENTS FOUND

- MONUMENTS FOUND**
- #222 FND 3" BLM BRASS CAP ON 2 1/2" IRON PIPE, FROM WHICH:
FND AN ORIGINAL BT A 34" PINE BEARS N 66° W 60.7 FEET MKD.
T 16 S R 26 E S 36 BT.
FND A 12" PINE BEARS N 54° W 24.0 FT, MARKED WITH HEALED BLAZE.
FND A 15" PINE BEARS S 23° W 27.60 FT, MARKED WITH HEALED BLAZE.
- #205 FND 3" ALUMINUM CAP ON 2 1/2" ALUMINUM PIPE IN MOR. (SET BY PLS. 980 IN PLACE OF ORIGINAL STONE IN JULY 1978) FROM WHICH:
FND A 14" JUNIPER BEARS S 63° E 38.40 FT, MARKED 1/4 S BT.
FND A 16" JUNIPER BEARS S 45° W 64.90 FT, MARKED 1/4 S BT.
- #200 FND 3" ALUMINUM CAP ON 2 1/2" ALUMINUM PIPE 4" ABOVE GROUND (SET BY PLS. 980 IN PLACE OF ORIGINAL STONE IN JULY 1978) FROM WHICH:
FND A 16" JUNIPER BEARS S 12° E 205.00 FT, MARKED T 17 S R 26 E W 1/4 19 BT.
FND A 14" JUNIPER BEARS N 88° W 43.00 FT, MARKED T 17 S R 26 E E 1/4 24 BT.
- #254 FND 3" BRASS CAP ON 2 1/2" IRON PIPE 6" ABOVE GROUND FROM WHICH:
FND A 18" FIR BEARS N 40° E 61.6 FEET MARKED WITH HEALED BLAZE.
FND A 20" FIR BEARS S 9° E 60.6 FEET MARKED WITH HEALED BLAZE.
FND A 18" FIR S 25° W 100.00 FT MARKED WITH HEALED BLAZE.
FND A 12" PINE BEARS N 16° W 22.8 FEET MARKED T 16 S R 26 E S 35 BT.
- #235 FND A 3" ALUMINUM CAP ON 2 1/2" ALUMINUM PIPE IN M.O.R. (SET BY PLS. 980 IN PLACE OF ORIGINAL STONE IN 1978) FROM WHICH:
FND A 2" JUNIPER BEARS N 33° E 168.3 FEET WITH OLS 980 TAG.
FND A 14" JUNIPER BEARS N 88° E 107.00 FEET MARKED S 24 T 17 S R 26 E 1 BT.
FND A 4" JUNIPER (TRIPLE) BEARS S 20° W 125.70 FEET MARKED WITH OLS 980 TAG.
FND A 1" IRON ROD BEARS N 46° W 25.20 FEET MARKED X 1980.
- #347 FND A 3" BRASS CAP ON 2 1/2" IRON PIPE 6" ABOVE GROUND FROM WHICH:
FND A 8" PINE BEARS S 20° E 37.90 FEET MARKED 1/4 S 35 BT.
FND A 14" PINE BEARS WEST 23.00 FEET MARKED 1/4 S 35 BT.
- #262 FND A 3" BRASS CAP ON 2 1/2" IRON PIPE IN MOR. FROM WHICH:
FND A 36" PINE BEARS N 12° E 8.10 FT. MARKED T 17 S R 26 E S 2 BT.
FND A 12" JUNIPER BEARS S 28° W 26.50 FT MARKED T 17 S R 26 E S 11 BT.
FND A 10" JUNIPER BEARS S 50° W 30.90 FT MARKED T 17 S R 26 E S 10 BT.
FND A 6" JUNIPER BEARS N 61° W 53.7 FT MARKED T 17 S R 26 E S 3 BT.
- #230 FND A 3" ALUMINUM CAP ON 2 1/2" ALUMINUM PIPE IN MOR. (SET BY PLS. 980 IN PLACE OF ORIGINAL STONE IN 1978) FROM WHICH:
FND A 14" JUNIPER BEARS N 69° E 57.30 FT. MARKED T 17 S R 26 E S 11 BT.
FND A 8" JUNIPER (TRIPLE) BEARS S 59° E 143.4 FT MARKED T 17 S R 26 E S 14 BT.
FND A 12" JUNIPER BEARS S 56° W 80.6 FEET MARKED T 17 S R 26 E S 15 BT.
FND A 12" JUNIPER BEARS N 20° W 40.20 FT. MARKED T 17 S R 26 E S 10 BT.
FENCE CORNER BEARS S 45° E 3.00 FT.
- #263 FND A 3" ALUMINUM CAP ON 2 1/2" ALUM. CAP 5" ABOVE GROUND FROM WHICH:
FND A 18" PINE BEARS N 66° E 81.4 FT MARKED T 17 S R 26 E S 10 BT.
FND A 18" PINE BEARS S 10° E 94.4 FT MARKED T 17 S R 26 E S 15 BT.
FND A 22" PINE BEARS S 37° W 89.1 FT MARKED T 17 S R 26 E S 14 BT.
FND A 20" PINE BEARS N 38° W 122.5 FT MARKED T 17 S R 26 E S 9 BT.
FENCE CORNER BEARS WEST 12.00 FT.

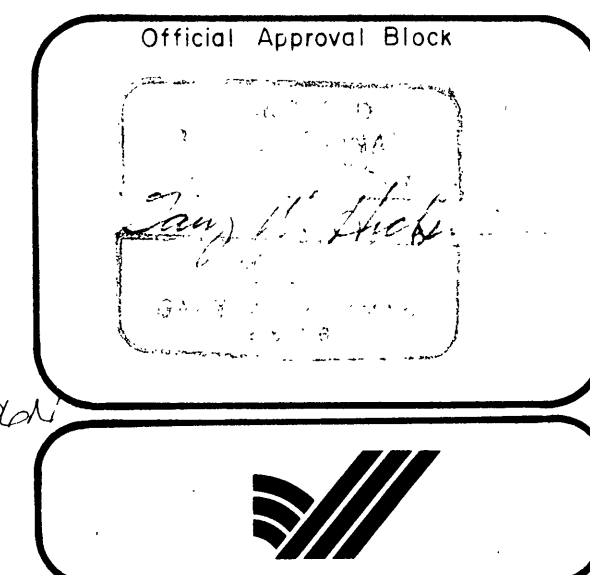

Design By		REVISIONS				BOUNDARY SURVEY	
Drawn By	N.O.	No.	By	Appr.	Date	LOCATED IN T 17 S, R 26 E, W.M.	
Checked By	N.O.					GRANT COUNTY, OREGON	
Approved By	C.W.H.					FOR: U.S. FOREST SERVICE	
Date	8/13/79					OCHOCO NATIONAL FOREST	
Scale	1" = 1000'						
Drawing No.	0142.006 A9						

CENTURY WEST ENGINEERING CORPORATION

SHEET 2 OF 2

HAP OF SURVEY NO. 588