

LEGAL DESCRIPTION
LOT 8 OF THE KILBORN ADDITION
TO THE CITY OF PRAIRIE CITY,
GRANT COUNTY, OREGON.

LOGAN E. NEWTON

DOUGLAS BUNCH

JIMMY T. ADKINS

TO ALL PERSONS INTERESTED IN THE TITLE OF
PREMISES SURVEYED AND SHOWN ON THIS SURVEY
PLAT:
I HEREBY CERTIFY THAT I PERSONALLY MADE AN
ACTUAL SURVEY ON THE GROUND OF THE PREMISES
SHOWN ON THIS SURVEY PLAT ON THE 8th. DAY
OF OCTOBER 1979, THAT THIS PLAT IS A CORRECT
REPRESENTATION OF THE PREMISES AS DETERMINED
BY SAID SURVEY. I FURTHER CERTIFY THAT THERE
ARE NO ENCROACHMENTS EITHER WAY ACROSS ANY
BOUNDARY LINE OF THE PREMISES SHOWN HEREON
EXCEPT AS SHOWN.


SIGNED THIS 9th. DAY OF OCTOBER, 1979.

Robert D. Baggett
OREGON REGISTERED LAND SURVEYOR NO. 598



BASIS OF BEARINGS
SOLAR OBSERVATION

- LEGEND**
- *— FENCE LINE
 - P— POWER LINE
 - W— WATER LINE
 - S— SEWER LINE
 - SET 5/8" X 30" IRON PIN.
 - () RECORD BEARING & DISTANCE.

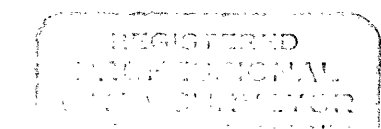

Robert D. Baggett

RECEIVED AND
FILED
OCT 15 1979
JOHN LIVEIRA, County Clerk
Sammie Lawrence Deputy

BAGETT, GRIFFITH & ASSOCIATES		
John Day, Oregon		
Map of Survey		
LOT 8 OF THE KILBORN ADDITION TO THE CITY OF PRAIRIE CITY.		
GRANT COUNTY, OREGON		
SURVEYED FOR	DAVE KIRCHER	
SURVEYED BY	R.D.B. & G.L.E.	OCT. 8, 1979
Scale: 1" = 30'	Drawn by: S.F.J.	OCT. 9, 1979