



BASIS OF BEARING

SOLAR OBSERVATIONS
AT THE WEST 1/4 COR. SECT. 23
LATITUDE 43° 59' 45"
MEAN VERTICAL ANGLE 13° 22' 34"
MEAN SUN DECLINATION 23° 11' 40.5"
MEAN HORIZONTAL ANGLE 293° 59' 52"
MEAN MAGNETIC DECLINATION = 20° EAST

DESCRIPTIONS

OF


FOREST SERVICE LANDS

SECTION 26

S 1/2
NE 1/4

SECTION 36

E 1/2
W 1/2 of the NW 1/4
NW 1/4 of the SW 1/4
SE 1/4 of the SW 1/4

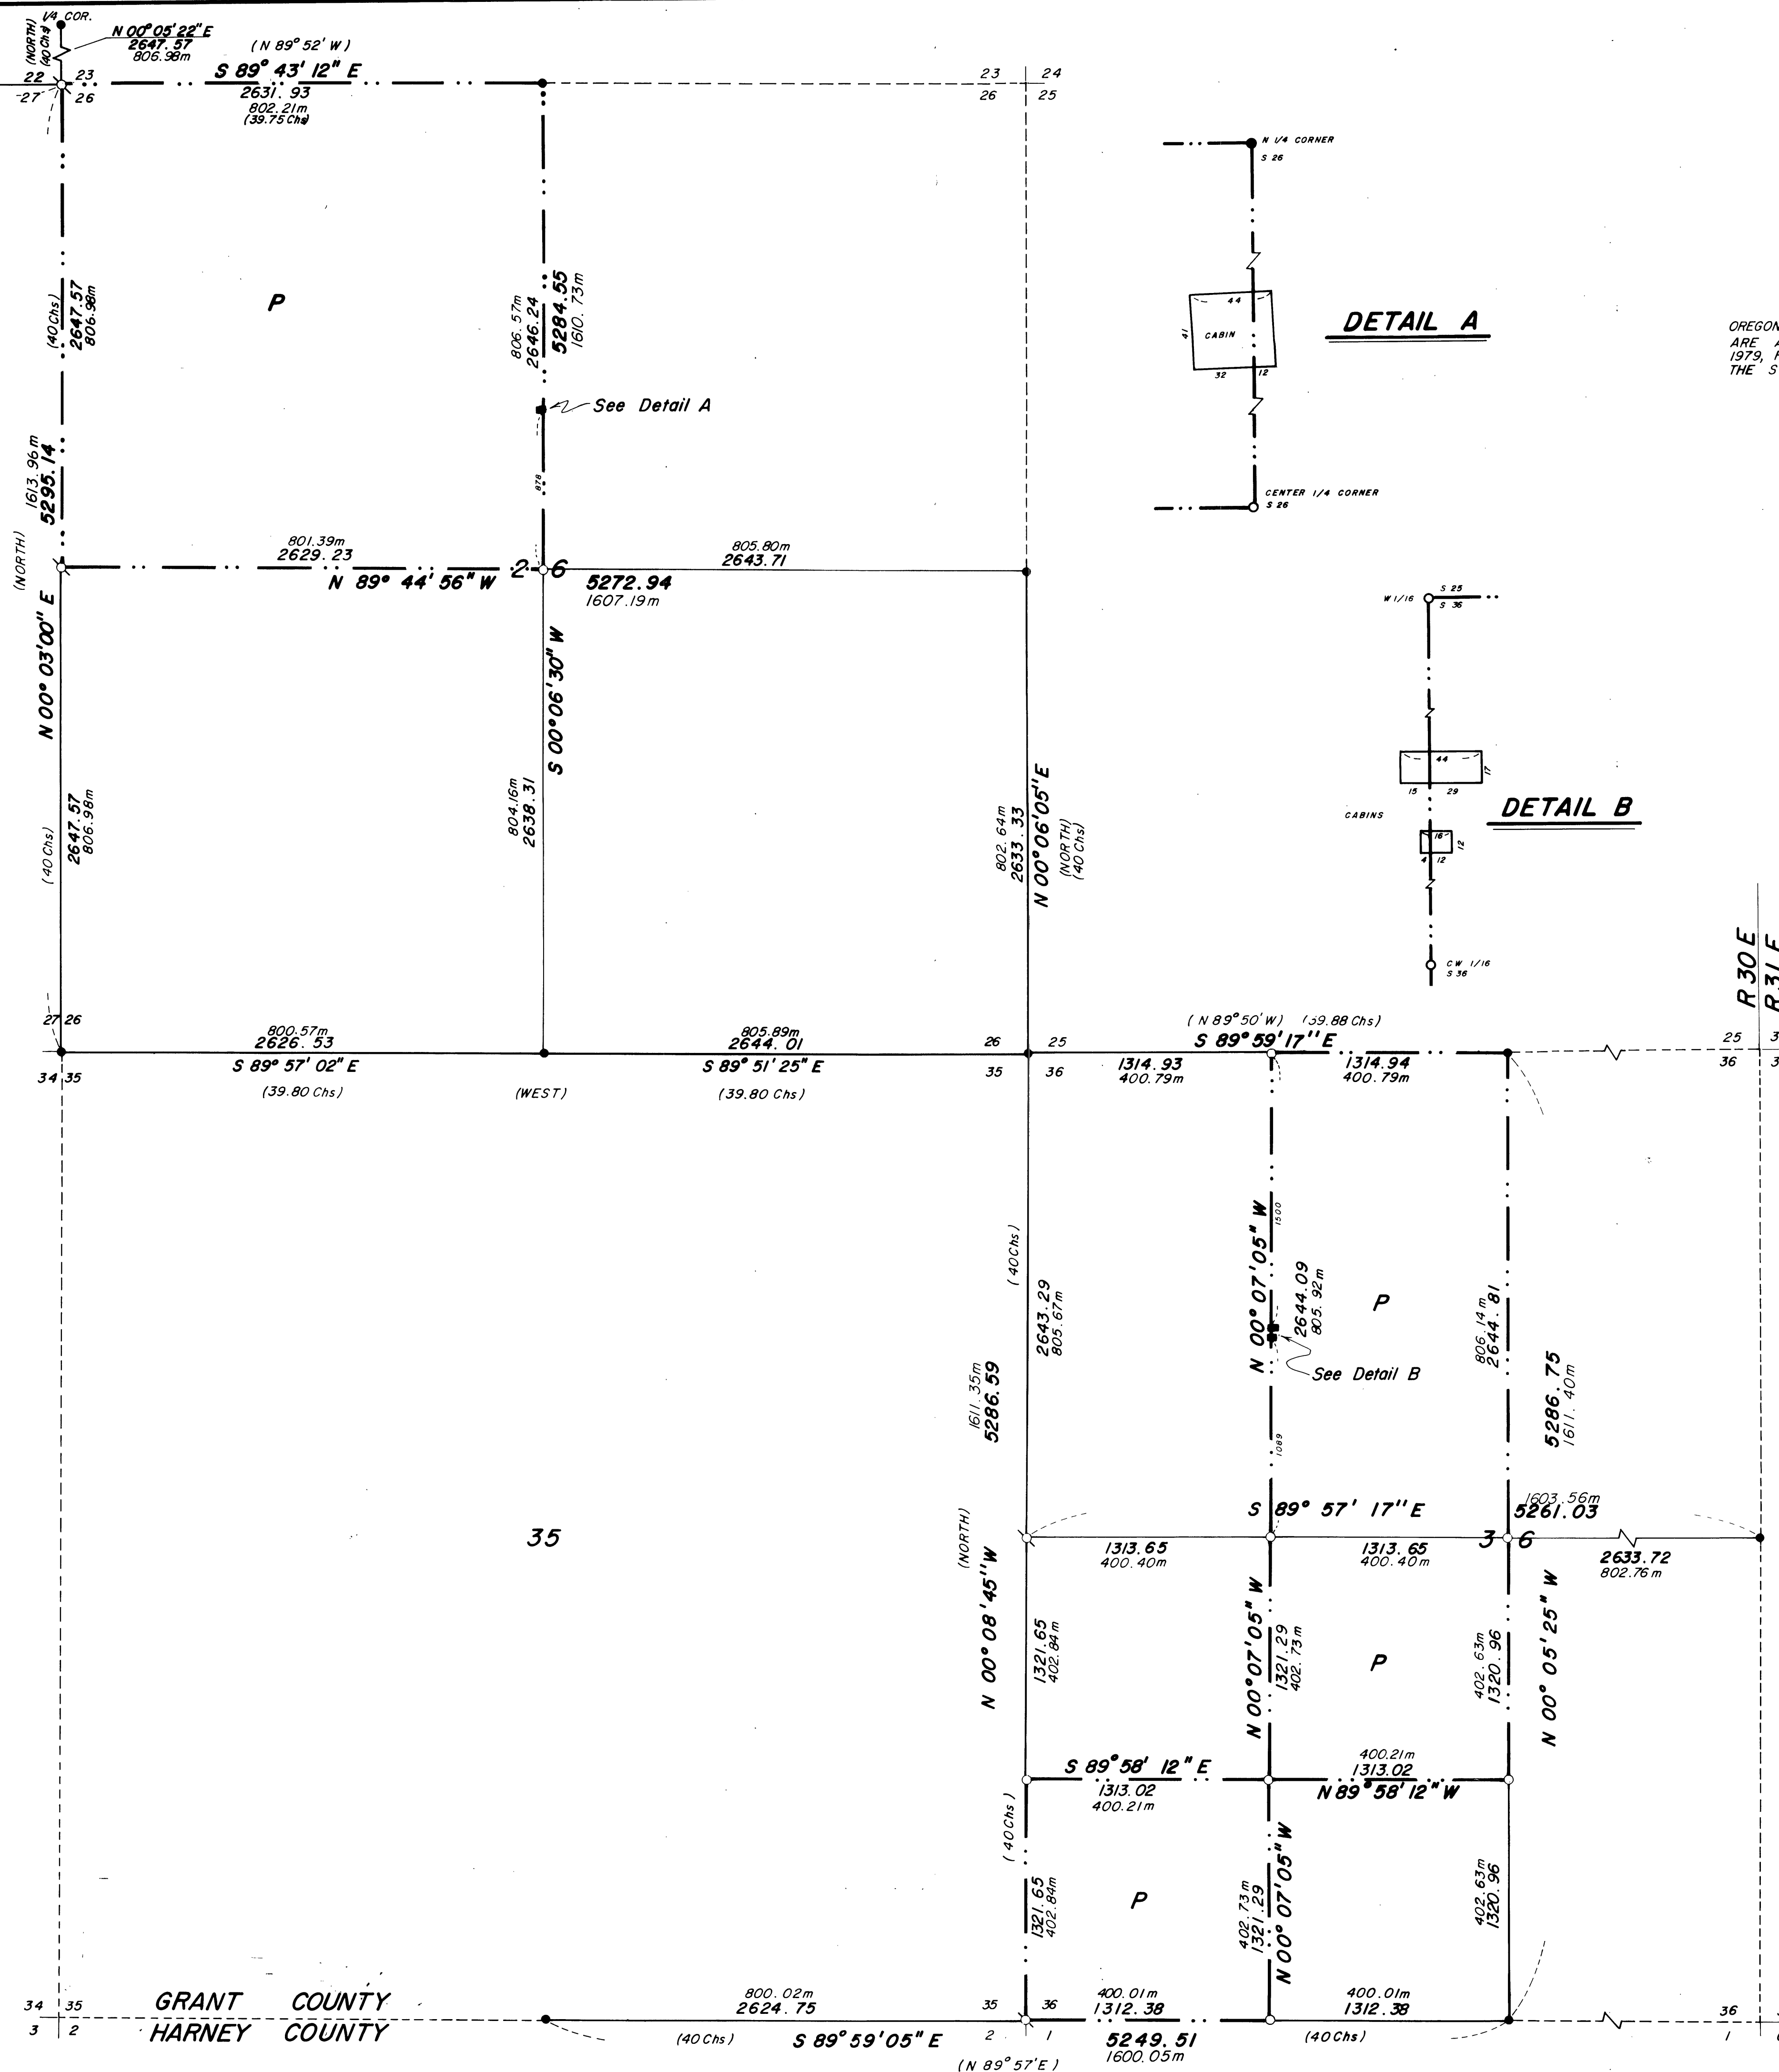

SURVEYOR'S STATEMENT

I, DUANE I. GRIFFITH, REGISTERED LAND SURVEYOR IN THE STATE OF OREGON, HEREBY CERTIFY THAT THIS PLAT AND THE NOTES HEREON, OR ATTACHED, ARE A CORRECT REPRESENTATION OF THE SURVEY I MADE DURING JUNE 1979, FOR THE U.S. FOREST SERVICE, IN ACCORDANCE WITH THE STATUTES OF THE STATE OF OREGON AND WITH THE ARTICLES OF MY CONTRACT.

Duane I. Griffith
PLS 644



LEGEND

- FOUND MONUMENT OF RECORD
- SEARCHED FOR DID NOT FIND ORIGINAL CORNER
SET 2 1/2" X 30" IRON PIPE WITH BRASS CAP AT PROPORTIONATE DISTANCE
- SET 2 1/2" X 30" IRON PIPE WITH BRASS CAP
- () GLO RECORD BEARING & DISTANCE
- 803.00m METRIC DISTANCE
- P PRIVATELY OWNED LANDS
- FOREST SERVICE BOUNDARY

NOTE

FOR MONUMENTATION RECORDS OF CORNERS FOUND & SET, SEE MONUMENTATION SHEETS FILED SEPARATELY.

REFERENCE MATERIAL

G.L.O. FIELD NOTES
GRANT COUNTY SURVEY RECORDS

BAGETT, GRIFFITH & ASSOCIATES		
John Day, Oregon		
Map of Survey		
ESTABLISH FOREST BOUNDARY		
SECTIONS 23-25-26-27-35-36		
T 18 S, R 30 E, W.M.		
GRANT COUNTY, OREGON		
SURVEYED FOR	MALHEUR NATIONAL FOREST	
SURVEYED BY	DIG	6/79
Scale: 1" = 500	Drawn by: DDS:TDG	7/79