
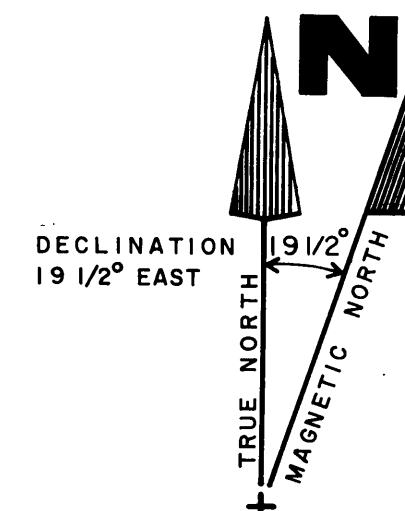


TOWNSHIP 8 SOUTH, RANGE 31,32 EAST, W. M. GRANT COUNTY, OREGON

DEPENDENT RE-SURVEY, CORNER MONUMENTATION

FROM EXISTING EVIDENCE &
PARTIAL SECTION BREAKDOWN

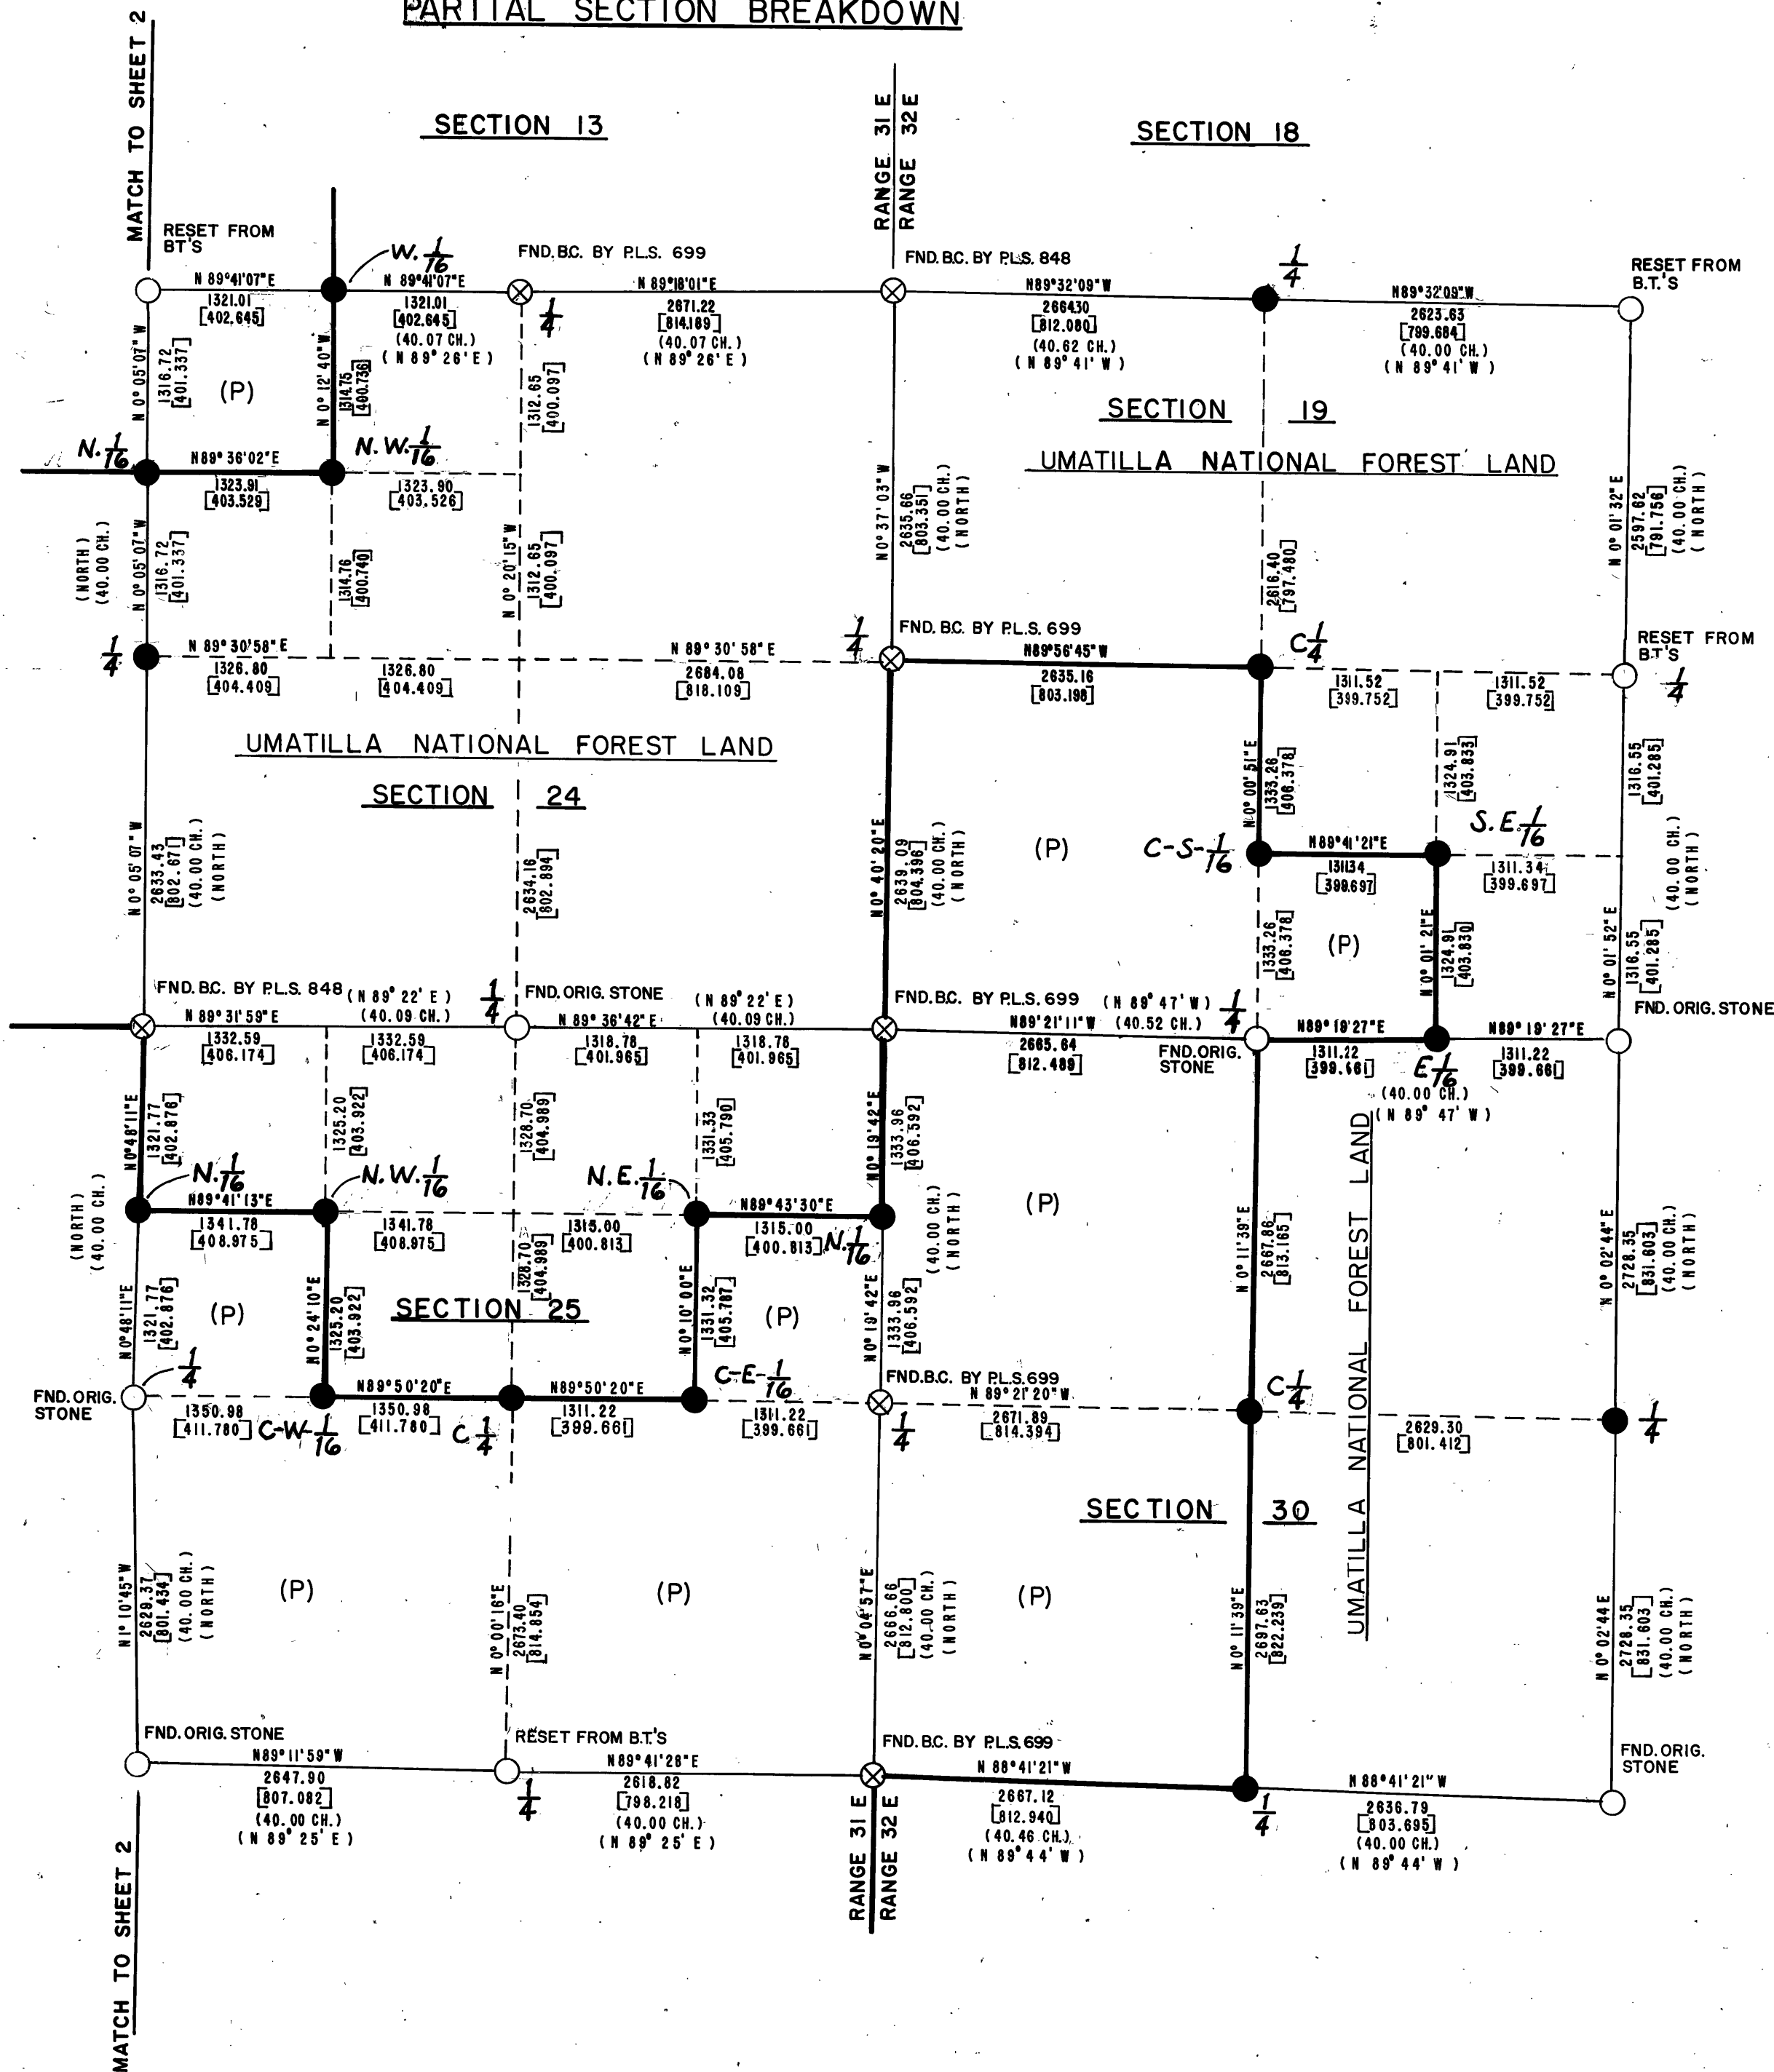

SCALE 1" = 1000'
BASIS OF BEARINGS
for CORNERS
ESTABLISHED
by
TRAVERSE SURVEY:
SOLAR OBSERVATION

SURVEYORS CERTIFICATION:

I, WILLIAM R. WELLS, A REGISTERED PROFESSIONAL LAND SURVEYOR IN THE STATE OF OREGON, HEREBY CERTIFY THAT THIS PLAT AND NOTES HEREON, OR ATTACHED, ARE A CORRECT REPRESENTATION OF A SURVEY PERFORMED UNDER MY DIRECT SUPERVISION DURING THE MONTHS OF SEPTEMBER, OCT. & NOVEMBER 1979 FOR THE U. S. FOREST SERVICE, IN ACCORDANCE WITH THE STATUTES OF THE STATE OF OREGON AND WITH THE ARTICLES OF THE CONTRACT.

William R. Wells
WILLIAM R. WELLS, P.L.S.
OREGON LICENSE NO. 1106

REGISTERED
PROFESSIONAL
LAND SURVEYOR

William R. Wells
OREGON
JULY 22, 1977
WILLIAM R. WELLS
1106

LEGEND

- SET 2" I.D. GALV. IRON PIPE 30" LONG WITH 2 1/2" BRASS CAP FROM EXISTING EVIDENCE
- SET 2" I.D. GALV. IRON PIPE 30" LONG WITH 2 1/2" BRASS CAP BY TRAVERSE SURVEY
- HEAVY LINES INDICATE U. S. FOREST BOUNDARY
- [1.234] MEASURED DISTANCE IN METERS.
- ⊗ FOUND EXISTING EVIDENCE AS NOTED
- (P) INDICATES PRIVATE OWNERSHIP

NOTES

ALL BEARINGS & DISTANCES IN PARENTHESIS ARE RECORD BEARINGS AND DISTANCES
FOR ADDITIONAL INFORMATION ON CORNERS RECOVERED OR RE-ESTABLISHED, SEE CERTIFIED RECORD OF LAND CORNER MONUMENTATION FILED HEREWITH
FIELD BOOK REFERENCE - TRAVERSE AND MONUMENTATION BOOK(S)-TRAV. NO. 17 THROUGH 24 AND MONUMENTATION NO. 5 OF SOUTH HALF '79 CADASTRAL SURVEY

RECEIVED AND
FILED

JAN 9 1980
OFFICE OF COUNTY SURVEYOR
Robert D. Burt
Hester & Lemmie Lawrence

WALLULIS PROJECT NO:
79-111
AGENCY PROJECT NO:
U. S. F. S.
CONTRACT NO.
53-04H1-9-7409N

PROJECT:
SOUTH HALF '79
CADASTRAL SURVEY
PERFORMED FOR
U. S. FOREST SERVICE
UMATILLA
NATIONAL FOREST

WALLULIS & ASSOCIATES, INC.
ENGINEERING & PLANNING
108 EAST MAIN
PENDLETON, OREGON 97801
503-276-4598
HERMISTON, OREGON 97838
503-567-3331

SCALE: 1" = 1000'
DATE: 12-14-79
DES BY:
DR BY: C.A.A.
CK BY: W.R.W.

TITLE:
GRANT COUNTY, OREGON
TWP 8 S; R31,32E; W.M.

REVISIONS

DRAWING: