
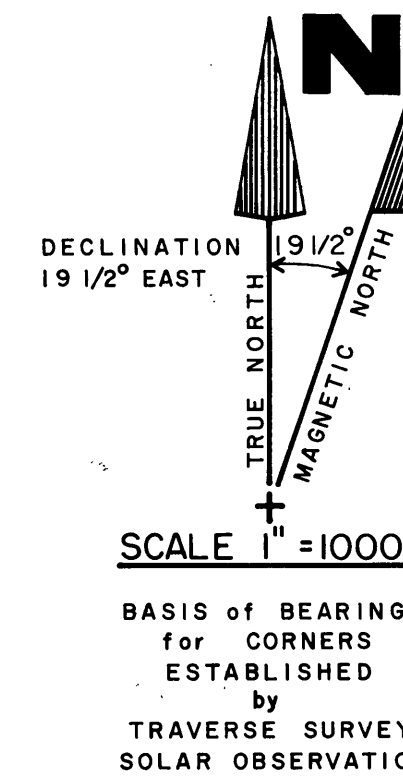


TOWNSHIP 8 SOUTH, RANGE 31 EAST, W.M.
DEPENDENT RE-SURVEY, CORNER MONUMENTATION
FROM EXISTING EVIDENCE &
PARTIAL SECTION BREAKDOWN

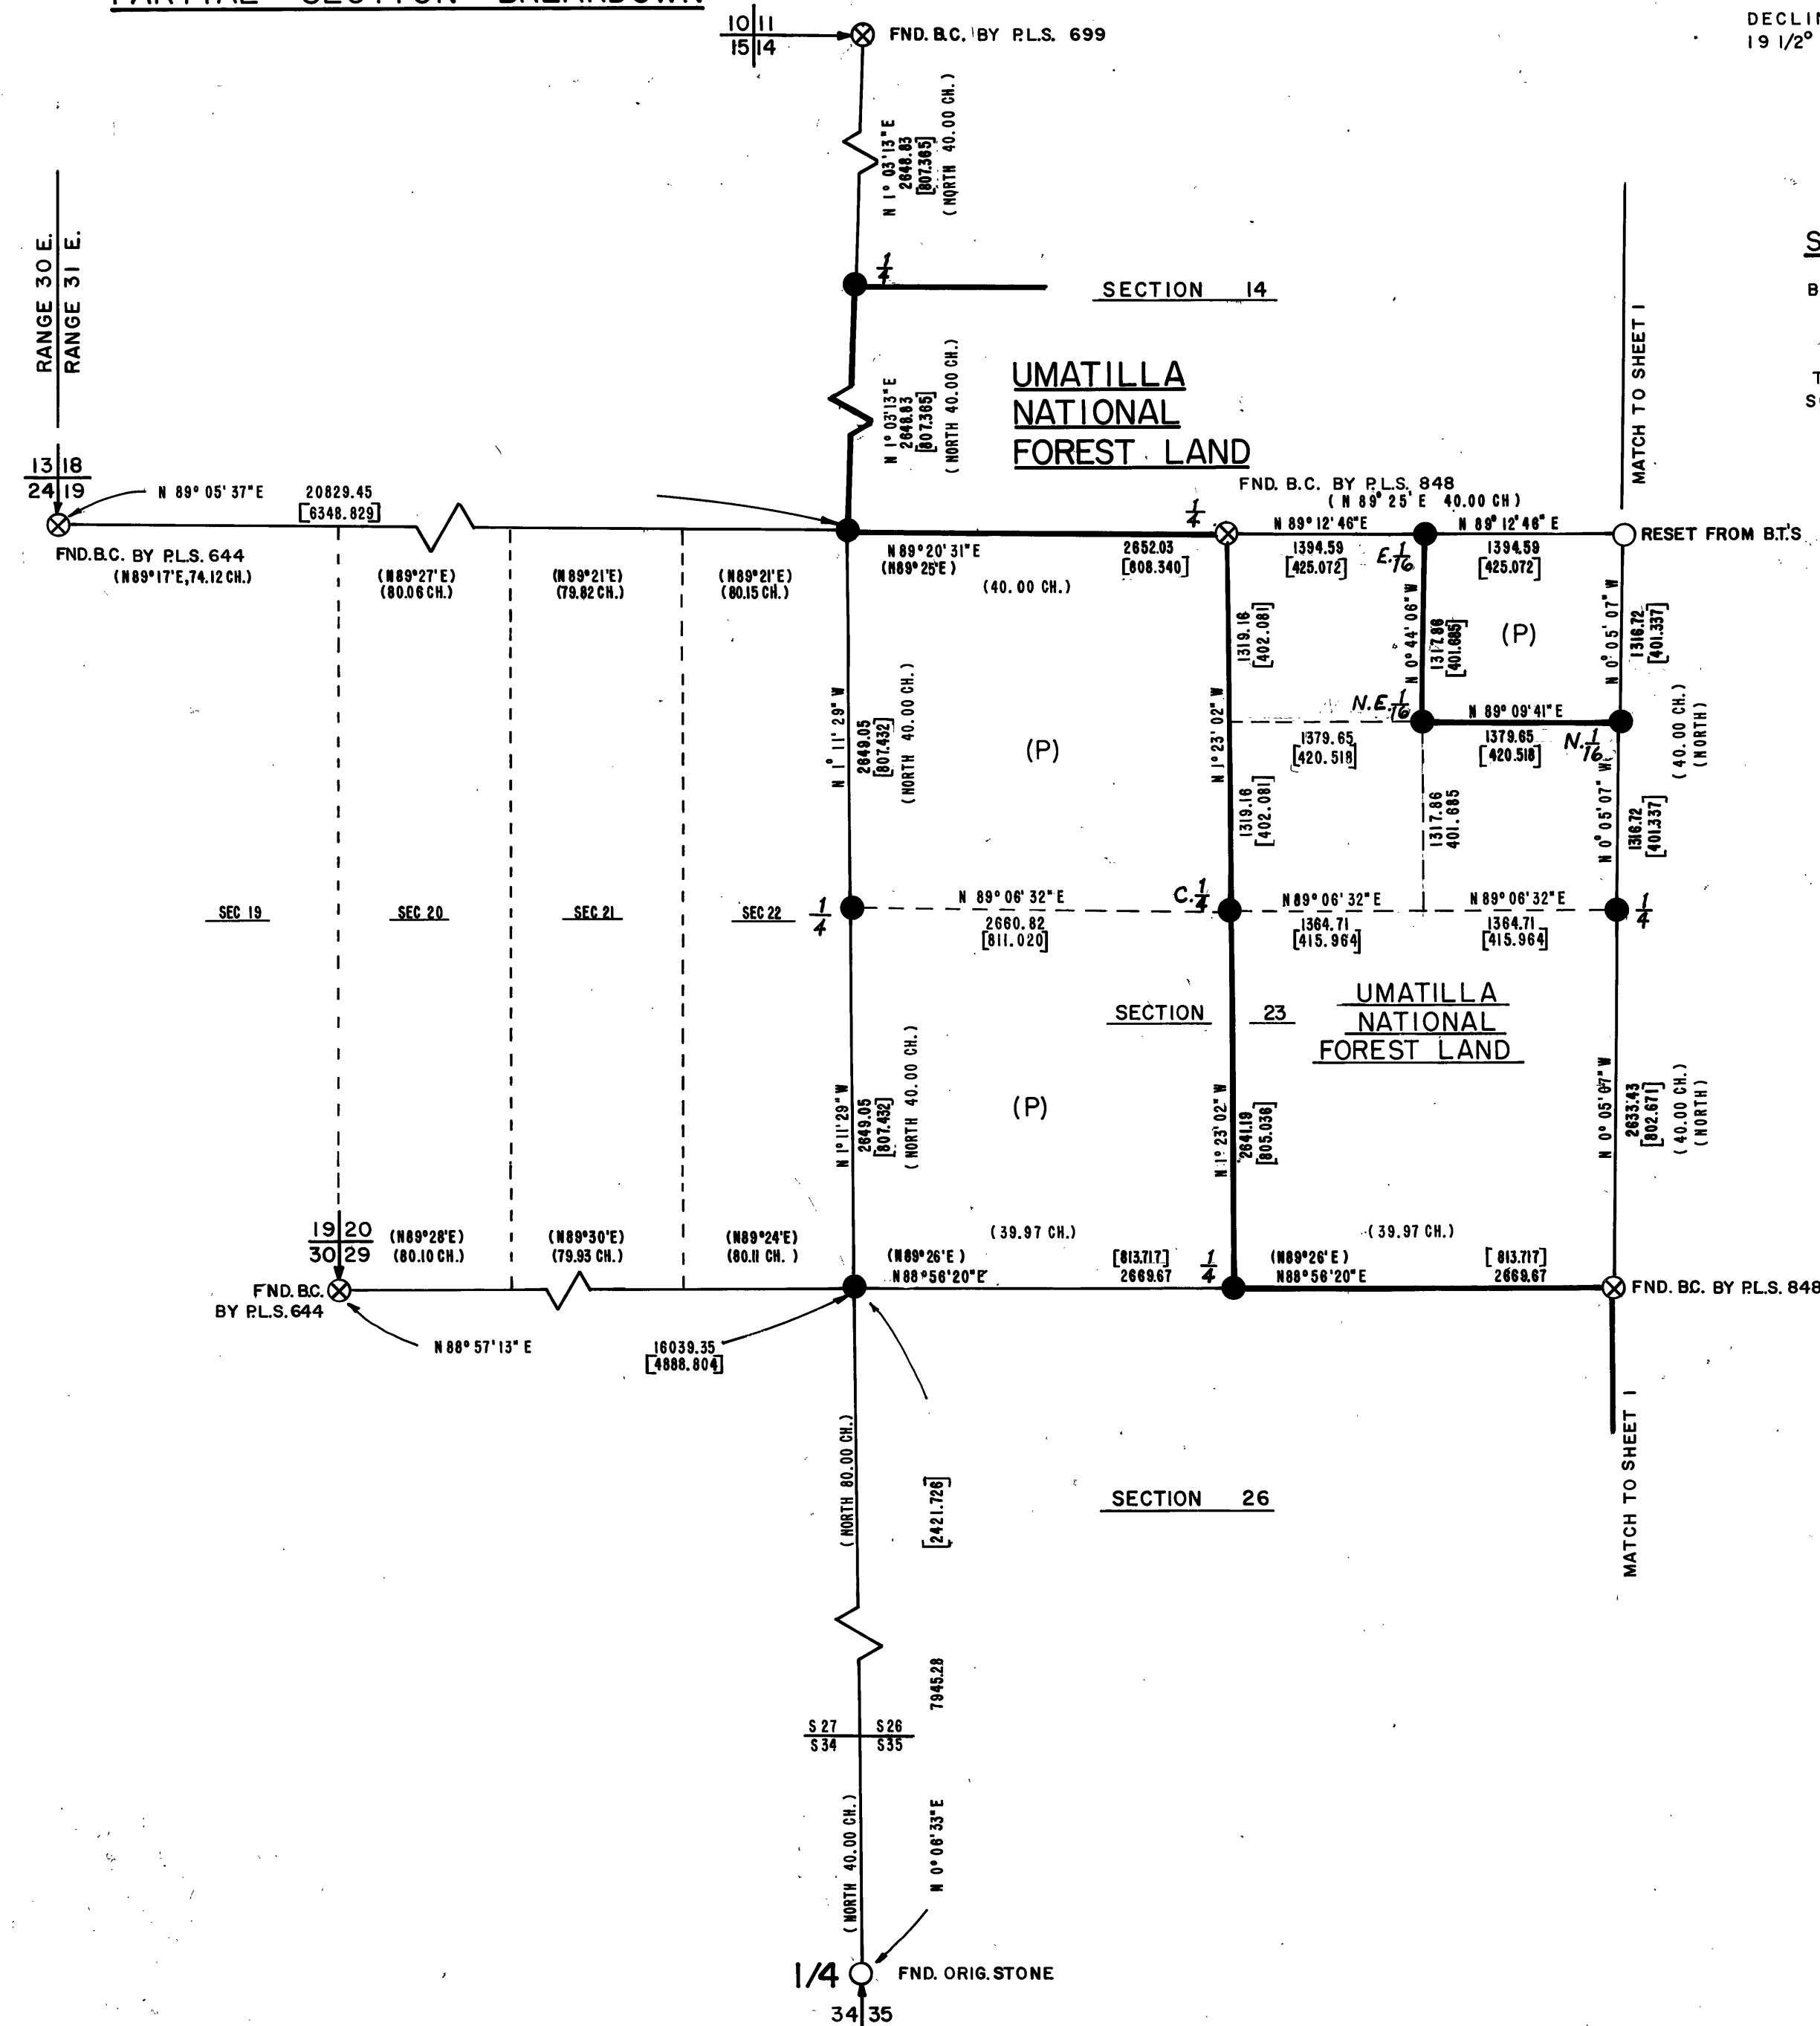

SURVEYORS CERTIFICATION:

I, WILLIAM R. WELLS, A REGISTERED PROFESSIONAL LAND SURVEYOR IN THE STATE OF OREGON, HEREBY CERTIFY THAT THIS PLAT AND NOTES HEREON, OR ATTACHED, ARE A CORRECT REPRESENTATION OF A SURVEY PERFORMED UNDER MY DIRECT SUPERVISION DURING THE MONTHS OF SEPT., OCT., & NOV. 1979 FOR THE U. S. FOREST SERVICE, IN ACCORDANCE WITH THE STATUTES OF THE STATE OF OREGON AND WITH THE ARTICLES OF THE CONTRACT.

William R. Wells

WILLIAM R. WELLS, P.L.S.
OREGON LICENSE No. 1106

REGISTERED
PROFESSIONAL
LAND SURVEYOR

William R. Wells

OREGON
JULY 22, 1977
WILLIAM R. WELLS
1106

LEGEND

- SET 2" I.D. GALV. IRON PIPE 30" LONG WITH 2 1/2" BRASS CAP FROM EXISTING EVIDENCE
- SET 2" I.D. GALV. IRON PIPE 30" LONG WITH 2 1/2" BRASS CAP BY TRAVERSE SURVEY
- HEAVY LINES INDICATE U. S. FOREST BOUNDARY
- [1.234] MEASURED DISTANCE IN METERS
- ⊗ FOUND EXISTING EVIDENCE AS NOTED
- (P) INDICATES PRIVATE OWNERSHIP

NOTES

ALL BEARINGS & DISTANCES IN PARENTHESIS ARE RECORD BEARINGS AND DISTANCES
FOR ADDITIONAL INFORMATION ON CORNERS RECOVERED OR RE-ESTABLISHED, SEE CERTIFIED RECORD OF LAND CORNER MONUMENTATION FILED HEREWITH

FIELD BOOK REFERENCE - TRAVERSE AND MONUMENTATION BOOK(S)-TRAV. NO. 17 THROUGH 24 AND MONUMENTATION NO. 5 OF SOUTH HALF '79 CADASTRAL SURVEY

RECEIVED AND
FILED

JAN 9 1980

OFFICE OF COUNTY SURVEYOR

Robert D. [Signature]

Assistant Surveyor

WALLULIS PROJECT NO:

79-111

PROJECT:

SOUTH HALF '79

CADASTRAL SURVEY

WALLULIS & ASSOCIATES, INC.

ENGINEERING & PLANNING

SCALE: 1" = 1000'

DATE: 11-26-79

DES BY:

DR BY:

CK BY:

C.A.A.

W.R.W.

TITLE:

GRANT COUNTY, OREGON
TWP 8 S., RANGE 31 E., W.M.

REVISIONS

DRAWING:

SHEET 2 OF 2