


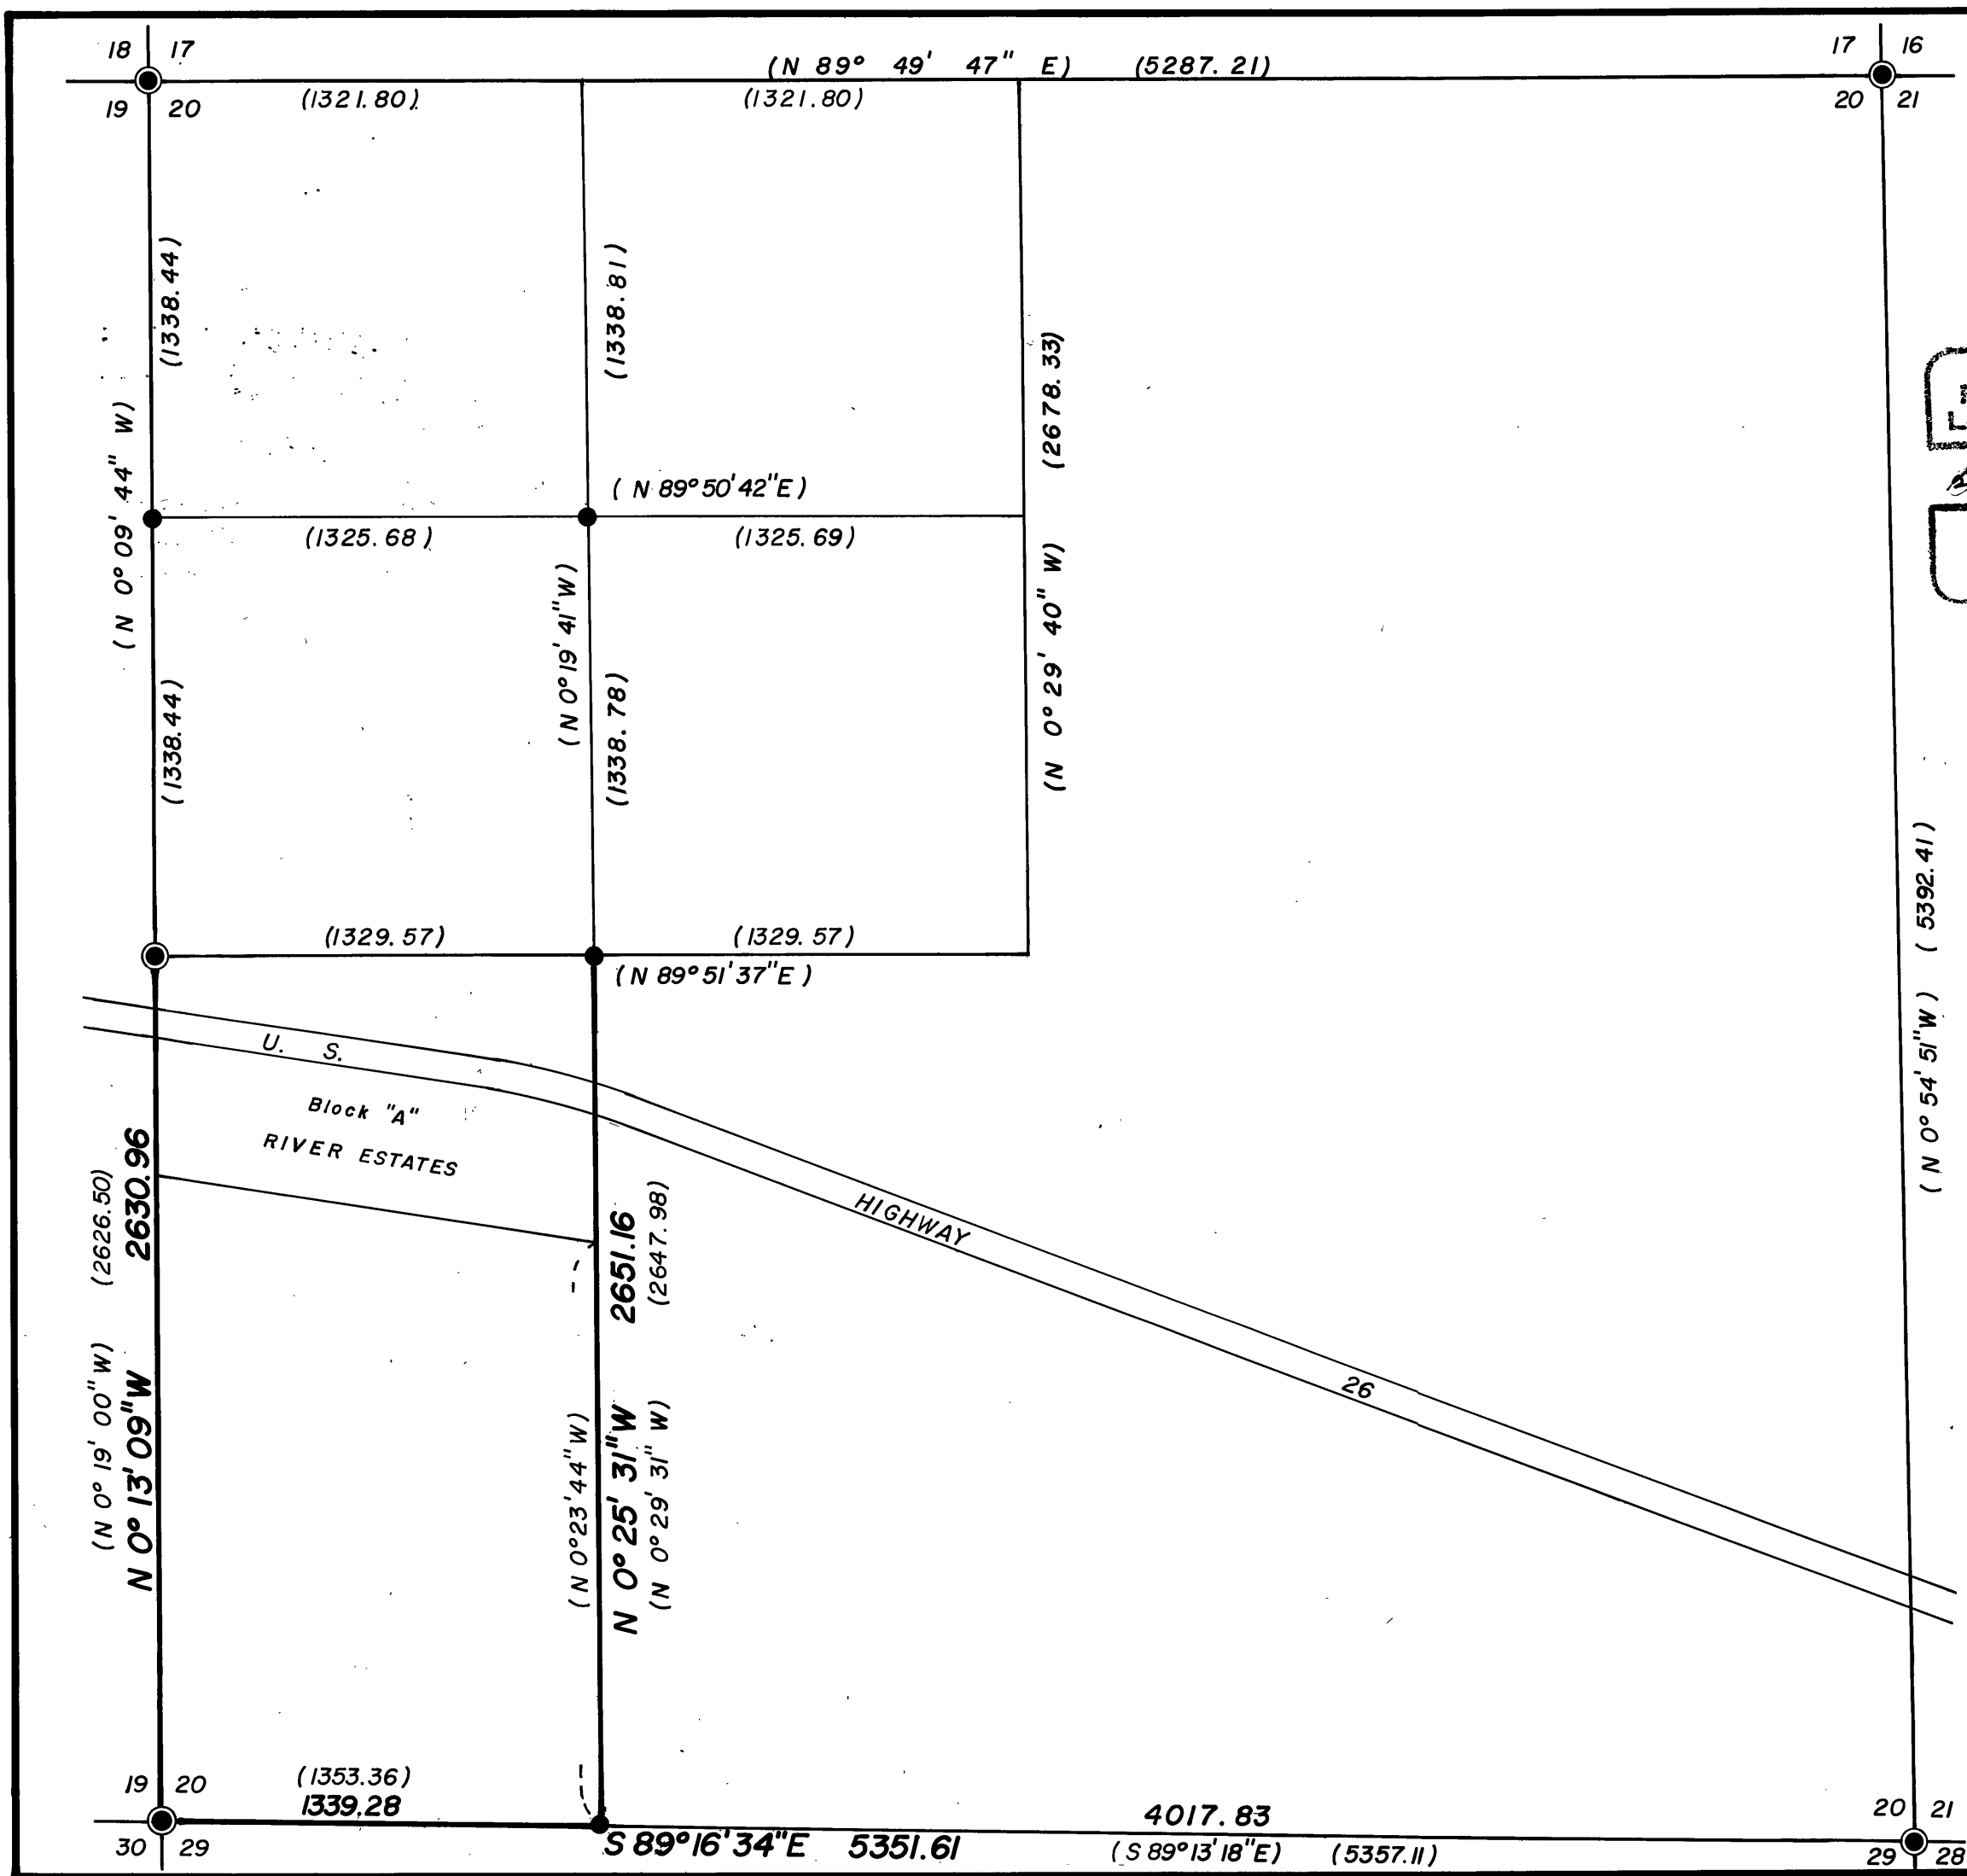

CORRECTION MAP

OF SURVEY NO. 156
NO PINS SET THIS SURVEY

REGISTERED
PROFESSIONAL
LAND SURVEYOR

Duane I. Griffith

OREGON
JULY 10, 1964
DUANE I. GRIFFITH
644

RECEIVED AND
FILED

FEB 6 - 1980

OFFICE OF COUNTY SURVEYOR

Robert D. Baggett
Attest: *Samuel Lawrence*

BASIS OF BEARINGS
MAP OF SURVEY NO. 156

REFERENCES

MAP OF SURVEY NO. 510
MAP OF SURVEY NO. 511
MAP OF SURVEY NO. 156

LEGEND

- BRASS CAP MONUMENT OF RECORD
- MONUMENT OF RECORD
- () RECORD BEARING AND DISTANCE

BAGETT, GRIFFITH & ASSOCIATES

John Day, Oregon

Map of Survey

To Correct Bearings & Distances
As Shown
in

SECTION 20, T 13 S, R 29 E, W.M.
GRANT COUNTY, OREGON

SURVEYED FOR	JOHN KALITA	
SURVEYED BY	d.i.g. - r.d.b.	2/80
Scale: 1" = 500'	Drawn by: d.i.g.	2/80

MAP OF SURVEY NO. 601