
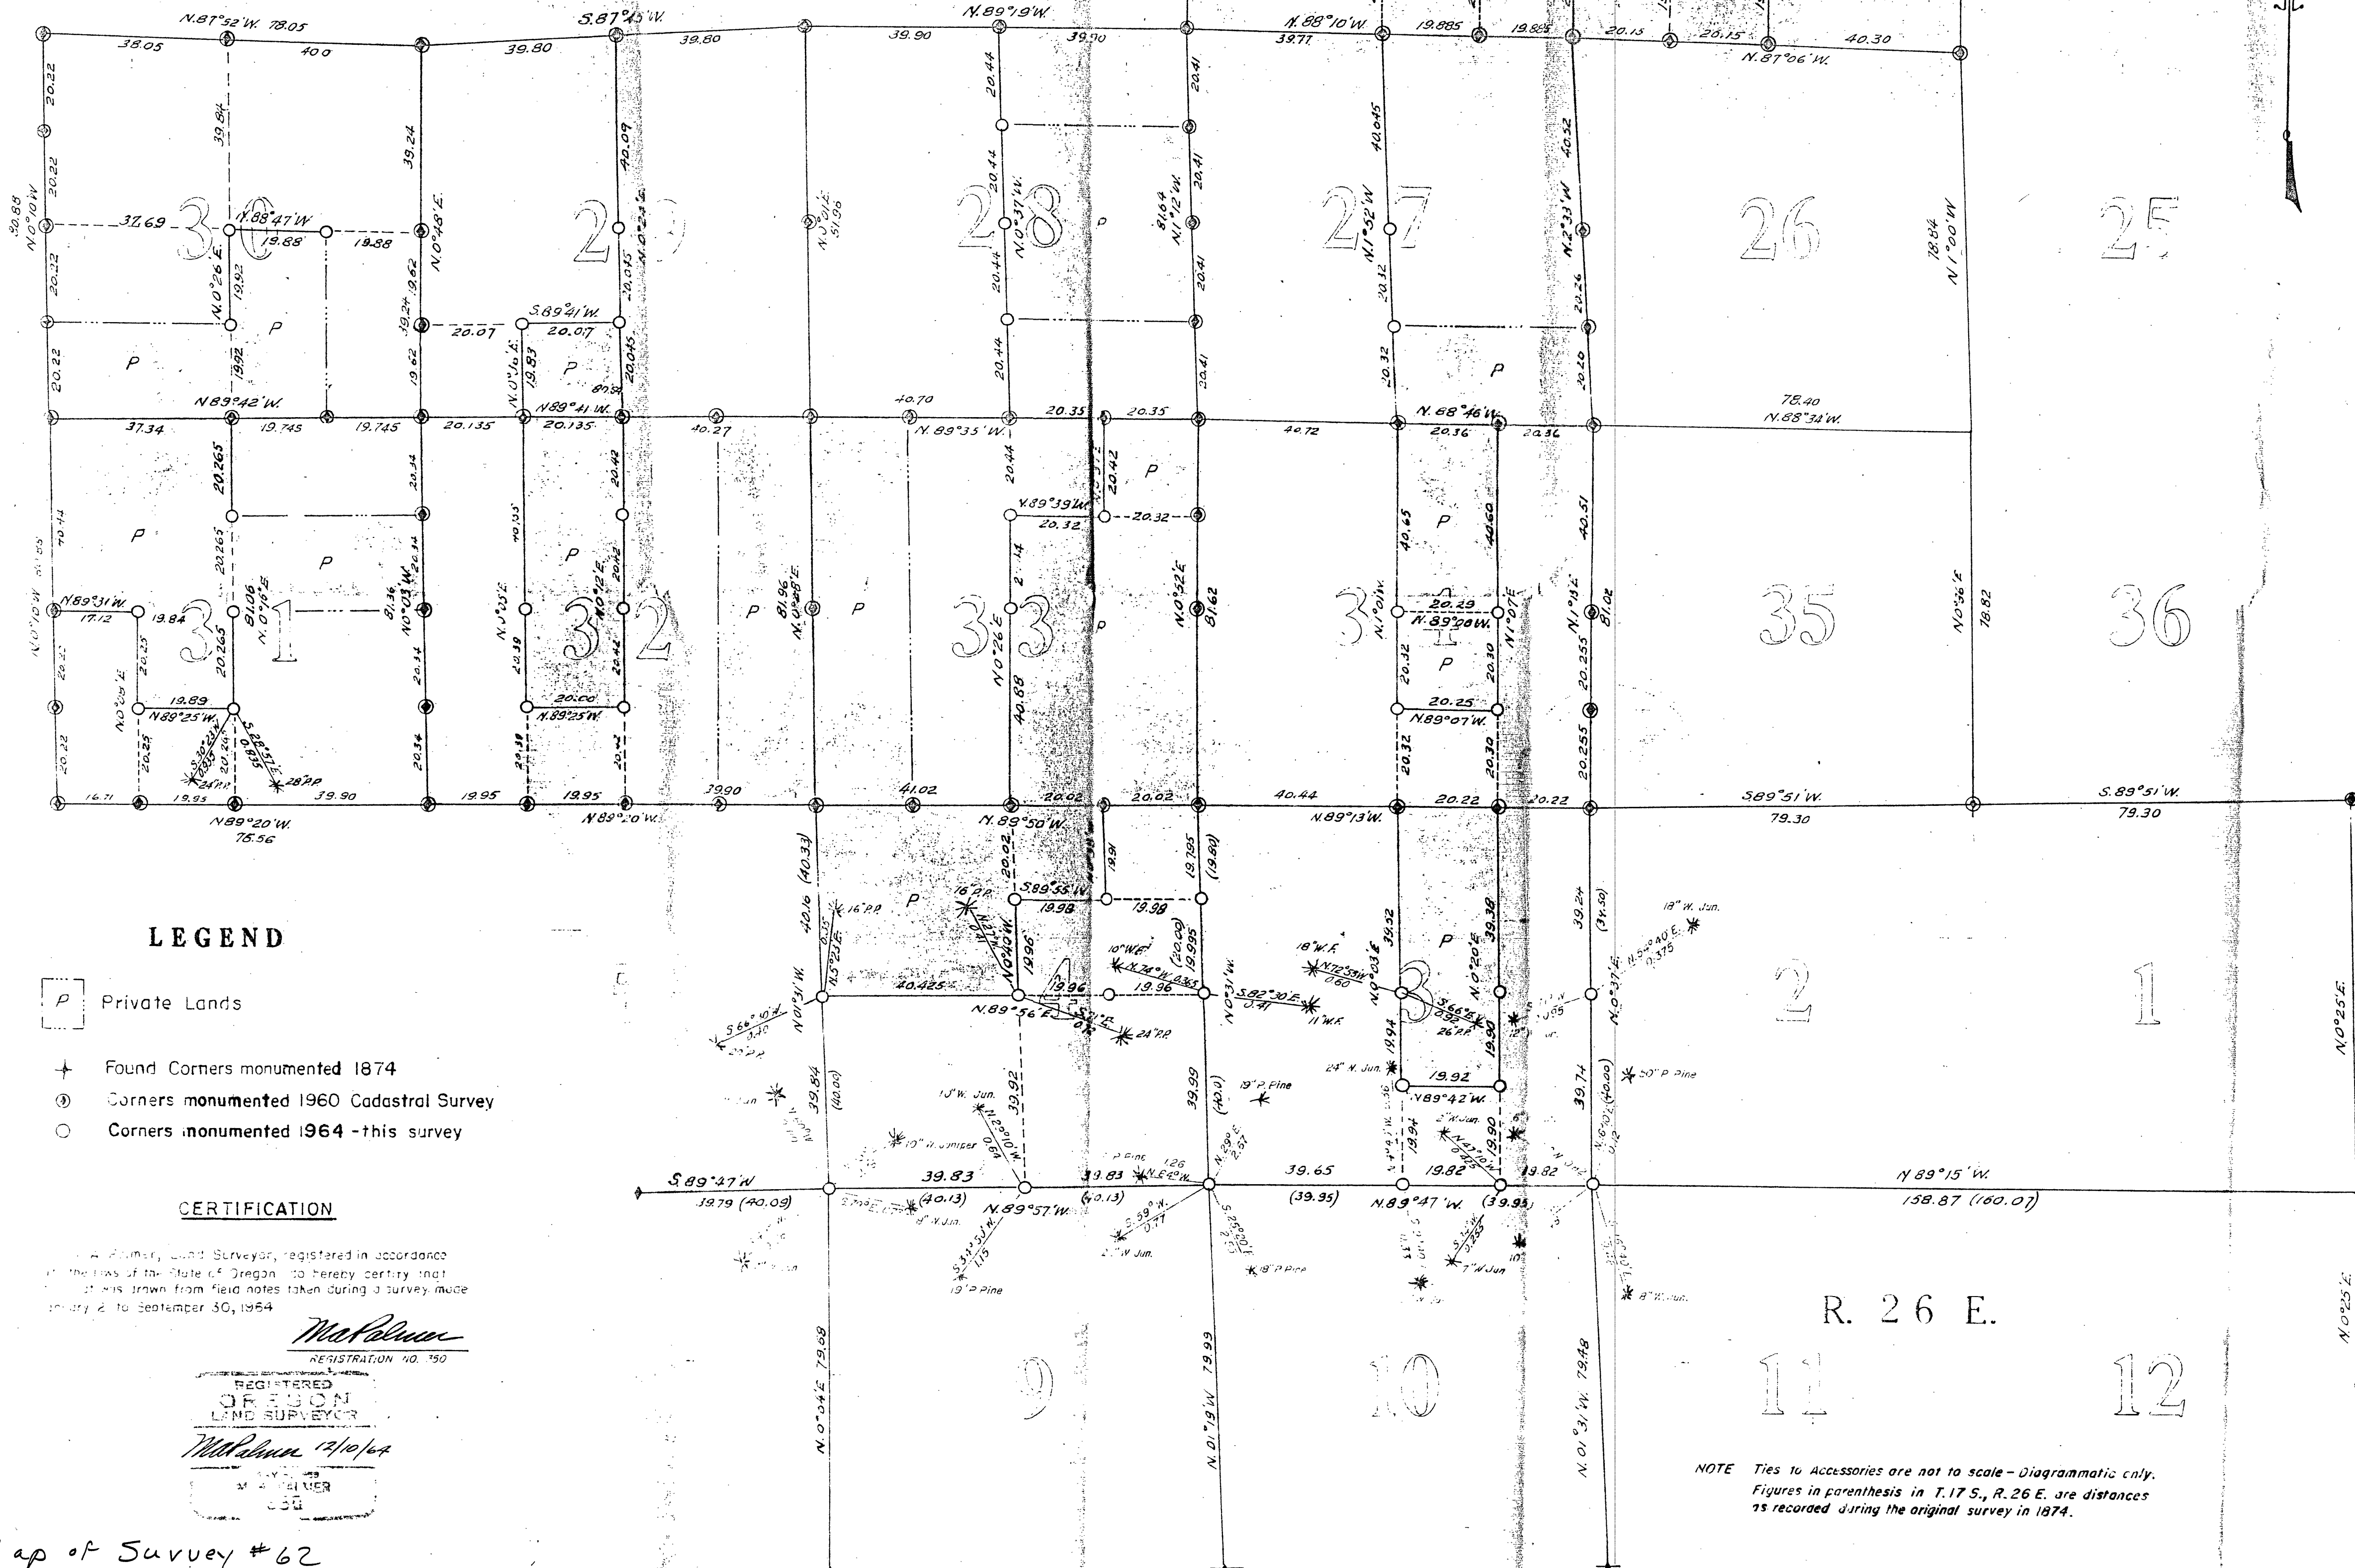
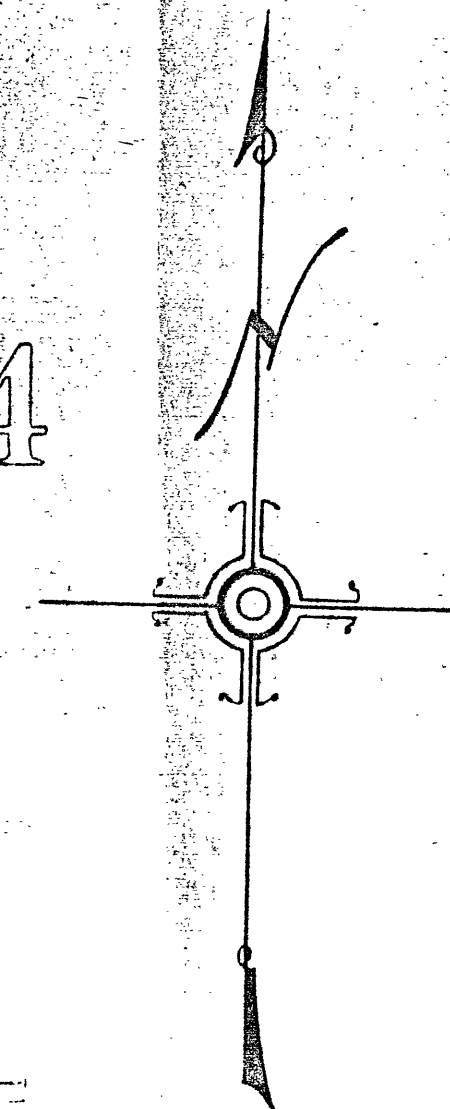


OCHOCO NATIONAL FOREST 1964 LINE SURVEY PROJECT SUNFLOWER AREA

PORTIONS OF T. 16 E-17 S., R. 26 E., W. M.

SCALE

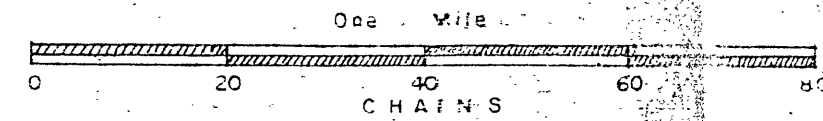

LEGEND

- P Private Lands
- + Found Corners monumented 1874
- ⊙ Corners monumented 1960 Cadastral Survey
- Corners monumented 1964 - this survey

CERTIFICATION

I, *W. A. Palmer*, Land Surveyor, registered in accordance with the laws of the State of Oregon, do hereby certify that this map was drawn from field notes taken during a survey made on July 2 to September 30, 1964.

W. A. Palmer
REGISTERED
OREGON
LAND SURVEYOR
L.S.S.

Map of Survey #62

NOTE Ties to Accessories are not to scale - Diagrammatic only.
Figures in parenthesis in T. 17 S., R. 26 E. are distances as recorded during the original survey in 1874.