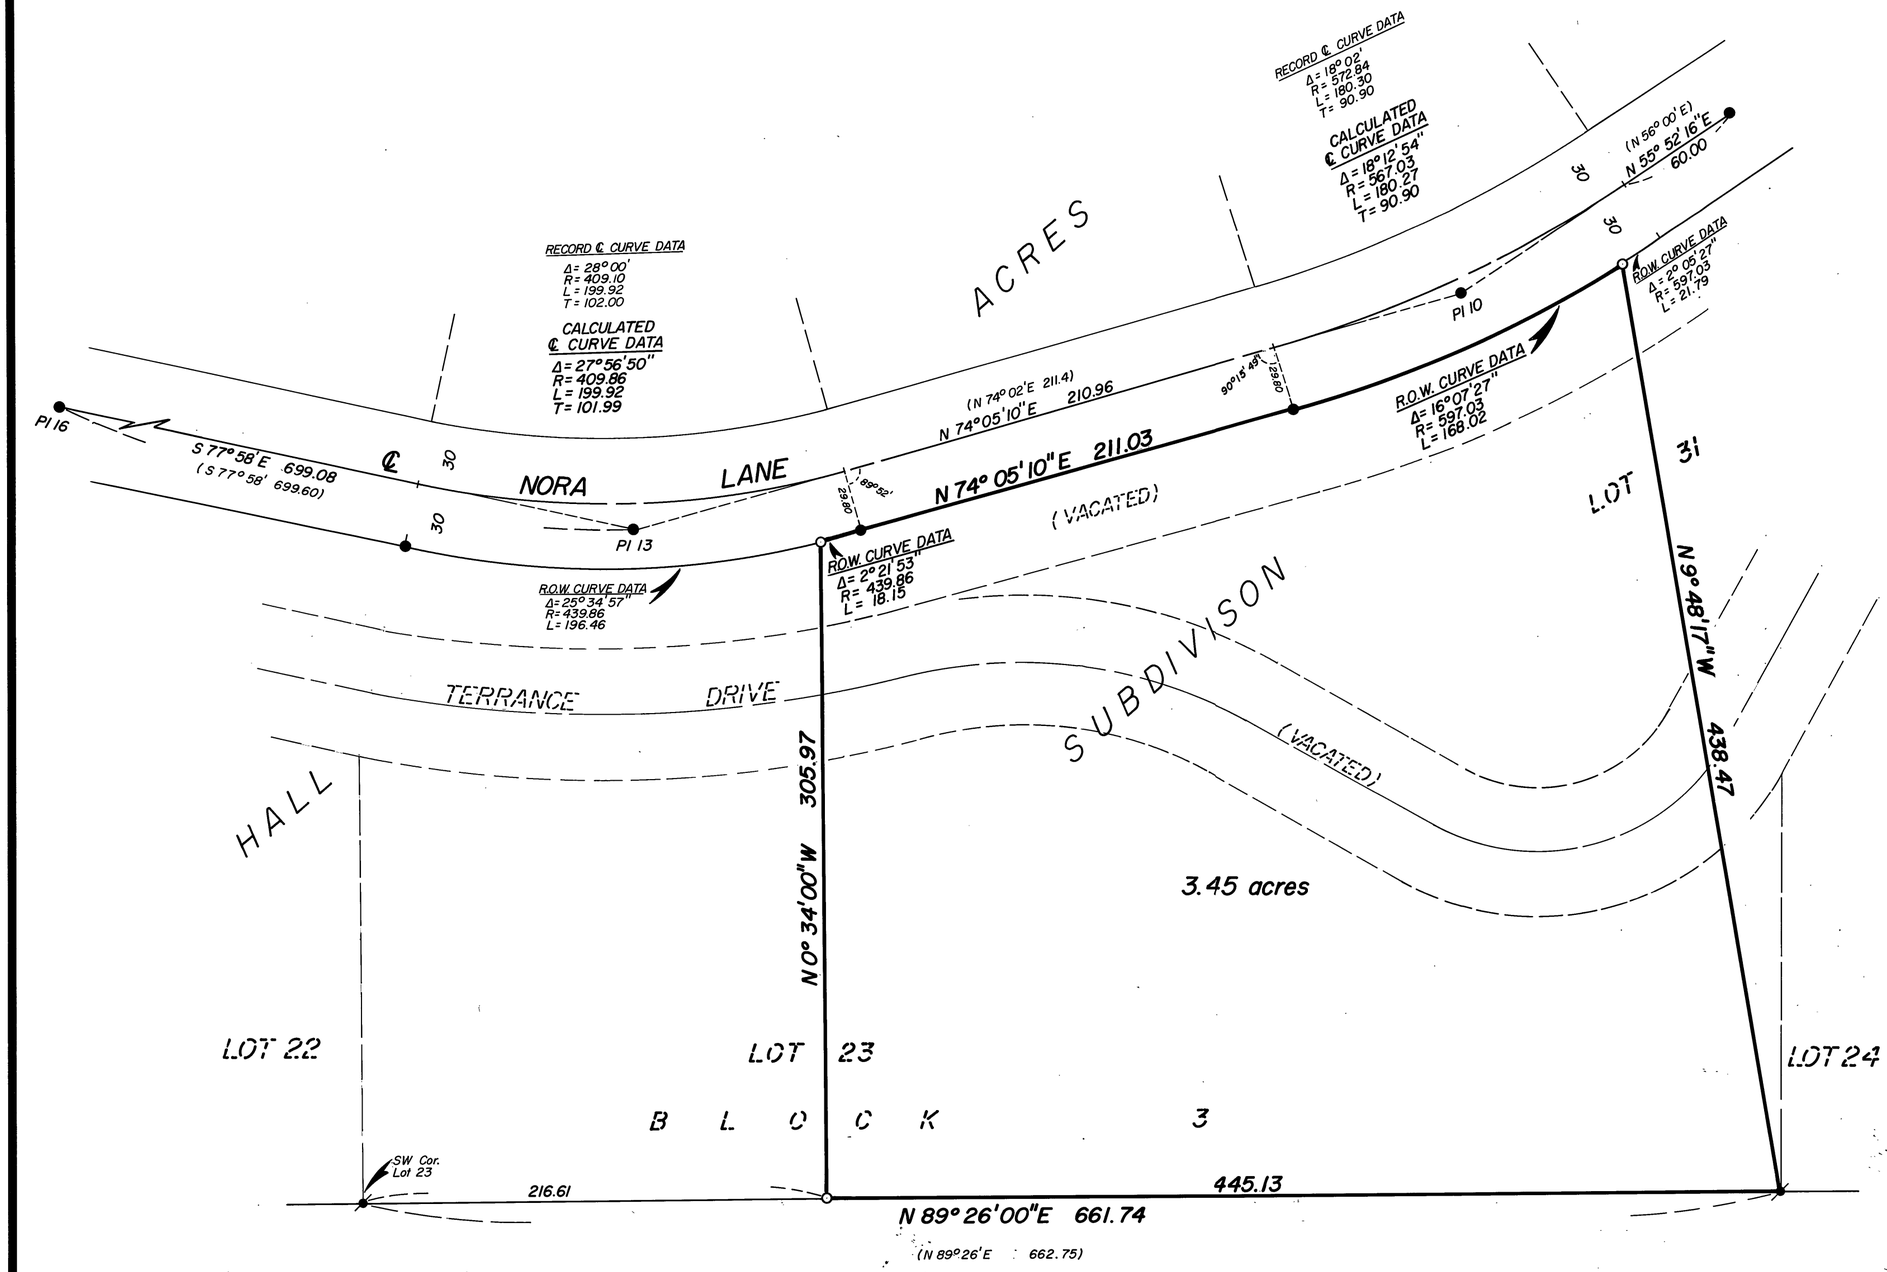

BASIS OF BEARINGS

HALL ACRES SUB'D PLAT

RECORD BEARING FROM ℄ PI 13 TO ℄ PI 16

LEGEND

- FOUND 1/2" IRON PIN MONUMENT OF RECORD.
- FOUND 5/8" IRON PIN MONUMENT OF RECORD.
- SET 5/8" x 30" IRON PIN
- ( ) RECORD BEARING & DISTANCE

REFERENCES

HALL ACRES SUBDIVISON PLAT

NARRATIVE: This survey was performed at the request of Dick Zickler to delineate a tract of land from within his property, situated in HALL ACRES SUBDIVISON.

A search was made of available records pertaining to this survey. Field measurements were made to locate existing monuments. New monuments were set in accordance with evidence found as shown hereon.

REGISTERED PROFESSIONAL LAND SURVEYOR
Robert D. Bagett
OREGON
JULY 12, 1963
ROBERT D. BAGETT
598

RECEIVED AND FILED
AUG 22 1980
OFFICE OF COUNTY SURVEYOR
Robert D. Bagett
Attest:

BAGETT - GRIFFITH & ASSOCIATES
John Day Oregon

A TRACT OF LAND SITUATED IN LOTS 23 AND 31 OF BLOCK 3 HALL ACRES SUBDIVISON

GRANT COUNTY, OREGON

SURVEYED FOR	DICK ZICKLER	
SURVEYED BY	R.D.B. & G.L.E.	8/13-14/80
Scale: 1" = 50'	Drawn by: G.L.E.	8/14-15/80

MAP OF SURVEY NO. 622

PORTLAND PRECISION INSTRUMENT