

NOTE: All aluminum caps stamped according to the B.L.M. Manual of Surveying Instructions except township & range is added to 1/16 & 1/64 corners.
All B.T.s Scribed according to B.L.M. Manual.


- Set 2 1/2" x 30" galv. iron pipe w/ brass cap
- Found brass cap monument
- Set 3" x 30" aluminum pipe w/ 1/2" al. cap
- National Forest Bdry. (posted)
- Record bearing & distance



NOTE: See "Certified Record of Land Corner Monumentation" as on file in the office of the Grant Co. Surveyor for complete description of history, description of evidence found and description of monument and accessories established.

BASIS OF BEARINGS

SOLAR OBSERVATION
MEAN MAGNETIC DECLINATION, 19° E

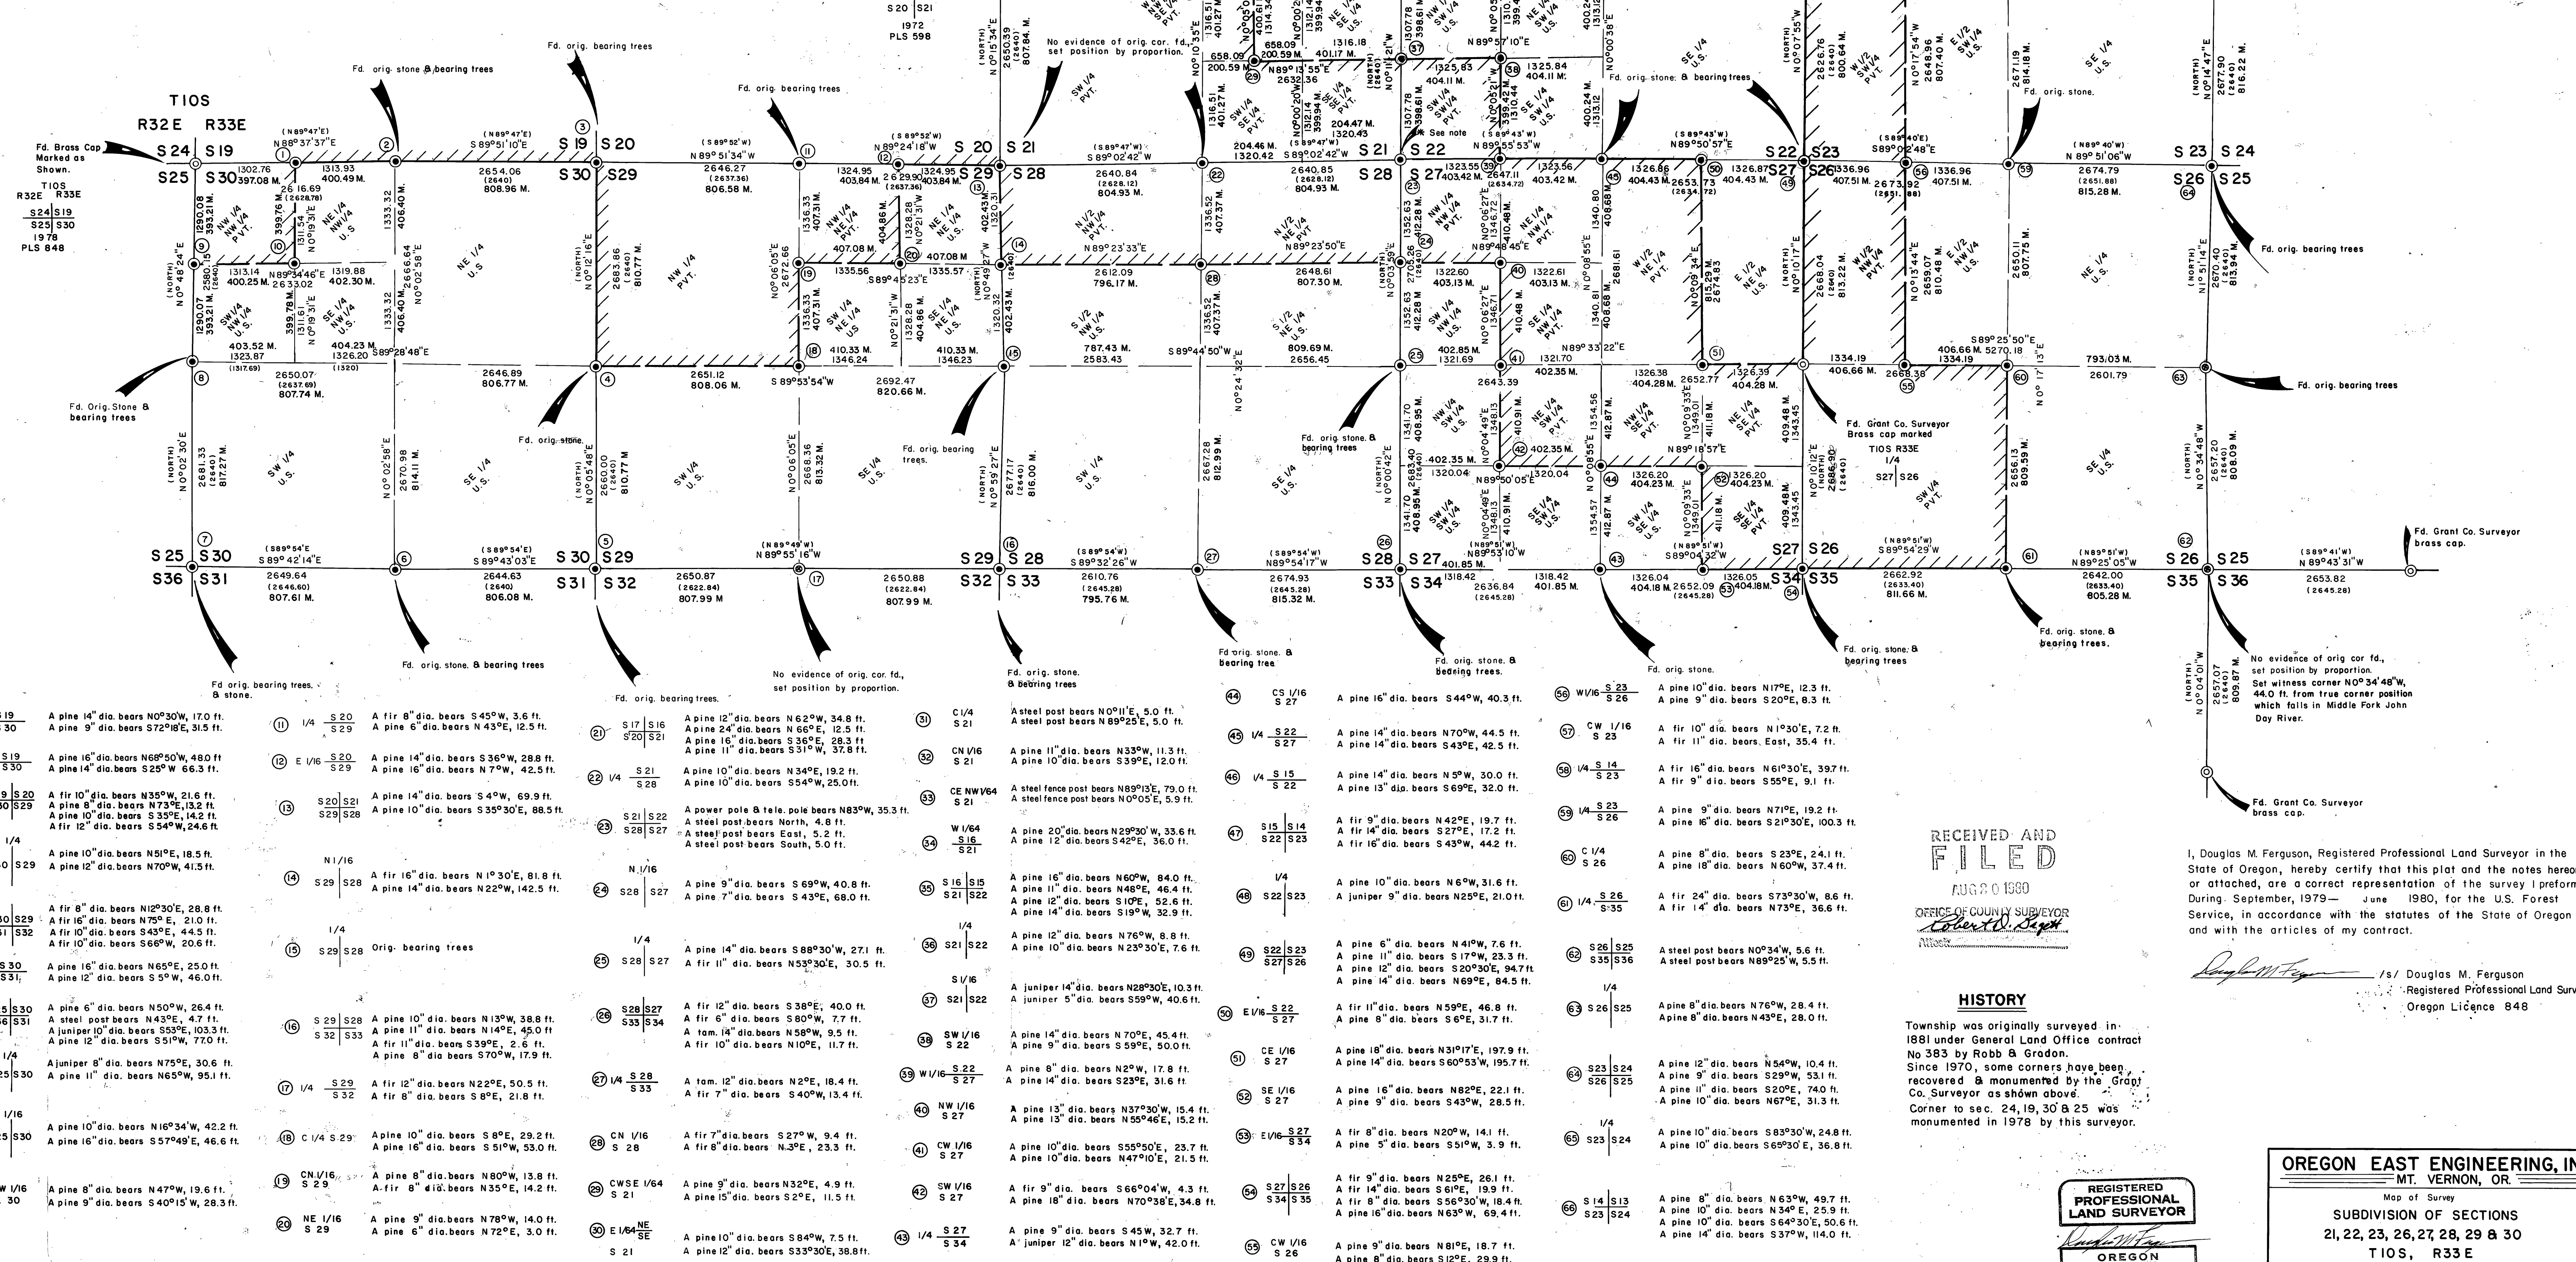

NOTE: Cor. S21 S22 S28 S27

Topog. call, foot of hill 3.18 ch. North & Middle Fork John Day River 0.05 ch. South. When measuring from foot of hill, South 3.18 ch. (taking in to consideration the road) the position is placed on the edge of what appears to have been the old river channel. Since this evidence cannot be overlooked the position of the is placed as follows.
1. A proportion is made East & West.
2. At this dep. position the topog. as described above is found to be corroborative.
3. Lat. position is set from topog. calls N & S.
4. Dep. position is set by proportion to the E & W.

RECEIVED AND FILED
AUG 8 1980
OFFICE OF COUNTY SURVEYOR
Douglas M. Ferguson

HISTORY
Township was originally surveyed in 1881 under General Land Office contract No 383 by Robb & Gradon. Since 1970, some corners have been recovered & monumented by the Grant Co. Surveyor as shown above. Corner to sec. 24, 19, 30 & 25 was monumented in 1978 by this surveyor.

I, Douglas M. Ferguson, Registered Professional Land Surveyor in the State of Oregon, hereby certify that this plat and the notes hereon, or attached, are a correct representation of the survey performed, During September, 1979— June 1980, for the U.S. Forest Service, in accordance with the statutes of the State of Oregon and with the articles of my contract.

/s/ Douglas M. Ferguson
Registered Professional Land Surveyor
Oregon License 848

REGISTERED
PROFESSIONAL
LAND SURVEYOR
Douglas M. Ferguson
JULY 12, 1980
848

OREGON EAST ENGINEERING, INC. MT. VERNON, OR	
Map of Survey SUBDIVISION OF SECTIONS 21, 22, 23, 26, 27, 28, 29 & 30 T10S, R33E	
For: Malheur National Forest	By: DMF
Date: 1979 & 80	Drawing No: Sheet 1 of 1
Scale: 1" = 1000'	Job No: Drawn By J.D.B.