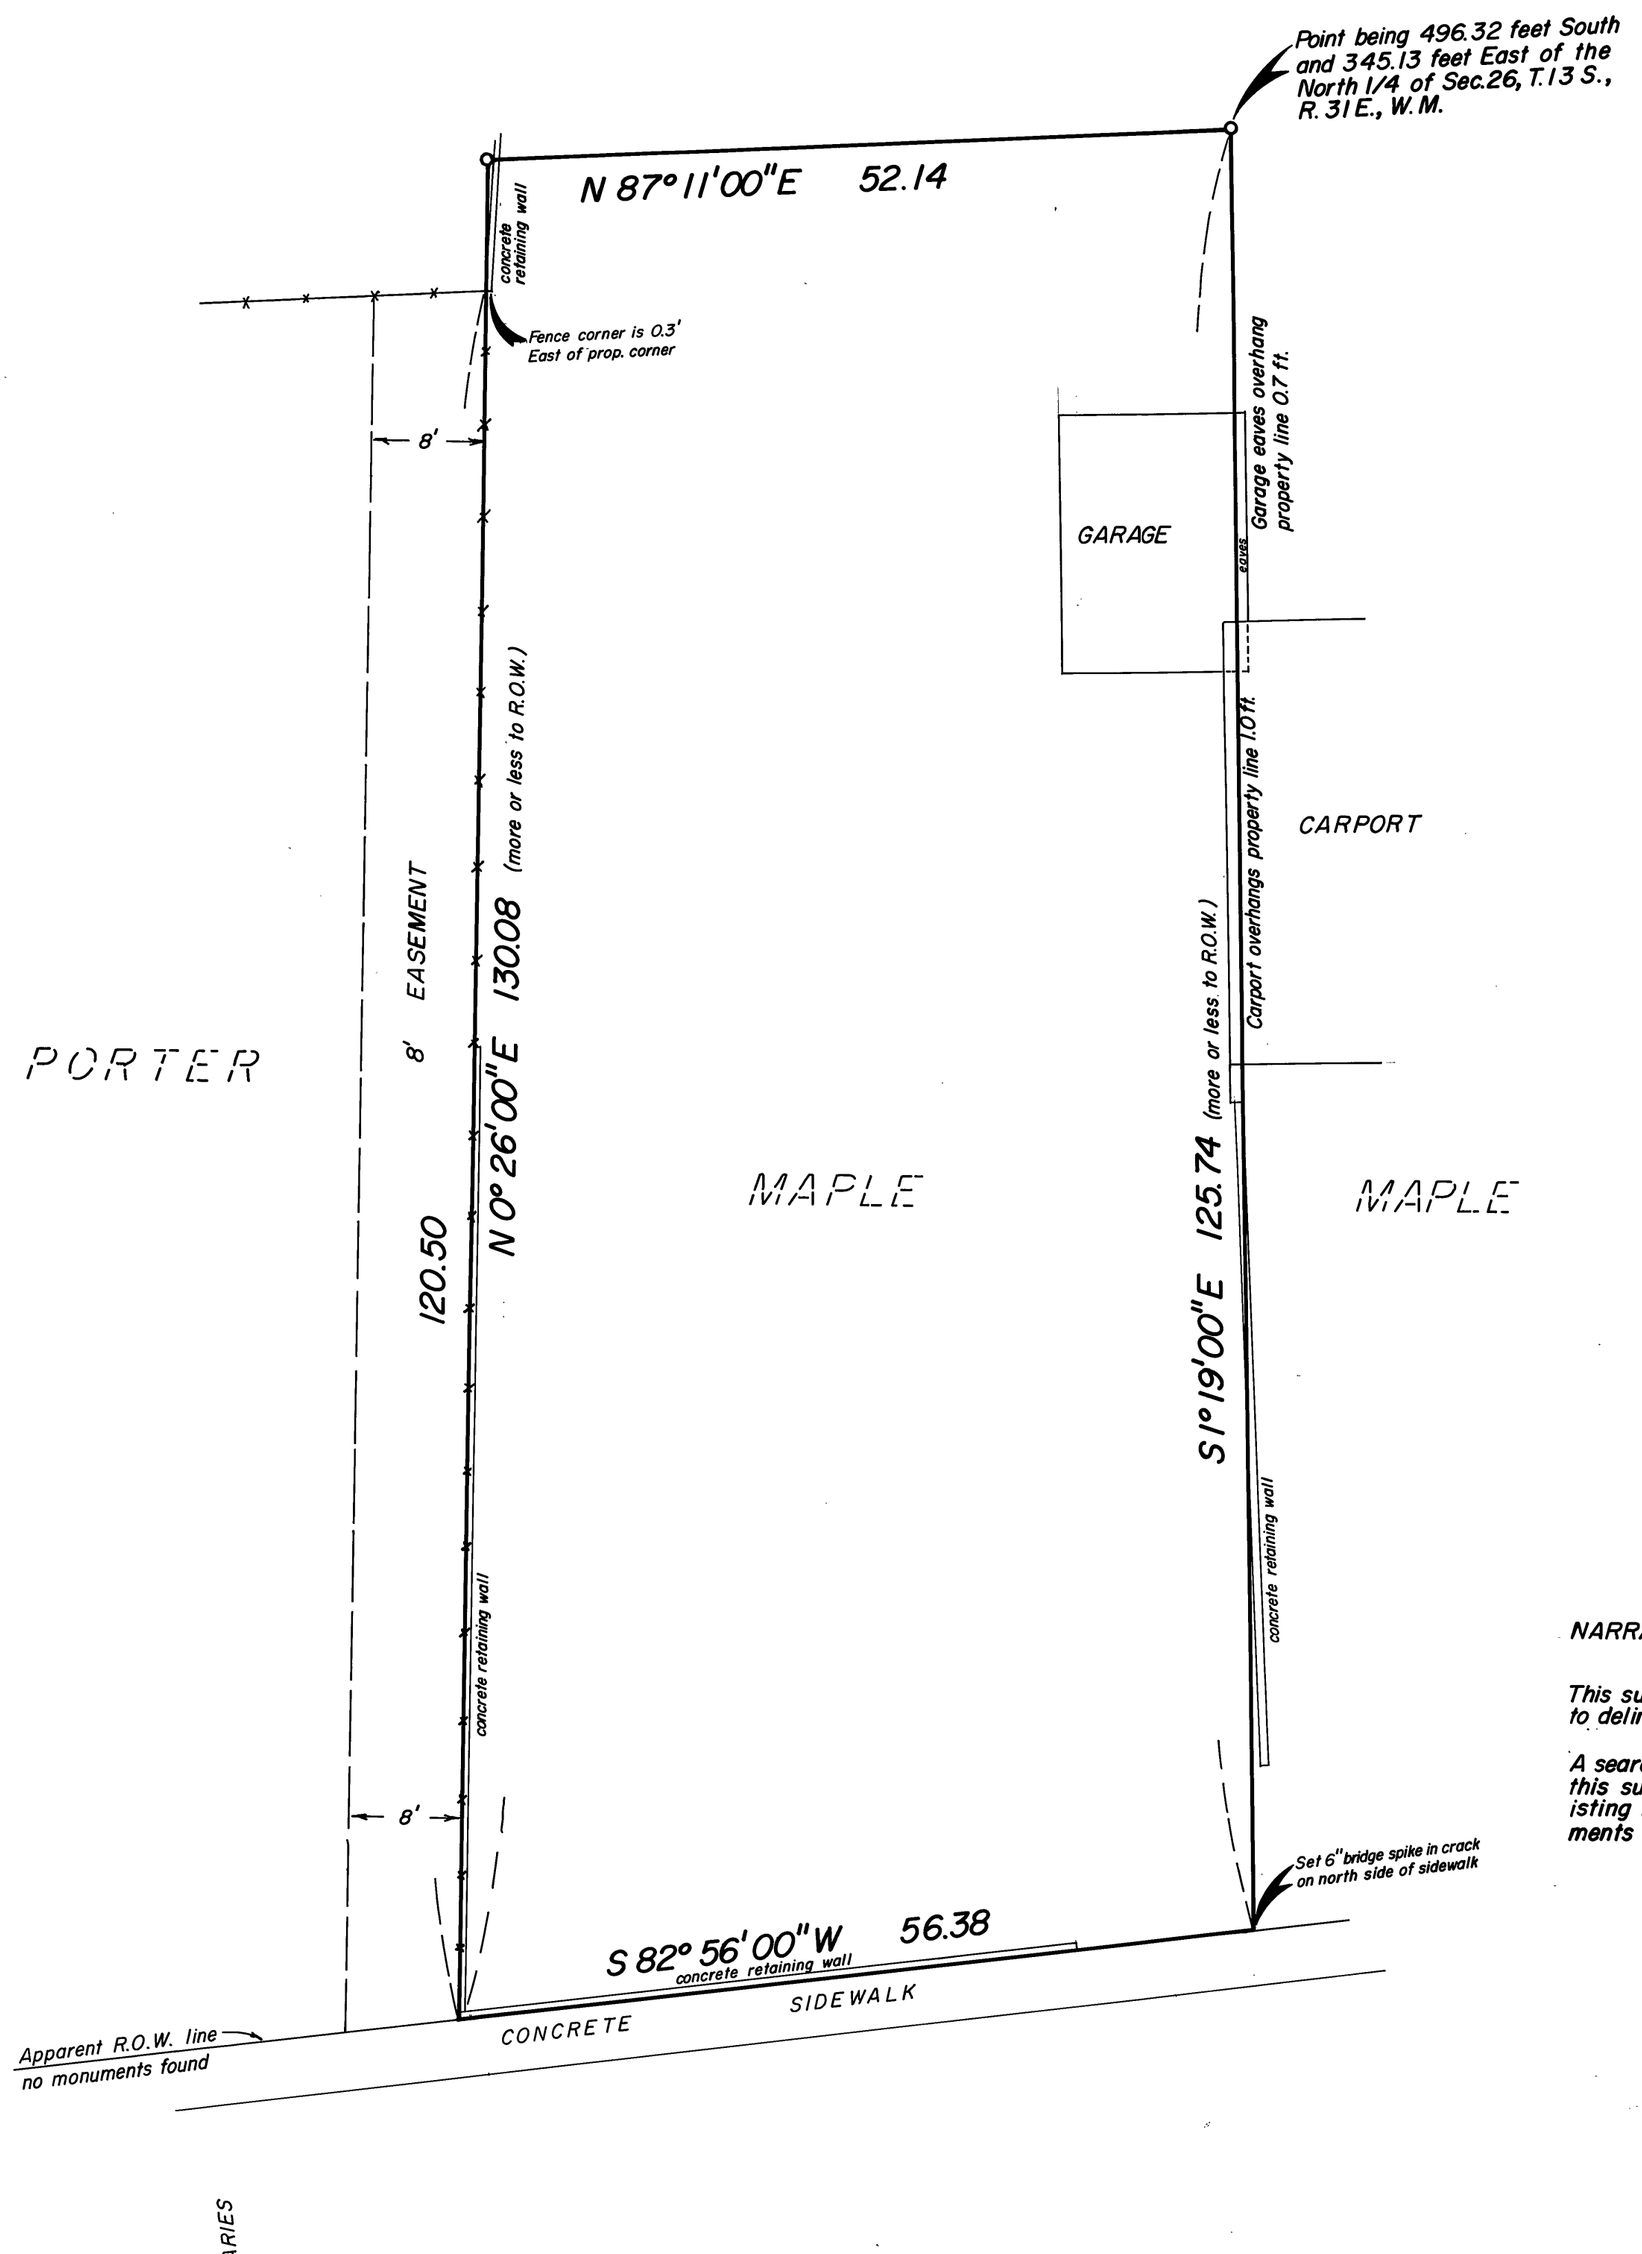

N

BASIS OF BEARINGS

SOLAR OBSERVATION

LEGEND

○ Set 5/8"x 30" iron pin with a yellow plastic cap marked, B-G-A SURVEY MARKER

x——x Fence

NARRATIVE:

This survey was performed at the request of Claire Maple to delineate a parcel of land from within the Maple tract.

A search was made of the available records pertaining to this survey. Field measurements were made to locate existing monuments and selected improvements. New monuments were set in accordance with the evidence found.

REGISTERED
PROFESSIONAL
LAND SURVEYOR

Robert D. Bagett

OREGON
JULY 12, 1963
ROBERT D. BAGETT
598

RECEIVED AND
FILED
OCT 31 1980
OFFICE OF COUNTY SURVEYOR
Robert D. Bagett
Attest: John Silveira

BAGETT, GRIFFITH & ASSOCIATES
John Day, Oregon

Map of Survey

A TRACT OF LAND SITUATED IN THE NW1/4NE1/4 SECTION 26, T.13 S., R. 31 E., W. M.
CITY OF JOHN DAY
GRANT COUNTY, OREGON

SURVEYED FOR	CLAIRE MAPLE	
SURVEYED BY	R.D.B. & G.L.E.	9/26/80
Scale: 1"= 10'	Drawn by: G.L.E.	9/30/80

MAP OF SURVEY NO. 626