


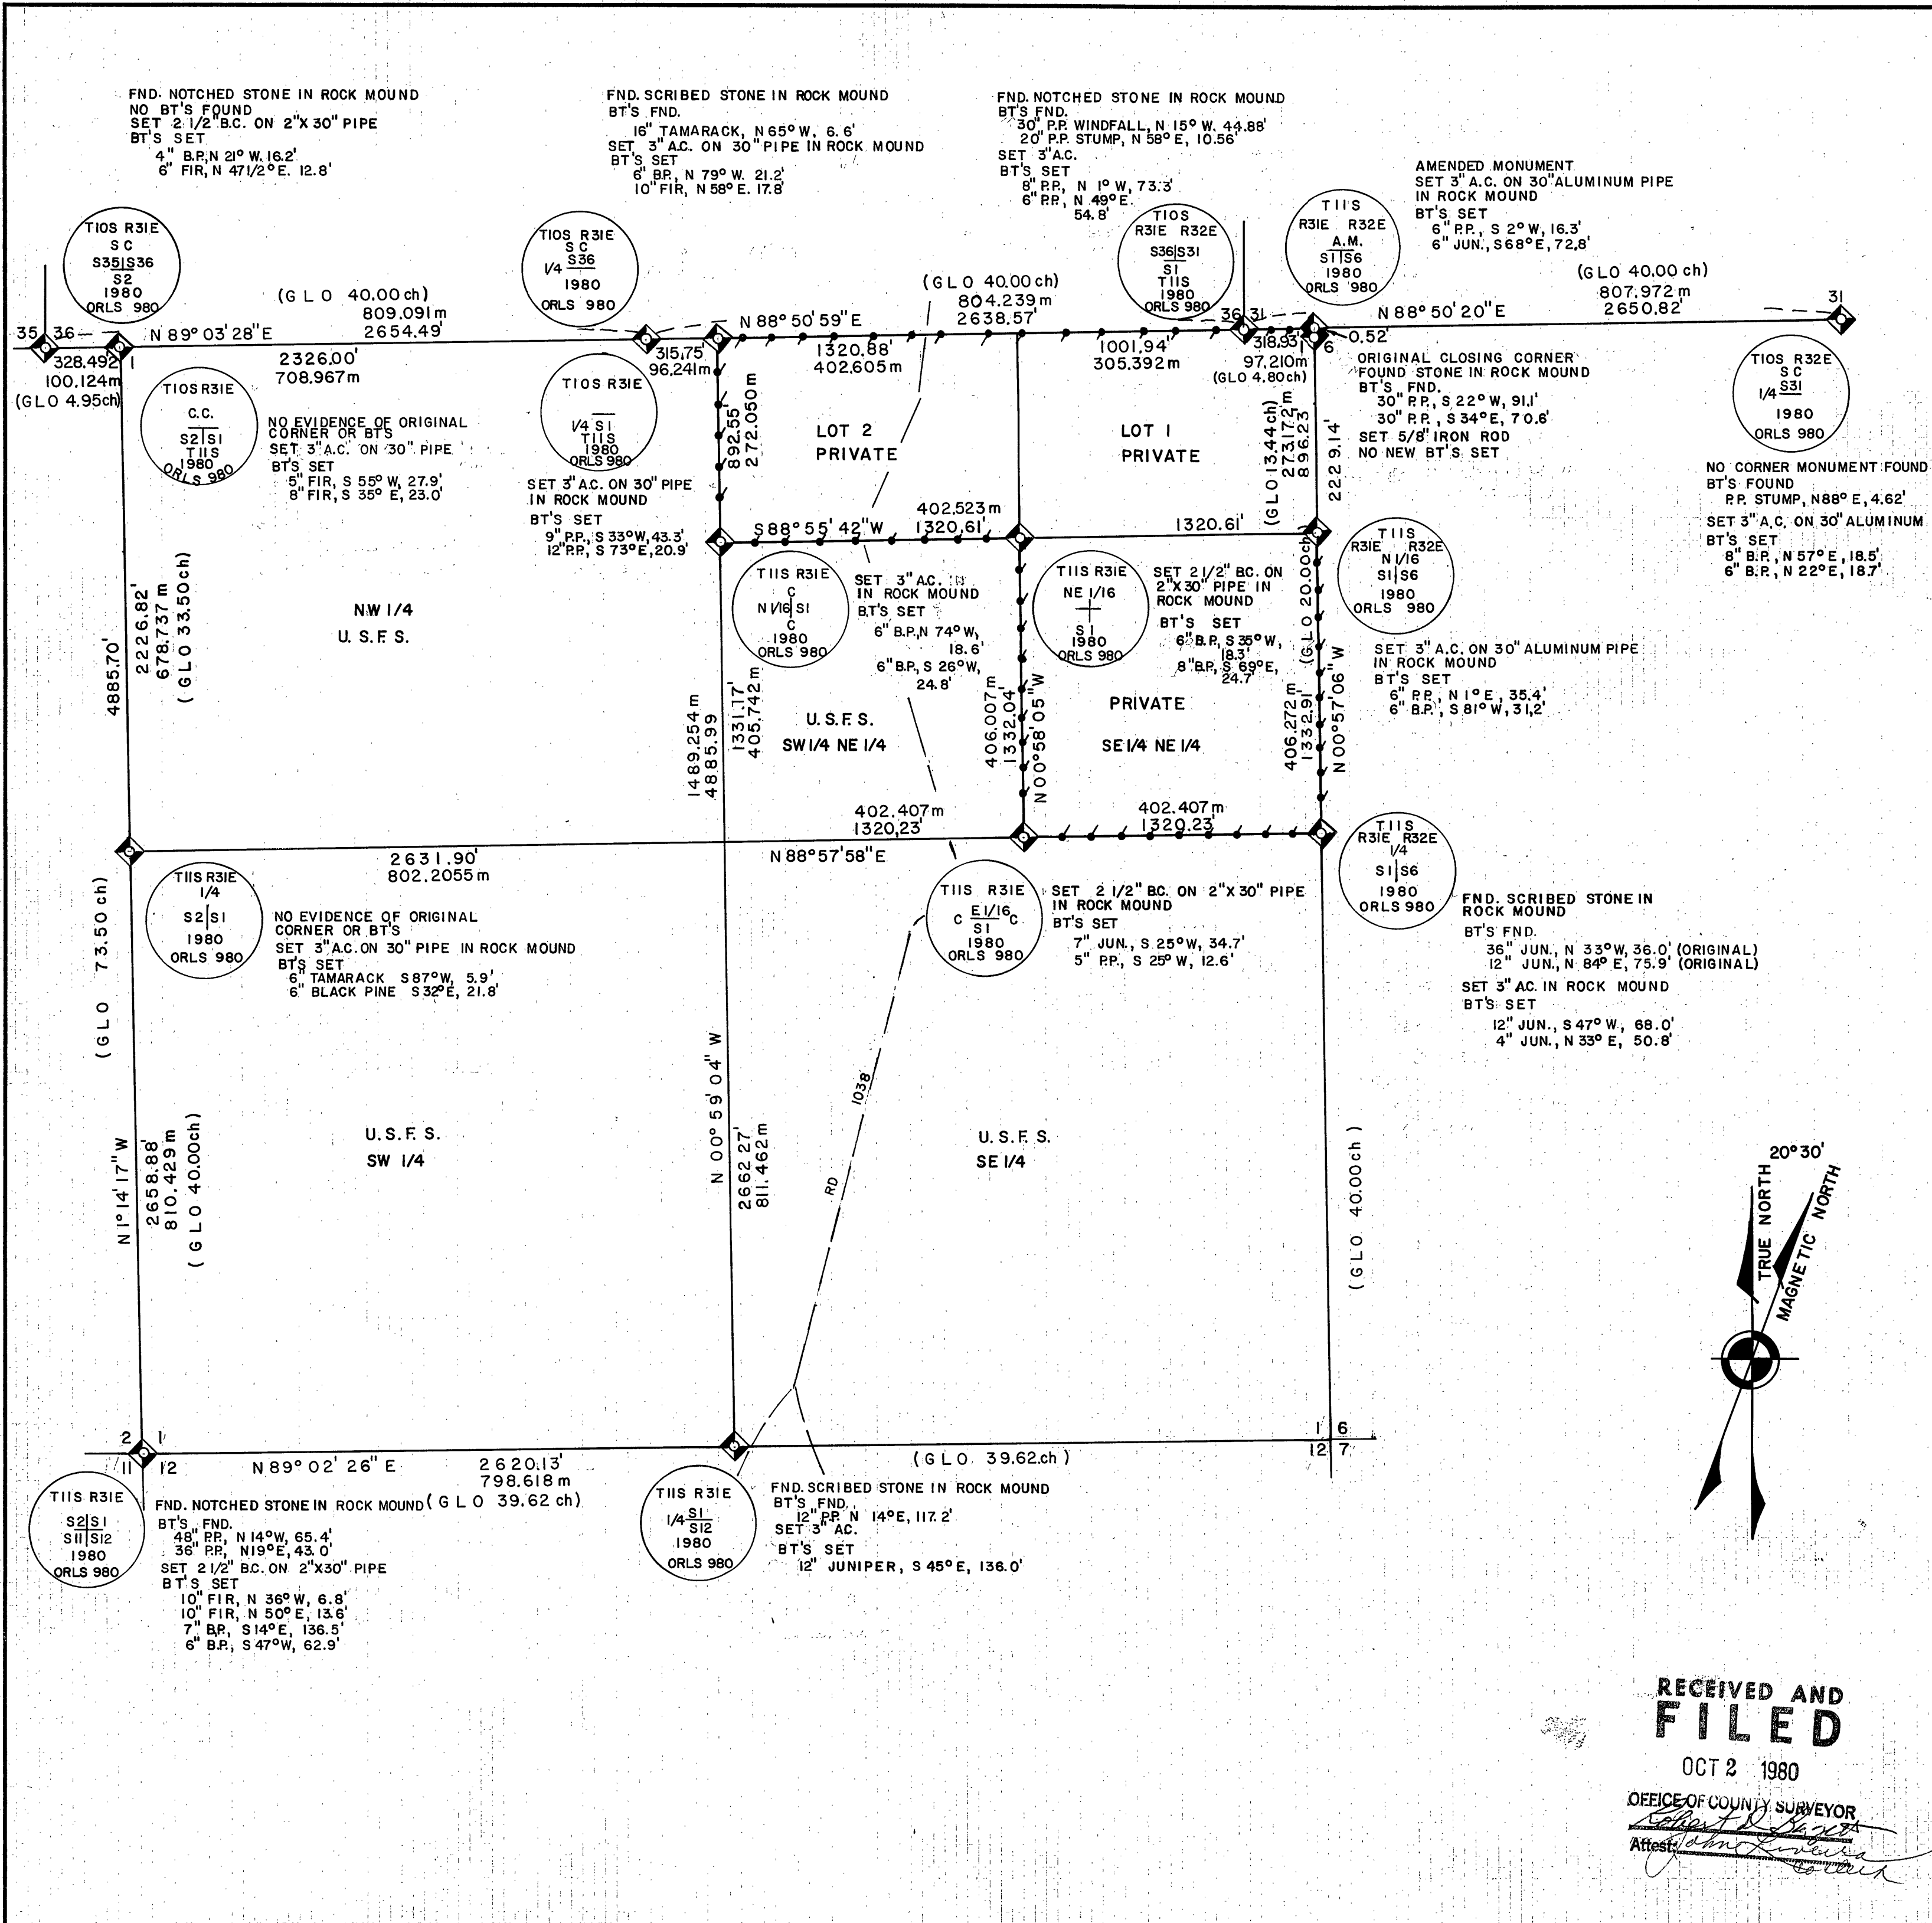

CADASTRAL SURVEY
LOCATED IN SECTION 1, T11S, R31E, W.M.
GRANT COUNTY, OREGON

SURVEYOR'S CERTIFICATE
I, EDGAR W. GRAVES, A REGISTERED PROFESSIONAL LAND SURVEYOR IN THE STATE OF OREGON, DO HEREBY CERTIFY THAT THIS DRAWING AND THE NOTES HEREON OR ATTACHED, ARE A CORRECT REPRESENTATION OF A SURVEY MADE UNDER MY DIRECT SUPERVISION DURING JULY & AUGUST 1980 FOR THE U.S. FOREST SERVICE IN ACCORDANCE WITH THE ARTICLES OF CONTRACT NO. 53-04HI-0-799IN WITH GRAVES SURVEYING, INC. BEND, OREGON.

EDGAR W. GRAVES, O.L.S. NO. 980 DATE

- LEGEND**
- ◆— DENOTES MONUMENT FOUND AS NOTED
 - ◆— DENOTES MONUMENT SET AS NOTED
 - |—|—|— DENOTES FOREST SERVICE BOUNDARY POSTED
 - (- - -) DENOTES DATA OF RECORD
 - - - - DENOTES APPROXIMATE ROAD LOCATION

- NOTES**
1. ORIGINAL FIELD NOTES FOR THIS CONTRACT ARE ON FILE IN THE OFFICE OF GRAVES SURVEYING, INC., 224 S.E. TAFT, BEND, OREGON.
 2. BEARINGS ARE BASED ON SOLAR OBSERVATION
 3. EQUIVALENT DISTANCE IN METERS FOR LINES REQUIRED TO BE SURVEYED UNDER THIS CONTRACT ARE OBTAINED USING A CONVERSION OF 3.28083 FEET PER METER.
 4. DIAMETER, SPECIES, AND BEARING & DISTANCE TO THE TREE'S CENTER IS GIVEN FOR BEARING TREES.
 5. G.L.O. DATA FROM OFFICIAL NOTES, BY ROBB & GRADON, MAY 1881
 6. ABBREVIATIONS USED ON THIS PLAT
AC — ALUMINUM CAP B.P. — BLACK PINE
B.C. — BRASS CAP P.P. — PONDEROSA PINE
B.T. — BEARING TREE ch — GUNTER CHAIN
JUN. — JUNIPER m — METER
 7. ALL MONUMENTS FOUND ARE BASED ON RESURVEYS AND PRIVATE SURVEYS AS NOTED.

LEGAL DESCRIPTION OF PRIVATE LAND

1. GOVERNMENT LOTS 1 & 2
2. SE 1/4 NE 1/4

REGISTERED
PROFESSIONAL
LAND SURVEYOR
Edgar W. Graves
OREGON
JULY 14, 1972
EDGAR W. GRAVES
980

RECEIVED AND
FILED
OCT 2 1980

OFFICE OF COUNTY SURVEYOR
Robert D. ...
Attest: *John ...*

CADASTRAL SURVEY LOCATED IN SECTION 1, T11S, R31E, W.M., GRANT COUNTY, OREGON		
SCALE: 1" = 500'	APPROVED BY:	DRAWN BY NG & EG
DATE: SEPT. 1980		REVISED
GRAVES SURVEYING, INC. 224 S.E. TAFT ST. BEND, OREGON		
MALHEUR NATIONAL FOREST HUCKLEBERRY BOUNDARY CADASTRAL		DRAWING NUMBER 80-754

Map of Survey No. 628