



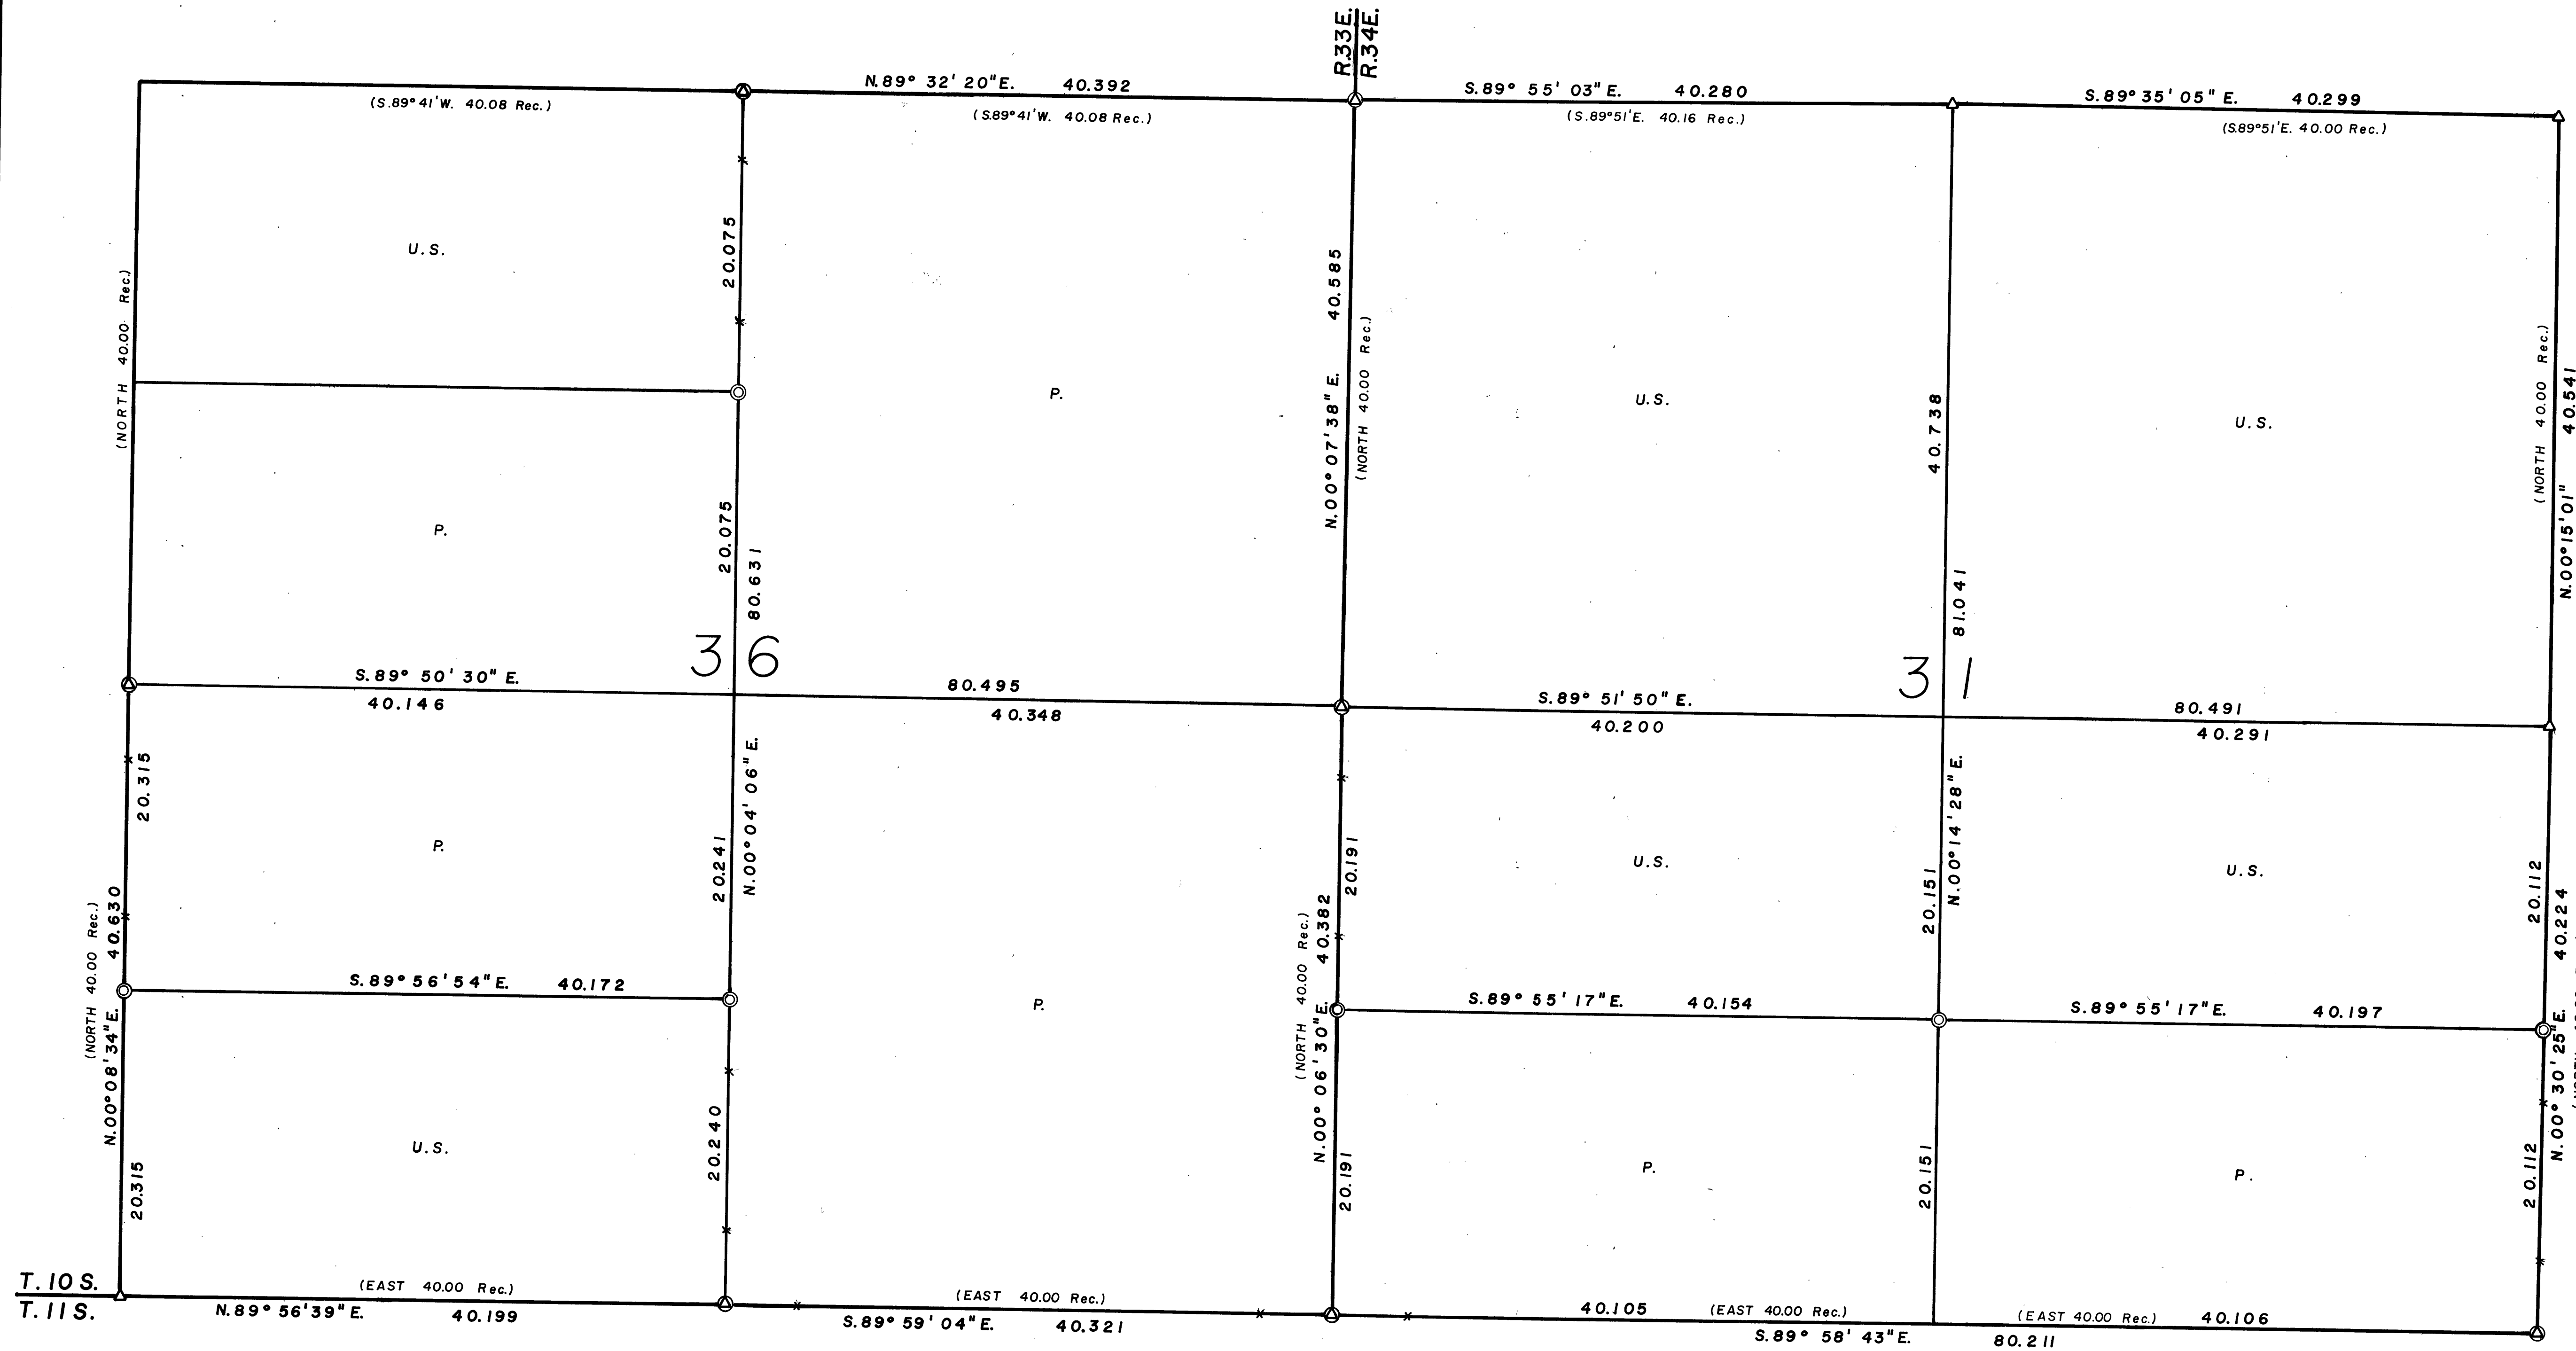

MAGNETIC DECLINATION: 19°E.

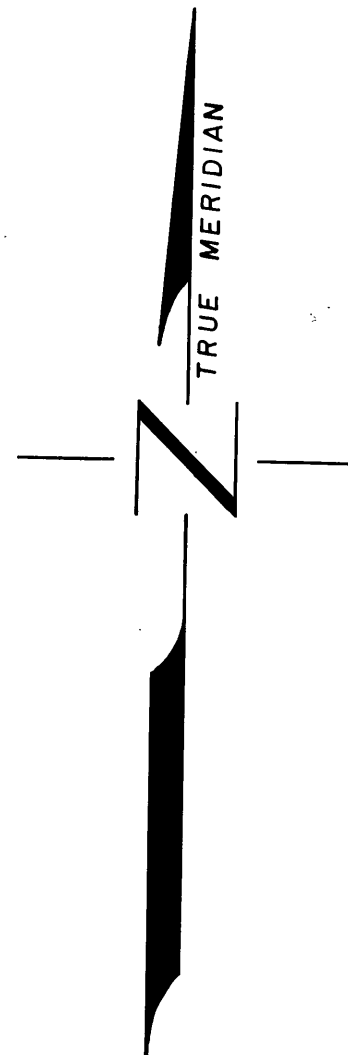

SCALE: 1" = 6 Chains

P. Private Property
U.S. United States Property
— Azimuth points on true line
(steel fence posts)

REGISTERED
OREGON
LAND SURVEYOR
Duane I. Griffith
JULY 10, 1964
DUANE I. GRIFFITH
644

LEGEND

- ⊙ BRASS CAP SET
- △ FOUND ORIGINAL MONUMENT
- ⊙ ORIGINAL MON. REPLACED WITH B.C.

Brass caps stamped with date and
ORE. L.S. 644 and with proper nomenclature
as prescribed in B.L.M. manual.

Basis of bearings:
SOLAR OBSERVATION near S.W. corner of
SEC. 36, T.10S., R.33E., W.M.

HISTORY OF ORIGINAL SURVEYS

T.10S., R.33E.—Surveyed by ROBB & GRADEN
June, 1881.
T.10S., R.34E.—Surveyed by ROBB & GRADEN
July, 1881.

CERTIFICATION

I, Duane I. Griffith, do hereby certify
that, during the summer of 1967, the area
herein shown was surveyed under my direct
supervision in accordance with procedures
set forth in the B.L.M. Manual and the OREGON
STATE LAWS governing public land surveys
and under instructions of the MALHEUR
NATIONAL FOREST and that this plat is,
to the best of my knowledge, is a true represen-
tation thereof.

Duane I. Griffith

RECEIVED AND
FILED
NOV 28 1967
JOHN LIVEIRA, County Clerk
By _____ Deputy

BAGETT & GRIFFITH SURVEYING
P.O. BOX 476 JOHN DAY, OREGON
SURVEY MAP OF
SEC. 36, T.10S., R.33E. &
SEC. 31, T.10S., R.34E., W.M.
GRANT COUNTY,
OREGON

SURVEYED FOR
MALHEUR NAT'L FOREST
SURVEYED BY D. I. GRIFFITH SUMMER, '67
DRAWN BY G. D. GRIFFITH 10 / 67