

FOREST SERVICE LANDS

T 12 S, R 32 E,

Section 11
The S 1/2
The NW 1/4
The SW 1/4 of the NE 1/4

Section 12
The N 1/2
The SW 1/4

Section 13
The NE 1/4

T 12 S, R 33 E,

Section 6
The S 1/2

Section 7
The W 1/2


Section 18
The N 1/2
The SW 1/4
The N 1/2 of the SE 1/4
The SW 1/4 of the SE 1/4

Section 19
The S 1/2
The W 1/2 of the NE 1/4

NOTES

For monumentation information, see
remonumentation sheets filed separately.

SCALE: 1" = 600'
1 meter = 3.280833 feet

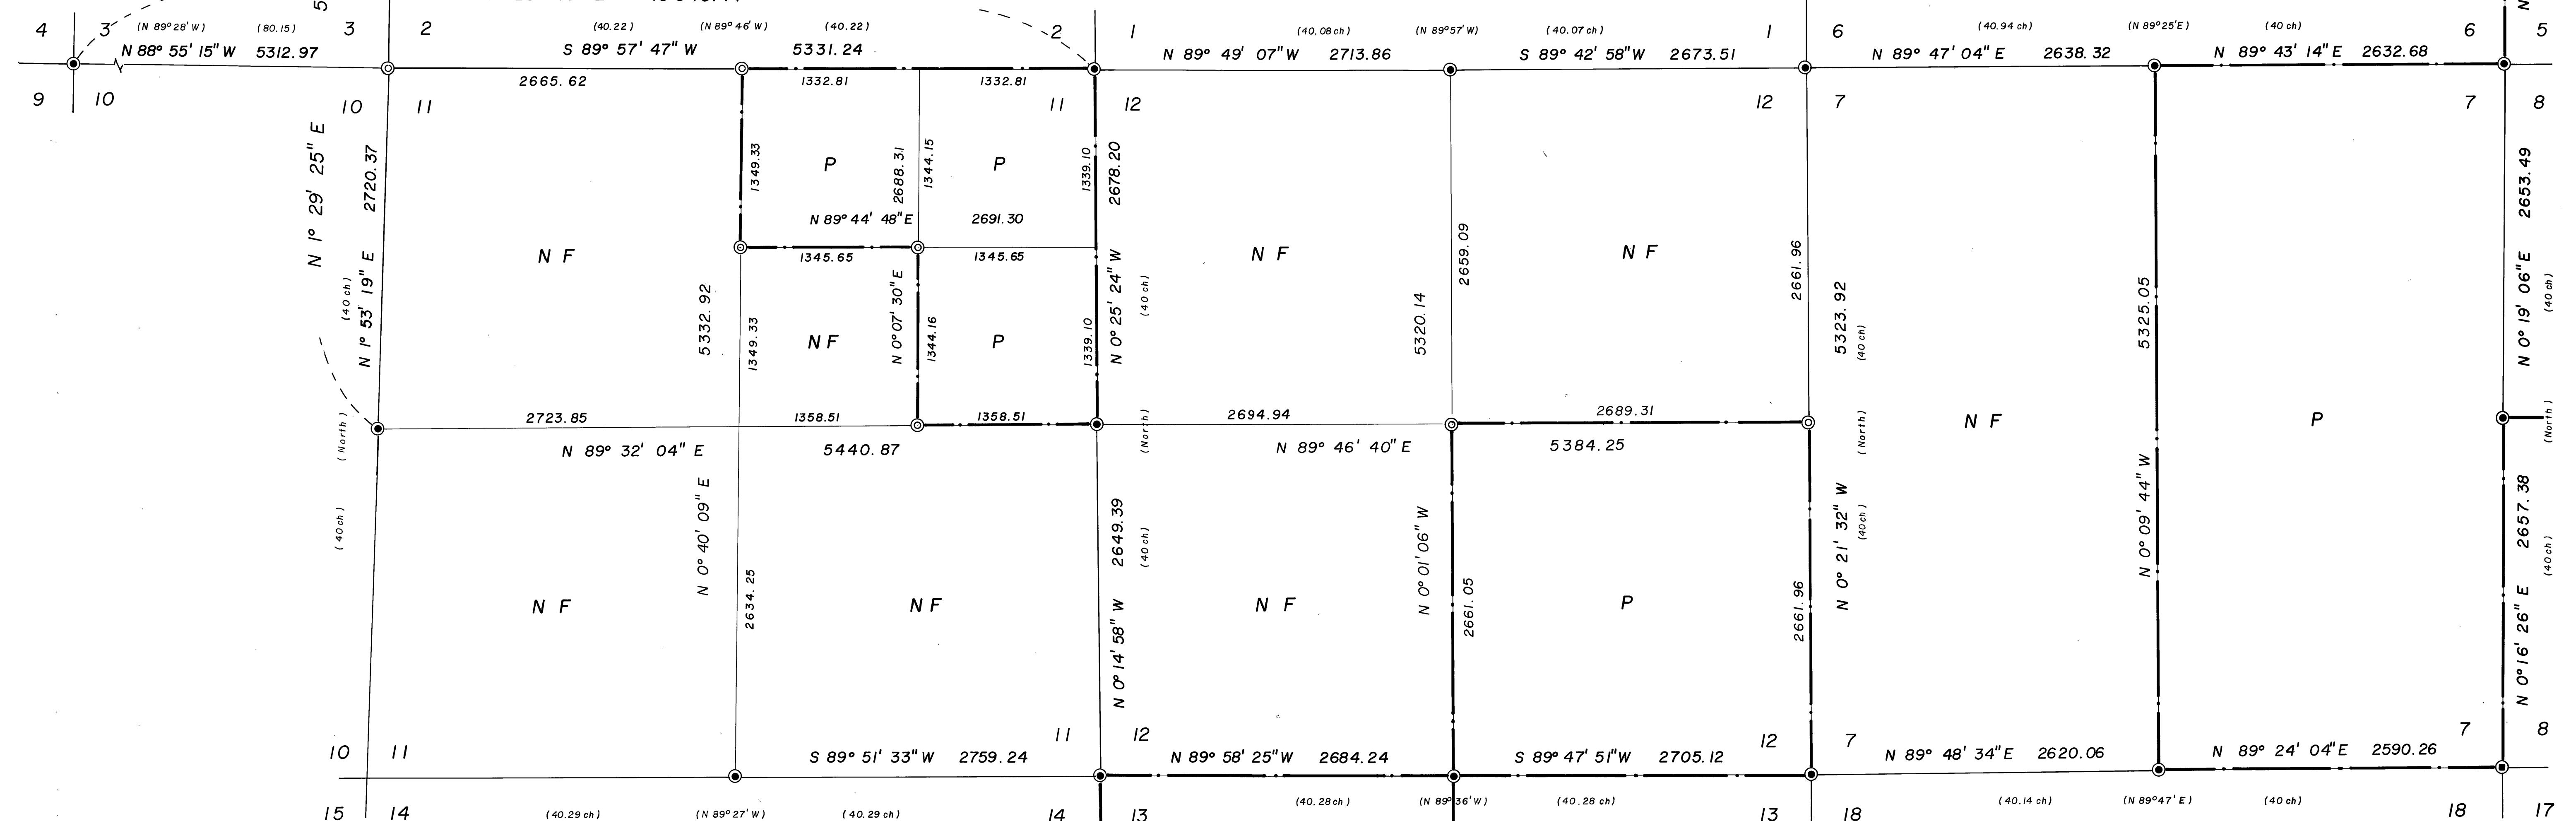

SURVEY CONTINUED ON SHEET 1

RECEIVED AND
FILED
OCT 31 1980

OFFICE OF COUNTY SURVEYOR

DUANE J. GRIFFITH

654



BAGETT - GRIFFITH & ASSOCIATES Map of Survey In sections 10-11-12 & 13 T 12 S, R 32 E, W.M. In sections 6-7-18 & 19 T 12 S, R 33 E, W.M. GRANT COUNTY, OREGON		
SURVEYED FOR	MALHEUR NATIONAL FOREST	
SURVEYED BY	dig. gtb. g.l.e. r.d.b.	9 / 1980
Scale: 1" = 600'	Drawn by: d.i.g.	10 / 1980

SHEET 2 of 2

MAP OF SURVEY NO. 630