



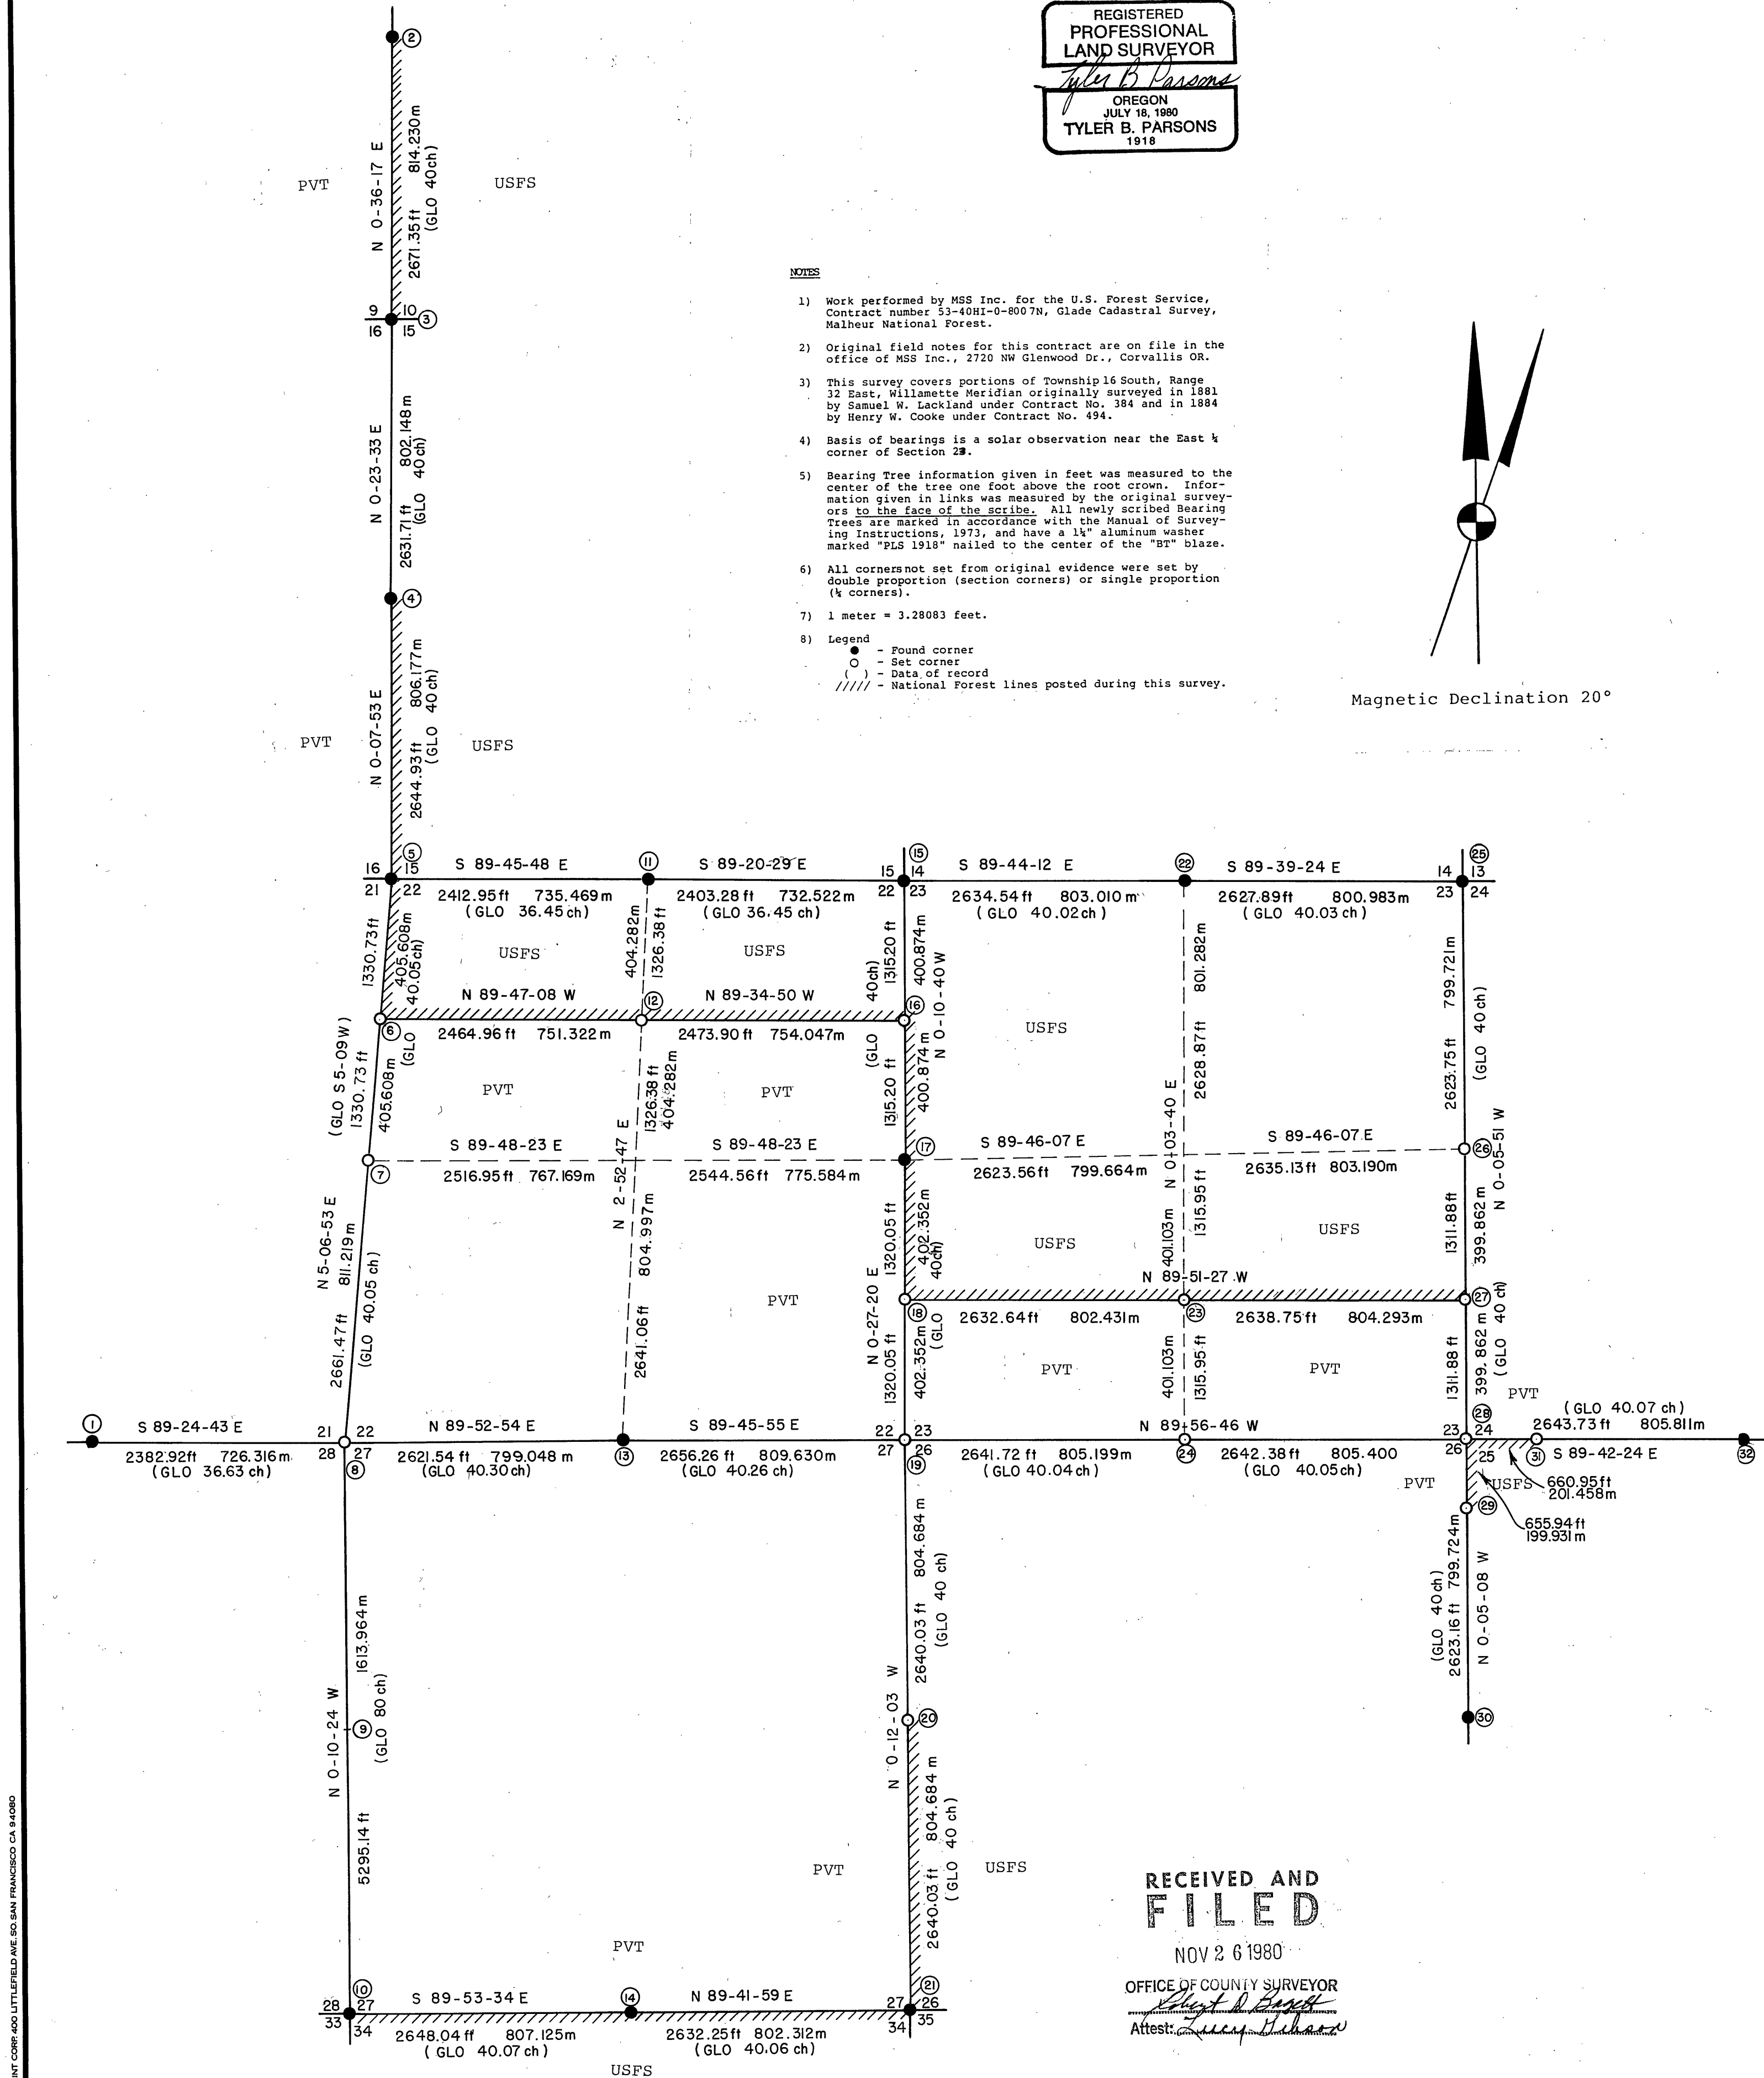

SURVEYOR'S CERTIFICATE
I, Tyler B. Parsons, a registered Professional Land Surveyor in the State of Oregon, hereby certify that this plat and the notes hereon, or attached, are a correct representation of a survey I performed during July/October 1980, for the U.S. Forest Service, in accordance with the statutes of the State of Oregon and with the Articles of my contract.

REGISTERED
PROFESSIONAL
LAND SURVEYOR
TYLER B. PARSONS
JULY 18, 1980
OREGON
1818

- NOTES
- Work performed by MSS Inc. for the U.S. Forest Service, Contract number 53-4081-0-8007N, Glade Cadastral Survey, Malheur National Forest.
 - Original field notes for this contract are on file in the office of MSS Inc., 2720 NW Glenwood Dr., Corvallis OR.
 - This survey covers portions of Township 16 South, Range 32 East, Willamette Meridian originally surveyed in 1881 by Samuel W. Lackland under Contract No. 384 and in 1884 by Henry W. Cooke under Contract No. 494.
 - Basis of bearings is a solar observation near the East 1/4 corner of Section 28.
 - Bearing Tree information given in feet was measured to the center of the tree one foot above the root crown. Information given in links was measured by the original surveyors to the face of the scribe. All newly scribed bearings were marked in accordance with the Manual of Surveying Instructions, 1973, and have a 1/4" aluminum washer marked "PLS 1918" nailed to the center of the "BT" blaze.
 - All corners not set from original evidence were set by double proportion (section corners) or single proportion (1/4 corners).
 - 1 meter = 3.28083 feet.
 - Legend:
 - - Found corner
 - - Set corner
 - () - Data of record
 - //// - National Forest lines posted during this survey.

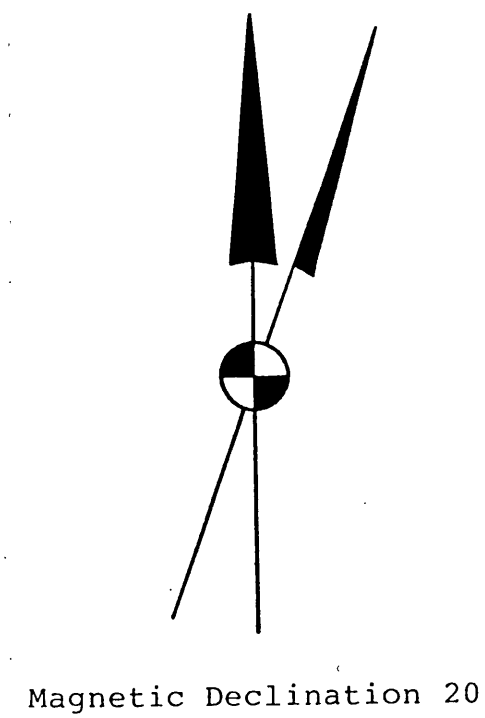

RECEIVED AND
FILED
NOV 2 6 1980

OFFICE OF COUNTY SURVEYOR
Attest: *[Signature]*

- SW Corner Section 21**
Found 3/4" aluminum cap on 2 1/2"x30" aluminum pipe.
BT's found:
 - 28" Ponderosa pine snag, S15°E, 50 lks. Scribed 1/4" BT
 - 20" Ponderosa pine blowdown, N15°W, 19 lks. Scribed 1/4" BT
 - 10" Ponderosa pine S45°W, 44.4 ft. Scribed 1/4" BT
 - 8" Ponderosa pine N16°W, 4.6 ft. Scribed 1/4" BTBT's set:
 - 28" Ponderosa pine, S26°E, 98.5 ft. Scribed 1/4" BT
 - 14" Ponderosa pine, N40°E, 56.6 ft. Scribed 1/4" BTT16S R32E S9 S10 PLS 1918 1980
- SW Corner Section 9**
Found Basalt stone marked 1/4 in old stone mound in fence line at base of fence jack.
Set 2 1/2" brass cap on 2"x30" galvanized iron pipe.
Buried stone upside down south of new monument.
BT's found (no original BT's)
BT's set:
 - 20" Ponderosa pine, S26°E, 98.5 ft. Scribed 1/4" BT
 - 14" Ponderosa pine, N40°E, 56.6 ft. Scribed 1/4" BTT16S R32E S9 S10 PLS 1918 1980
- SW Corner Section 9**
Found 3/4" cap on 2 1/2"x30" aluminum pipe.
BT's found:
 - 6" Ponderosa pine, N57°E, 4.6 ft. Scribed T16S R32E S10 BT
 - 6" Ponderosa pine, S28°E, 24.7 ft. Scribed T16S R32E S15 BT
 - 6" Ponderosa pine, S59°W, 33.4 ft. Scribed T16S R32E S9 BT
 - 10" Ponderosa pine, N40°W, 5.3 ft. Scribed T16S R32E S9 BTBT's set:
 - 28" Ponderosa pine, N47°E, 15 lks. Scribed 1/4" BT
 - 32" Ponderosa pine, S44°W, 19.7 ft. Scribed 1/4" BT
 - 14" Ponderosa pine, S48°E, 51.8 ft. Scribed 1/4" BTT16S R32E S9 S10 PLS 1918 1980
