


MAGNETIC DECLINATION: 19° E.

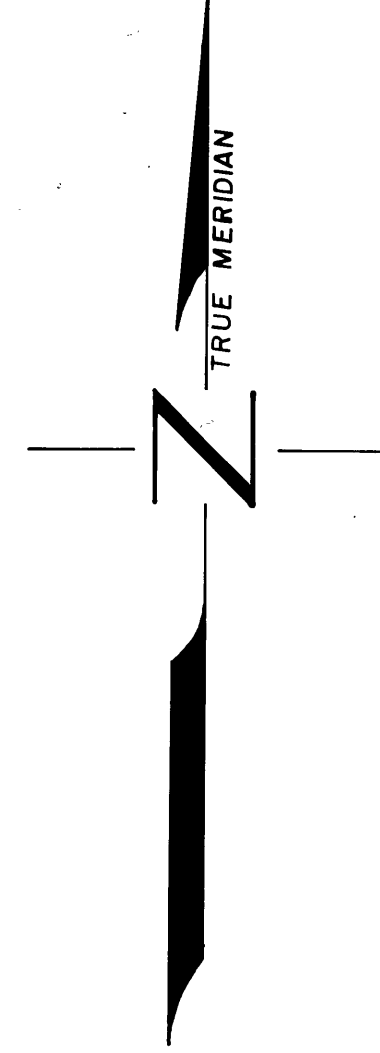

SCALE: 1" = 4 chains

RECEIVED AND
FILED
NOV 29 1967
JOHN LIVEIRA, County Clerk
By _____ Deputy

LEGEND

- ⊙ BRASS CAPS SET
 - △ FOUND ORIGINAL MONUMENT
 - ⊙ ORIGINAL MON. REPLACED WITH B.C.
- Brass caps stamped with date and
ORE. L.S. 644 and with proper nomenclature
as prescribed in B.L.M. manual.
- Basis of bearings:
SOLAR OBSERVATION near S.W. corner of
SEC. 36, T. 10S., R. 33E., W.M.

CERTIFICATION

I, Duane I. Griffith, do hereby certify that, during the
summer 1967, the area herein shown was surveyed under
my direct supervision in accordance with procedures set
forth in the B.L.M. Manual and the OREGON STATE LAW
governing public land surveys and under instructions of the
MALHEUR NATIONAL FOREST and that this plat is, to
the best of my knowledge, a true representation thereof.

Duane I. Griffith



HISTORY OF ORIGINAL SURVEYS

T. 10S., R. 33E.- Surveyed by ROBB & GRADEN- June, 1881
T. 10S., R. 34E.- Surveyed by ROBB & GRADEN- July, 1881

John Liveira

- P. Private Property
- U.S. United States Property
- Azimuth points on true line (steel fence posts)

BAGETT & GRIFFITH SURVEYING P.O. BOX 476 JOHN DAY, OREGON		
SURVEY MAP OF SEC. 32, T. 10S., R. 34 E., W. M., GRANT COUNTY, OREGON		
SURVEYED FOR MALHEUR NAT'L FOREST		
SURVEYED BY	D. I. GRIFFITH	SUMMER '67
DRAWN BY	G. D. GRIFFITH	10 / 67