
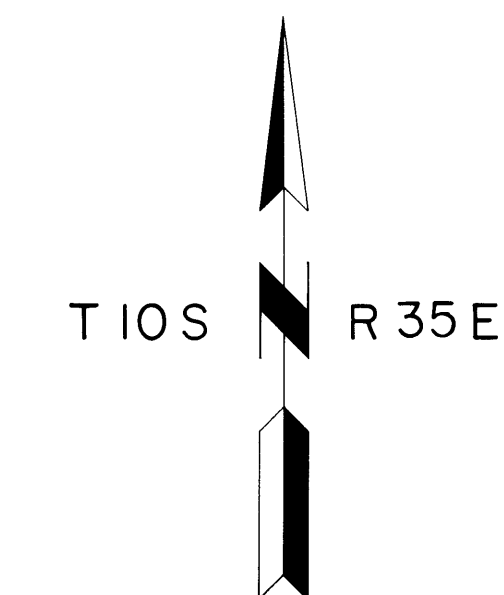


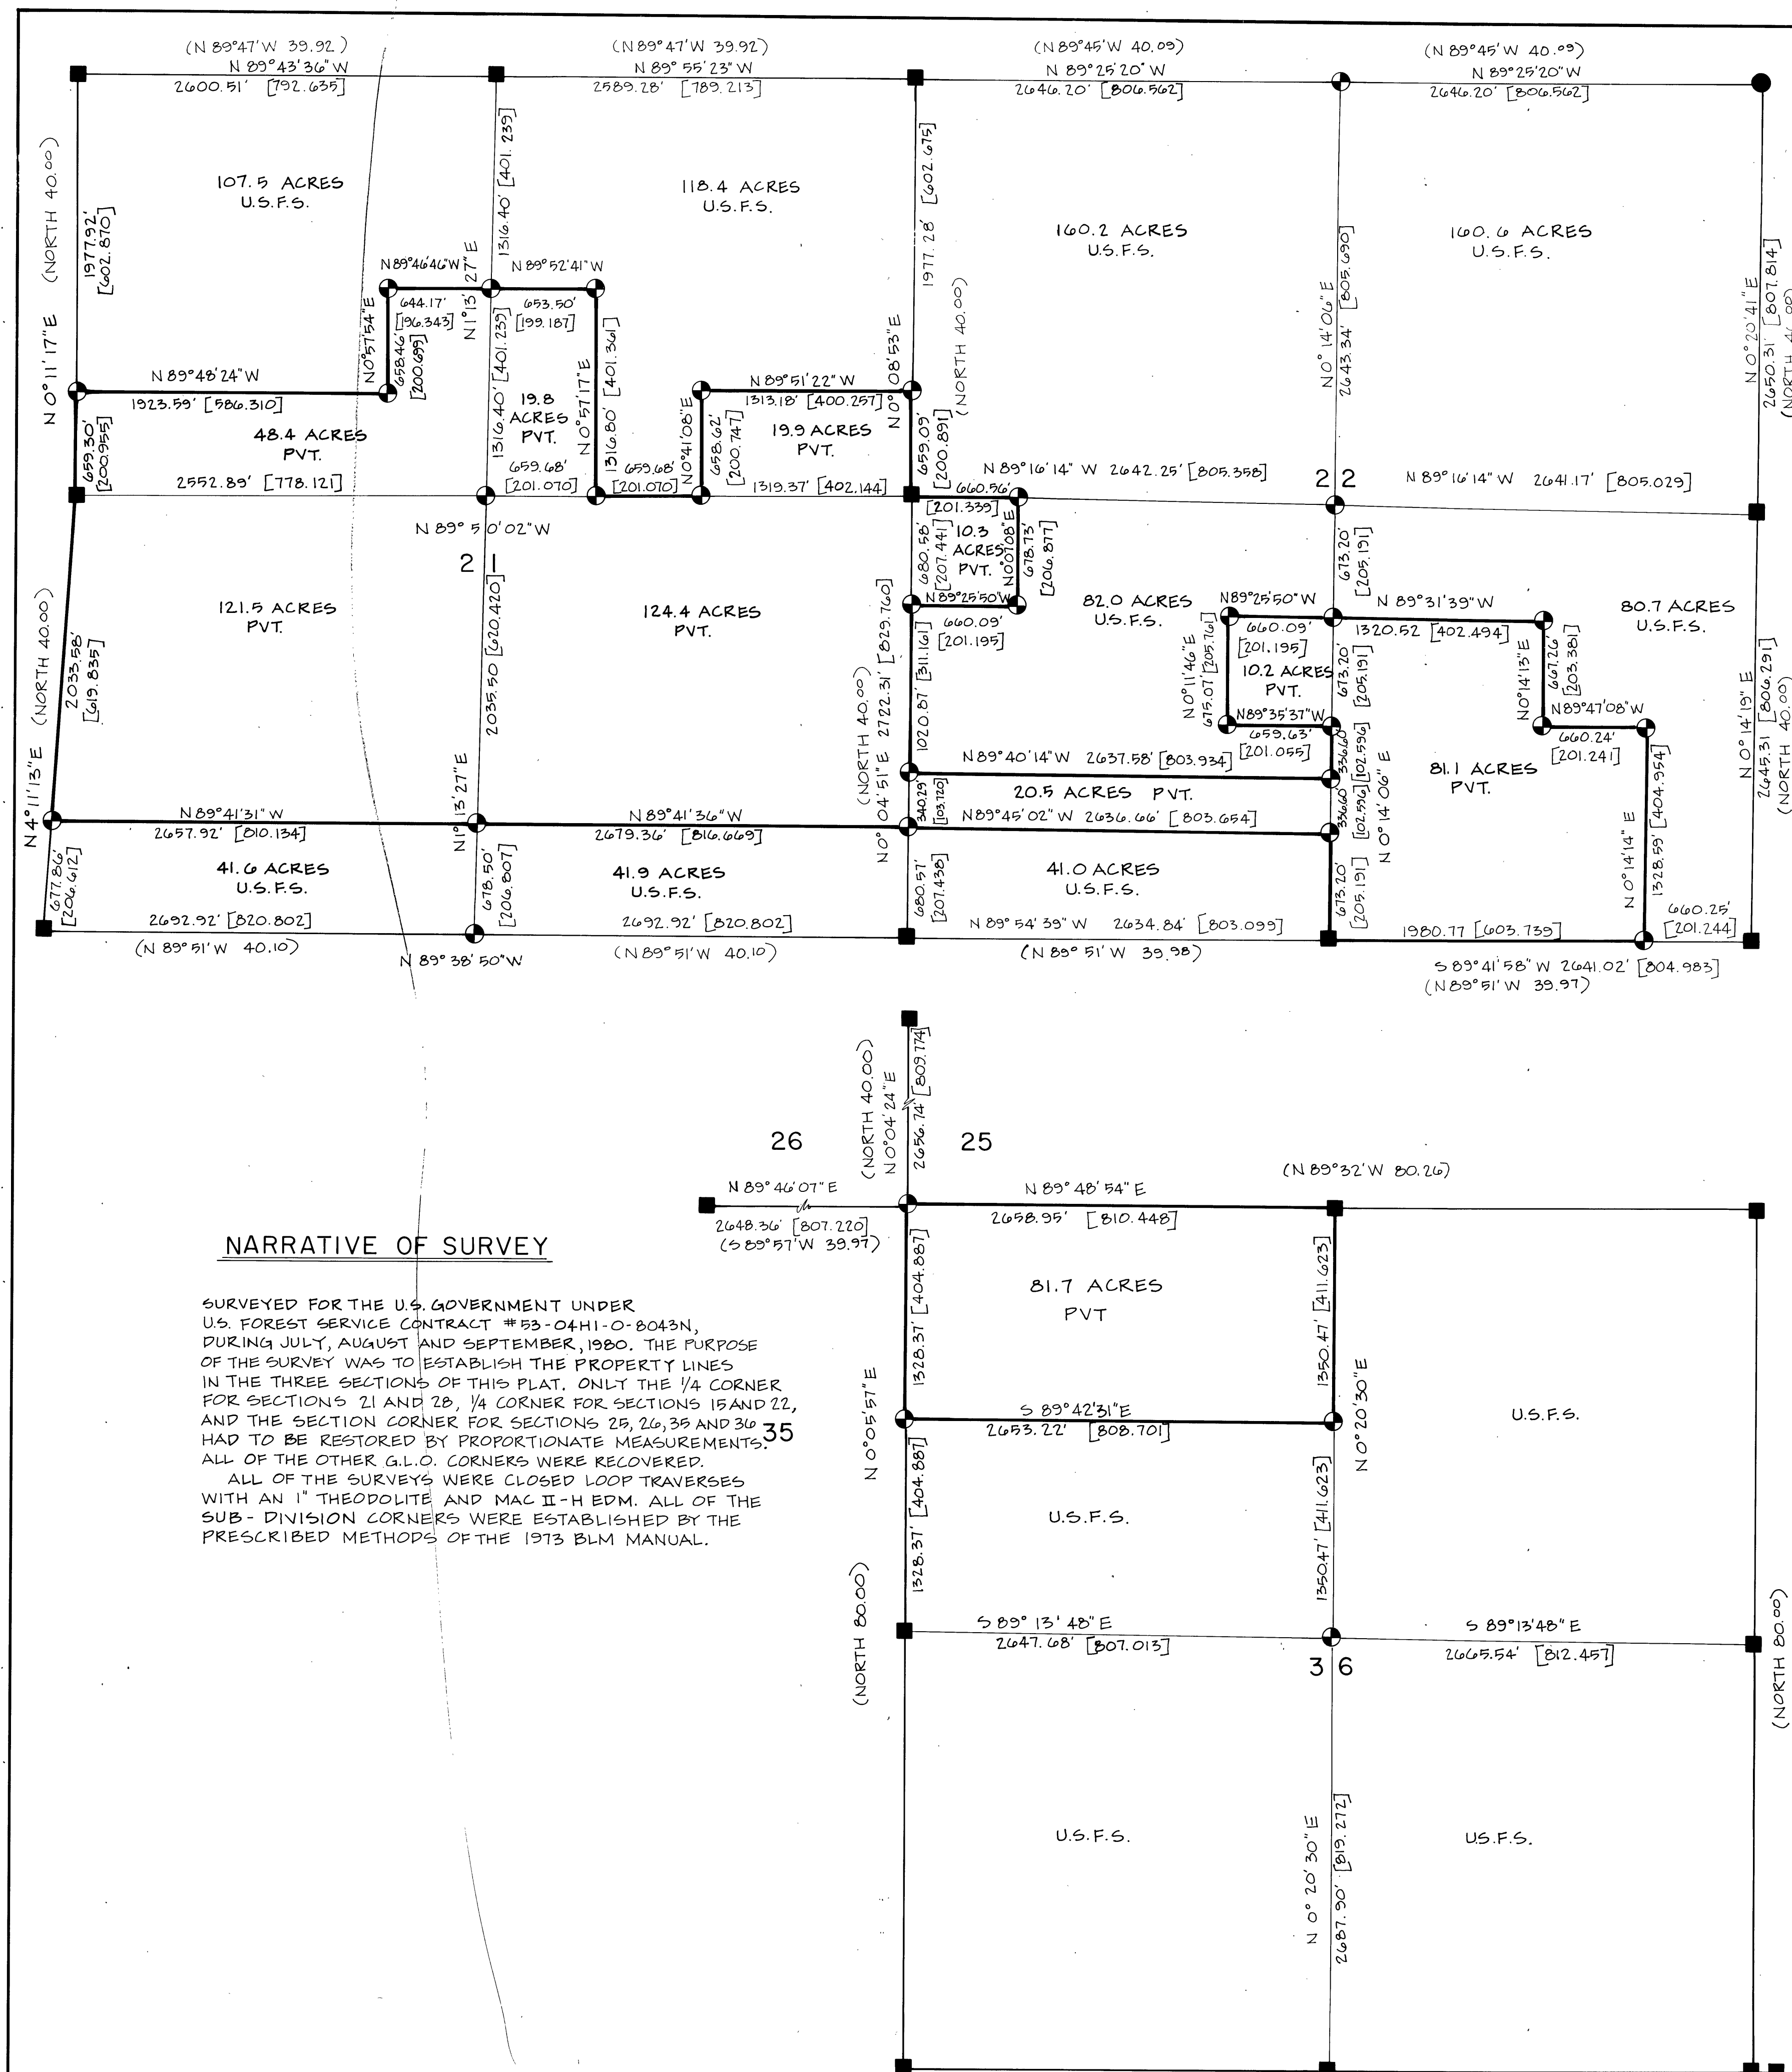

SECTIONS 21, 22 & 36
W.M.

BASIS OF BEARING

SOLAR OBSERVATION
JULY 31, 1980
AUGUST 29, 1980

MEAN MAGNETIC DECLINATION

N 20° 00' E

REFERENCE MATERIAL

ORIGINAL G.L.O. PLAT &
NOTES
FIELD BOOKS 1-7.

LEGEND

- FOUND CORNER (BRASS CAP)
- FOUND CORNER EVIDENCE & SET MONUMENT AS DESCRIBED
- ⊙ SET MONUMENT FROM SURVEY AS DESCRIBED ON U.S.F.S. FORM R6-7100-57.
- U.S. FOREST SERVICE BOUNDARY
- [] METERS
- () RECORD BEARING & DISTANCE

SURVEY HISTORY

T 105, R 35 E, W.M. WAS ORIGINALLY SURVEYED BY HERMAN D. GRADON UNDER G.L.O. CONTRACT NUMBER 416, DURING OCTOBER, 1881. NO SURVEY OF RECORD WAS FOUND FOR SUB-DIVISION SURVEYS OF SECTIONS 21, 22 & 36. SOME OF THE LINES WERE BLAZED AND SIGNED WITH FOREST SERVICE PROPERTY SIGNS.

NOTE: FORM R6-7100-57 FILED AT BAKER COUNTY SURVEYORS FOR STANDARD INDEX FILE NUMBERS IN T105, R35 E, W.M.

N-9, N-11, N-13, N-15, N-17, O-10-11, O-11, O-11-12, O-P-10-11, O-P-12, O-P-13, P-11, P-11-12, P-12, P-13, P-13-14, P-15, P-17, P-Q-13, P-Q-13-14, P-Q-14-15, P-Q-15, P-Q-16, Q-14-15, Q-15, Q-16, Q-16-17, Q-R-11, N-1/2-QR-13, QR-13, N-1/2-QR-15, Q-R-15, R-11, R-13, R-15, R-16-17, R-17, T-21, V-19, V-21, V-23, V-25, W-21, W-23, X-21, X-23 AND X-25.

FORM R6-7100-57 FILED AT GRANT COUNTY SURVEYORS FOR STANDARD INDEX FILE NUMBERS IN T105, R35 E, W.M.

O-P-9, P-Q-9, Q-R-9, R-9, Z-21, Z-23, AND Z-25.

IN T115, R35 E, W.M. A-25.

NARRATIVE OF SURVEY

SURVEYED FOR THE U.S. GOVERNMENT UNDER U.S. FOREST SERVICE CONTRACT #53-04HI-O-8043N, DURING JULY, AUGUST AND SEPTEMBER, 1980. THE PURPOSE OF THE SURVEY WAS TO ESTABLISH THE PROPERTY LINES IN THE THREE SECTIONS OF THIS PLAT. ONLY THE 1/4 CORNER FOR SECTIONS 21 AND 28, 1/4 CORNER FOR SECTIONS 15 AND 22, AND THE SECTION CORNER FOR SECTIONS 25, 26, 35 AND 36 HAD TO BE RESTORED BY PROPORTIONATE MEASUREMENTS. ALL OF THE OTHER G.L.O. CORNERS WERE RECOVERED. ALL OF THE SURVEYS WERE CLOSED LOOP TRAVERSES WITH AN 1" THEODOLITE AND MAC II-H EDM. ALL OF THE SUB-DIVISION CORNERS WERE ESTABLISHED BY THE PRESCRIBED METHODS OF THE 1973 BLM MANUAL.

RECEIVED AND
FILED

JAN 23 1981

OFFICE OF COUNTY SURVEYOR

Attest: *[Signature]*


[Signature]

I, BARRY B. BARBOUR, a registered land surveyor in the State of Oregon, hereby certify that this plat and the notes hereon, or attached, are a correct representation of a survey I performed during July - Sept. , 1980 for the U.S. Forest Service in accordance with the Statutes of the State of Oregon and with the Articles of the Contract.


Barry B. Barbour
Professional Land Surveyor
Oregon License 1051

CONTRACT NO. 53-04HI-O-8043N

SCALE IN FEET 1" = 600'

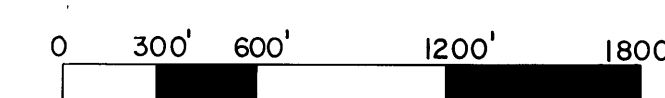

SCALE IN METERS 1mm = 7.2 m

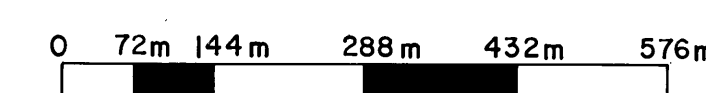

SECTIONS 21, 22 & 36, T105, R35 E, W.M.		
BAKER - GRANT COUNTIES, OREGON		
U.S.F.S. WALLOWA-WHITMAN NATIONAL FOREST		
SCALE 1" = 600' 1mm = 7.2 m	BARRY B. BARBOUR	SHEET NO. 1
DATE DEC., 1980	PROFESSIONAL LAND SURVEYOR	