


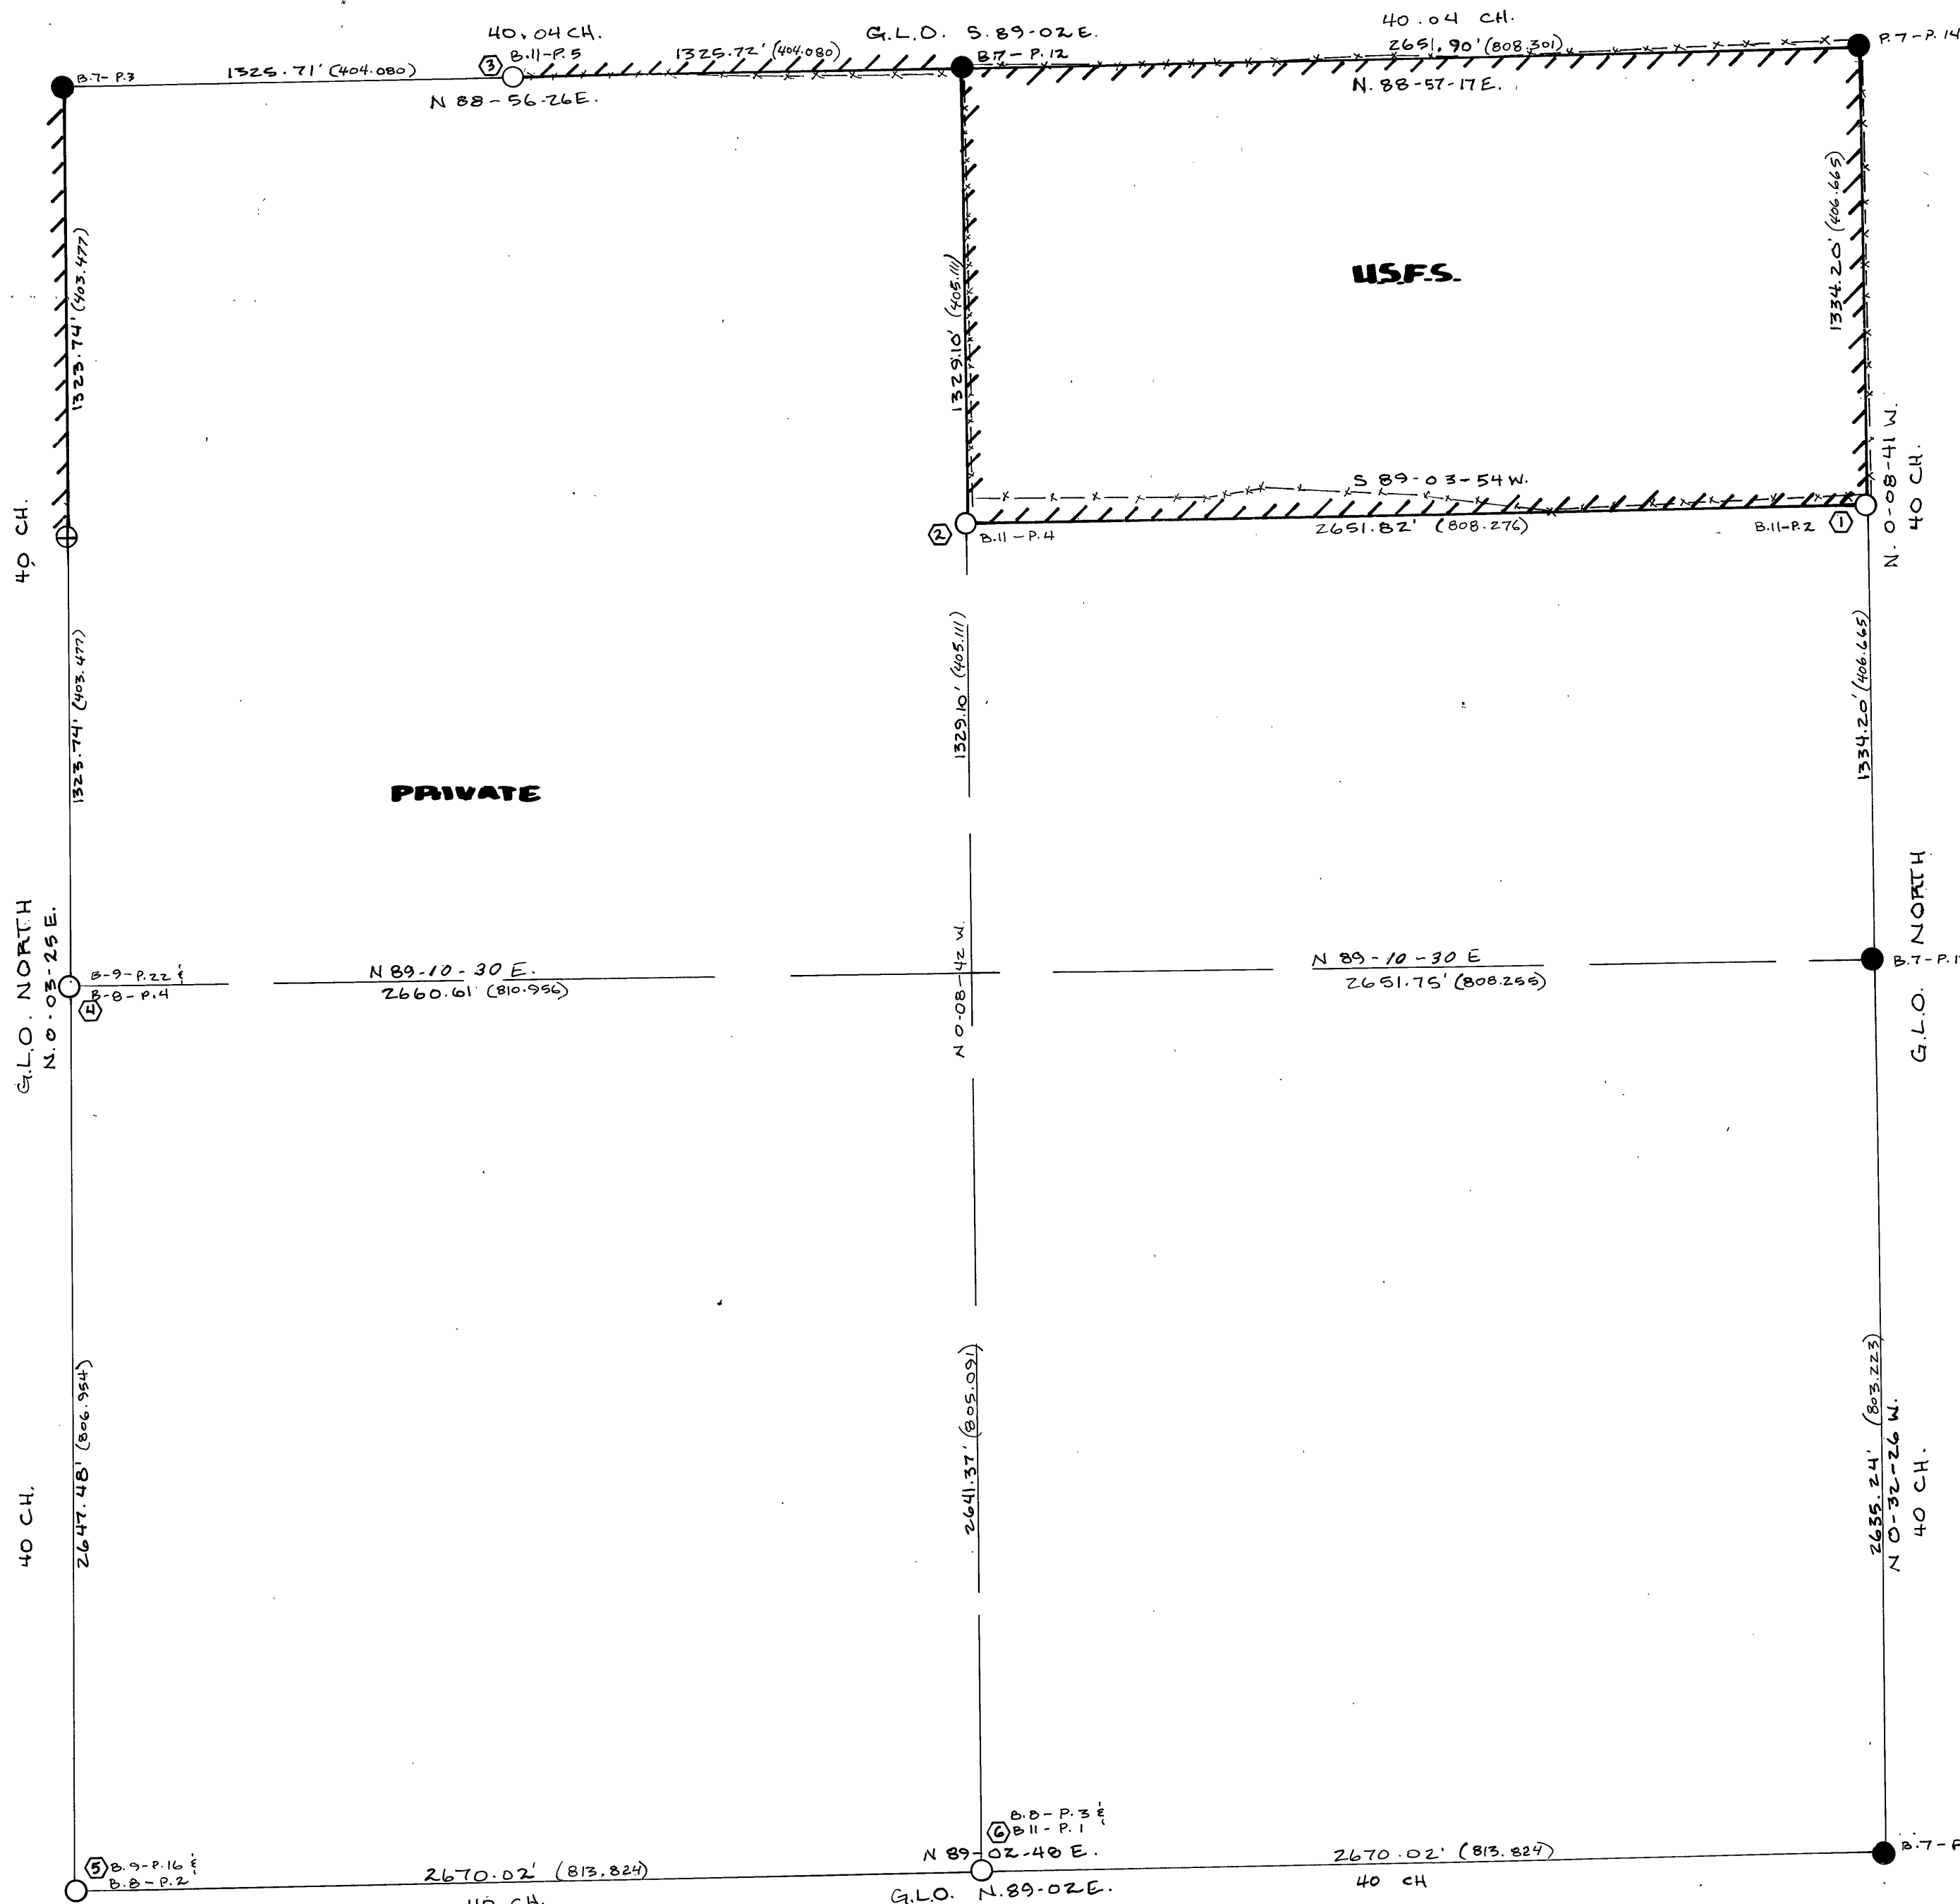

1. A 7" PINE BEARS S 78° E @ 10.9' SCRIBED N 1/16 S 35 UPPER BLAZE.

2. A 18" PINE BEARS N 44° W @ 64.3' SCRIBED N 1/16 S 34 UPPER BLAZE.

3. A 8" DOUGLAS FIR BEARS N 05° E @ 23.2' SCRIBED CN 1/16 S 34 UPPER BLAZE.

4. A 8" DOUGLAS FIR BEARS N 88° E @ 41.0' SCRIBED CN 1/16 S 34 UPPER BLAZE.

5. A 8" PINE BEARS S 10° E @ 54.3' SCRIBED W 1/16 S 34 UPPER BLAZE.

6. A 8" PINE BEARS N 15° W @ 33.8' SCRIBED W 1/16 S 27 UPPER BLAZE.

7. SEE U.S.F.S. FORM PG-7100-57 (9/71)

8. SEE U.S.F.S. FORM PG-7100-57 (9/71)

9. SEE U.S.F.S. FORM PG-7100-57 (9/71)

RECEIVED AND FILED

JAN 23 1981

OFFICE OF COUNTY SURVEYOR

Attest: *Robert D. Baggett*

BASIS OF BEARINGS - SOLAR OBSERVATIONS

1" = 400'

BAR SCALE

FEET 0 100 200 300 400 500 600 700 800 900 1000 1100 1200 1300 1400 1500 1600 1700 1800 1900 2000


3.280833' EQUALS 1 METER

PLAT OF SURVEY
USDA, FOREST SERVICE- REGION 6
UMATILLA NATIONAL FOREST

SMITH CREEK CADASTRAL
CONTRACT NO. 53-04R3-0-01147

LOCATION: SECTION 34, T.7S., R.31E., WM. GRANT COUNTY, ORE.

BISHOP SURVEYING
PO BOX 729 HOOD RIVER, ORE.
(503) 386-5122
DATE: DEC. 20, 1980
PROJECT NO. 80067

MAP OF SURVEY NO. 651