


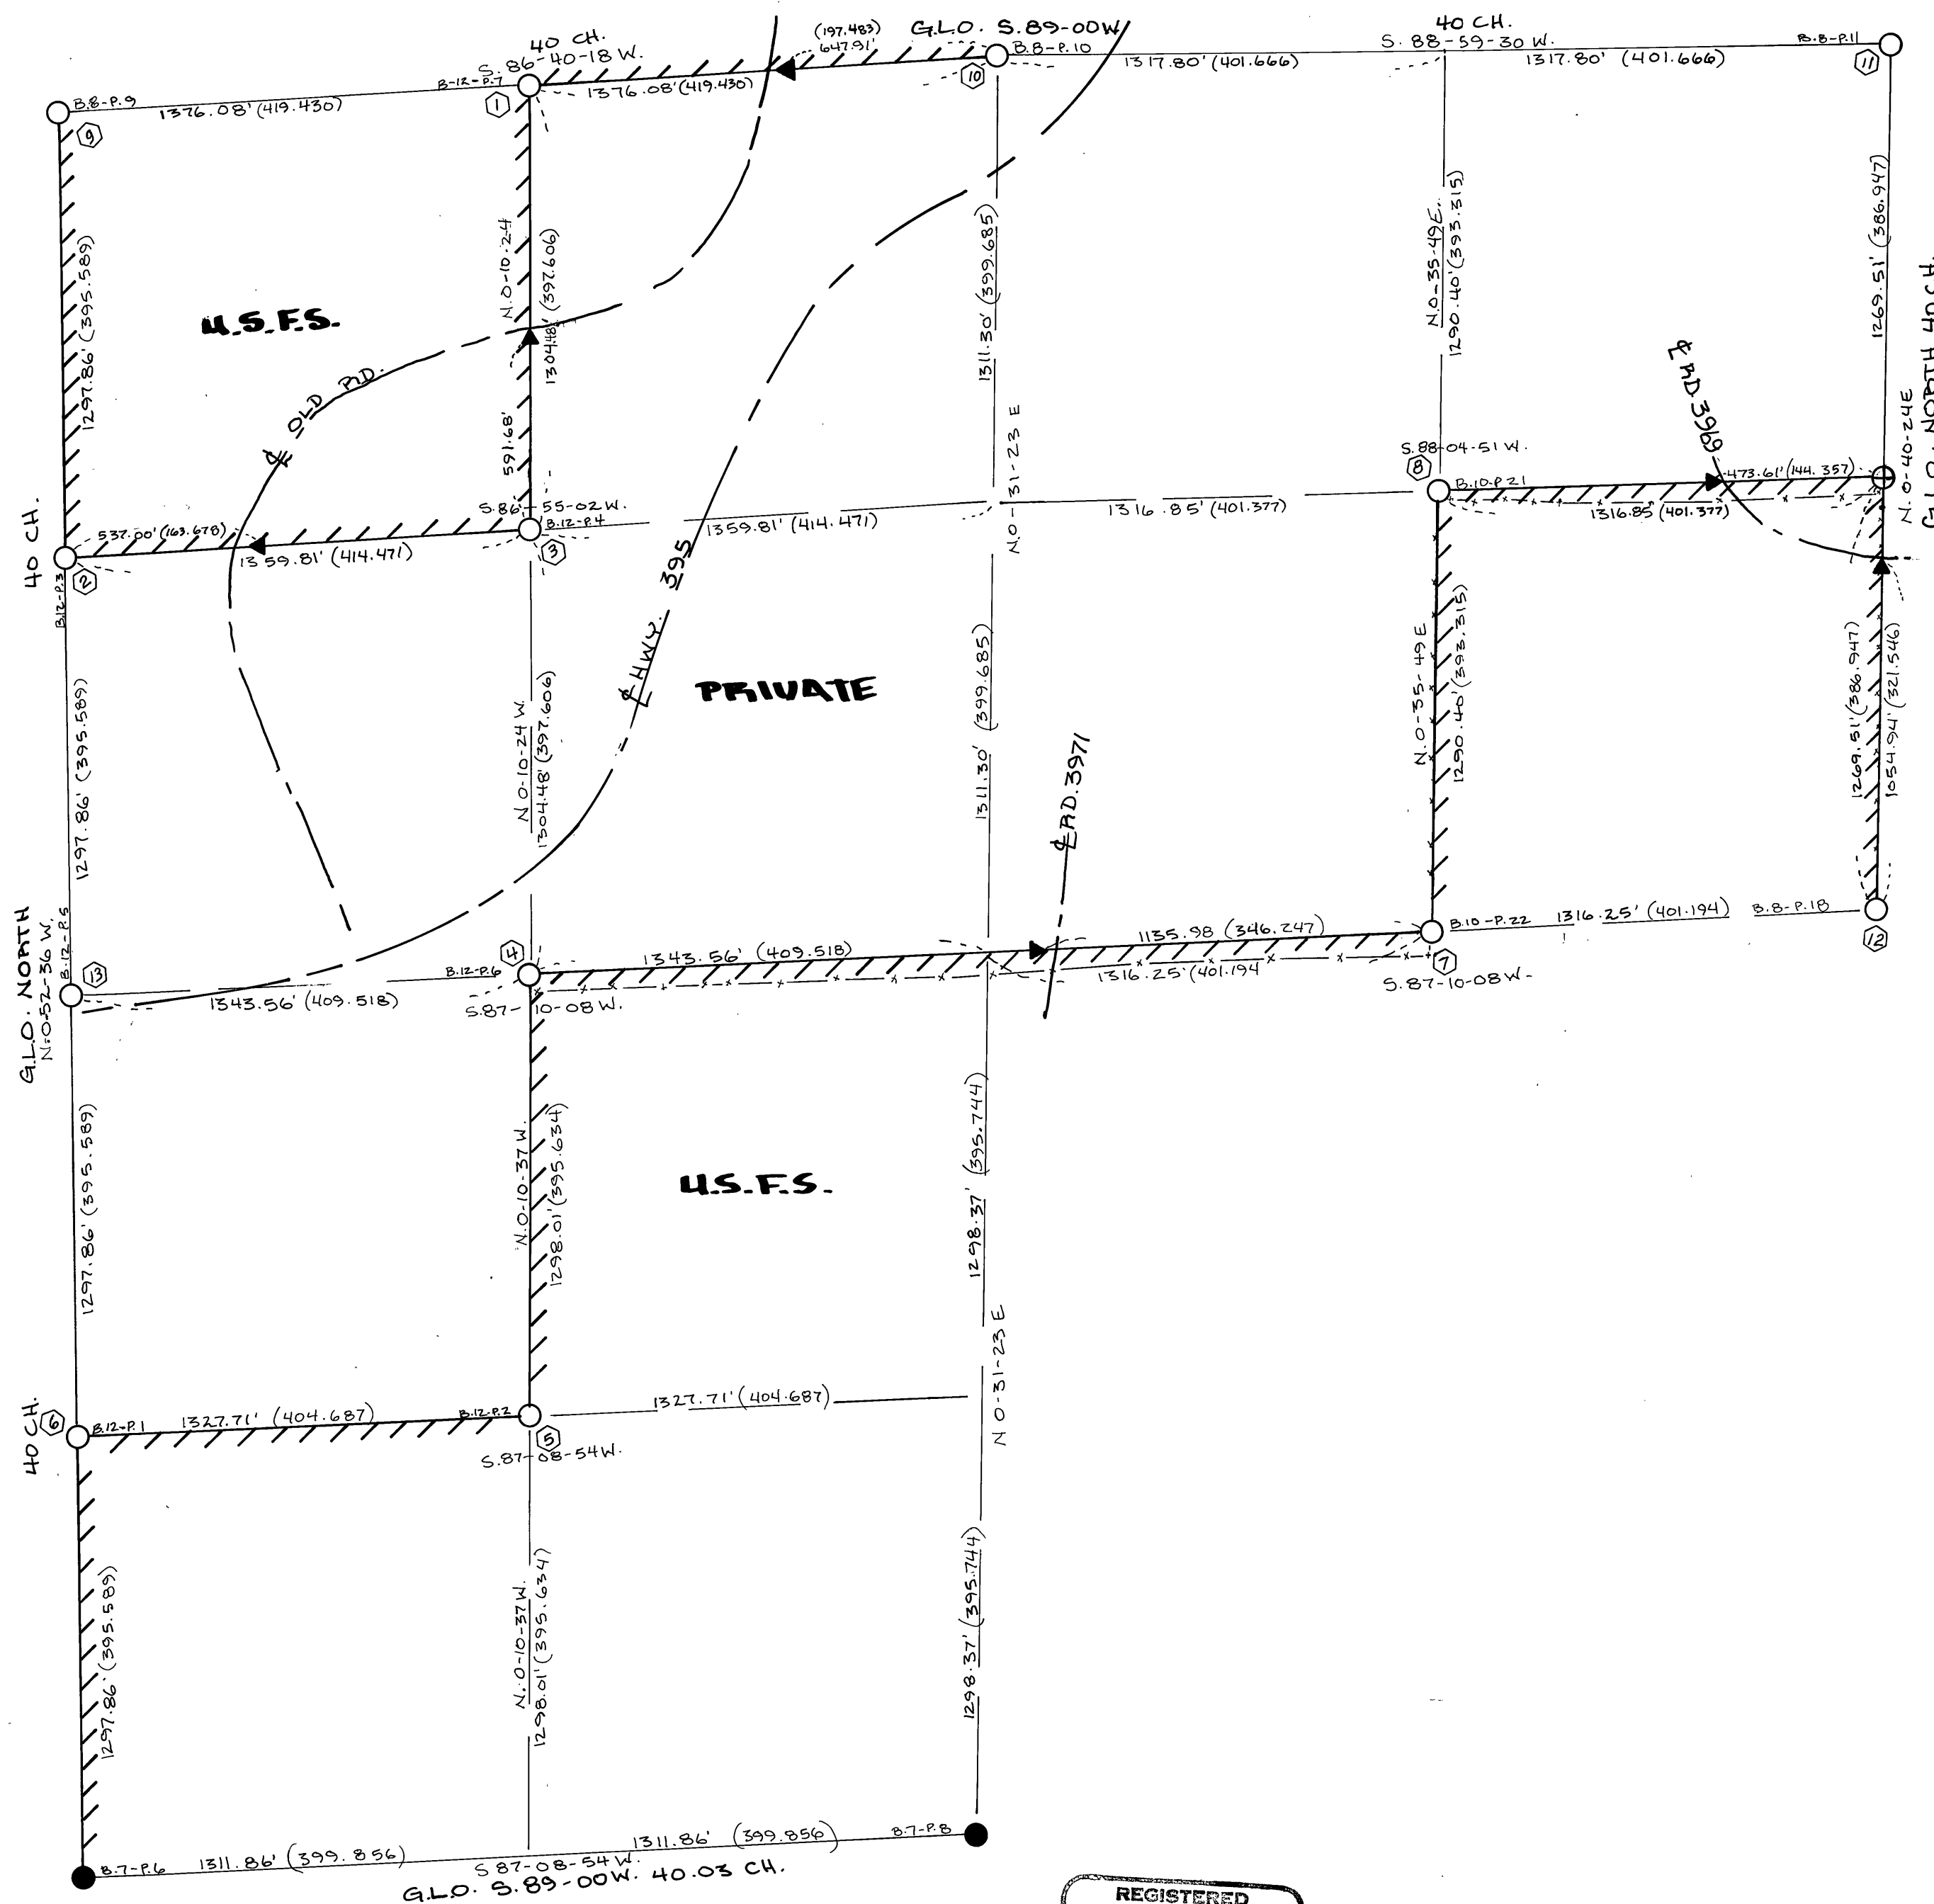


I, LARRY D. BISHOP, A REGISTERED LAND SURVEYOR IN THE STATE OF OREGON, HEREBY CERTIFY THAT THIS PLAT AND THE NOTES HEREON ARE A CORRECT REPRESENTATION OF A SURVEY I PERFORMED DURING SEPTEMBER, OCTOBER, NOVEMBER, AND DECEMBER, 1981, IN ACCORDANCE WITH THE STATUTES OF THE STATE OF OREGON AND THE ARTICLES OF MY CONTRACT.

Larry D. Bishop
LARRY D. BISHOP
REGISTERED LAND SURVEYOR NO. 896

HISTORY OF SURVEYS

THE SECTION WAS ORIGINALLY SURVEYED BY DEPUTY FOREST W. CAMPBELL IN JUNE, 1981 UNDER CONTRACT NO. 380

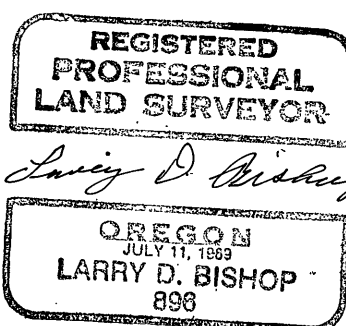

PLAT OF SURVEY USDA, FOREST SERVICE- REGION 6 UMATILLA NATIONAL FOREST

SMITH CREEK CADASTRAL
CONTRACT NO. 53-04R3-0-01147

LOCATION: SECTION 15, T.7 S., R. 31 E., WM. GRANT COUNTY, ORE.

1. 15 R31E
W 1/4 S10 S15
1981
PLS 896
A 6" JUNIPER BEAMS N 32° E
@ 81.1' SCRIEDED W 1/4 S 10
UPPER BLAZE.
2. 15 R31E
N 1/4 S15
1981
PLS 896
A 10" PINE BEAMS S 75° E.
@ 50.7' SCRIEDED N 1/4 S 15
UPPER BLAZE.
3. 15 R31E
NW 1/4 S15
1981
PLS 896
A 14" PINE BEAMS S 10° W
@ 35.2' SCRIEDED N 1/4 S 15
UPPER BLAZE.
4. 15 R31E
SW 1/4 S15
1981
PLS 896
A 7" PINE BEAMS N 45° E
@ 62.7' SCRIEDED SW 1/4 S 15
UPPER BLAZE.
5. 15 R31E
SW 1/4 S15
1981
PLS 896
A 6" PINE BEAMS N 13° W
@ 65.6' SCRIEDED SW 1/4 S 15
UPPER BLAZE.
6. 15 R31E
S 1/4 S15
1981
PLS 896
A 10" DOUGLAS FIR BEAMS N 82° E
@ 49.3' SCRIEDED S 1/4 S 15
UPPER BLAZE.
7. 15 R31E
E 1/4 S15
1981
PLS 896
A 6" JUNIPER BEAMS S 21° W
@ 131.8' SCRIEDED E 1/4 S 15
UPPER BLAZE.
8. 15 R31E
NE 1/4 S15
1981
PLS 896
A 9" JUNIPER BEAMS N 43 1/2° W
@ 170.6' SCRIEDED NE 1/4 S 15
UPPER BLAZE.
9. 15 R31E
NE 1/4 S15
1981
PLS 896
A 15" PINE BEAMS N 75° E
@ 49.6' SCRIEDED NE 1/4 S 15
UPPER BLAZE.
10. 15 R31E
NE 1/4 S15
1981
PLS 896
A 10" PINE BEAMS N 13° W
@ 48.0' SCRIEDED SW 1/4 S 15
UPPER BLAZE.

RECEIVED AND
FILED

FEB 10 1981


OFFICE OF COUNTY SURVEYOR

Attest: Robert D. Regatt
County Surveyor

BASIS OF BEARINGS - SOLAR
OBSERVATIONS

1" = 400'

BAR SCALE

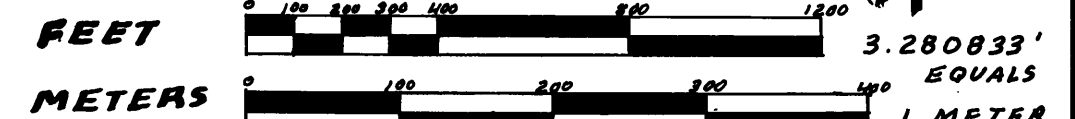

LEGEND

- SET 2 1/2" GALVANIZED STEEL PIPE 30" LONG WITH A 2 1/2" BRASS CAP STAMPED AS SKETCHED ABOVE
- FOUND BRASS CAP OF RECORD
- ⊕ CORNER AND ITS ACCESSORIES DESCRIBED ON THE PLAT OF THE ADJACENT SECTION FILED AS A
- ▼ SET 4" X 4" X 6' WOOD POST WITH SIGN 54-2 & 54-5
- X—X— FENCE
- ||||| ALL BEARING TREES MARKED DURING THIS SURVEY HAVE A RED BAND SIGN 54-3, SIGN 54-4, OR 54-9 AND A LOWER BLAZE SCRIEDED 87 AND WITH A BRASS DISH STAMPED PLS 896
- ||||| PROPERTY LINE POSTED WITH STEEL FENCE POSTS AND SIGN 54-2
- (219.312) DISTANCE IN METERS (BEP = BOOK & PAGE)
- SET STEEL GUARD POST WITH SIGN 54-2 & 54-9 AT CORNERS SET TWO AT GOVT. PROPERTY CORNERS

BISHOP SURVEYING
PO BOX 729 HOOD RIVER, ORE.
(503) 386-5122
DATE:
PROJECT NO. 80067