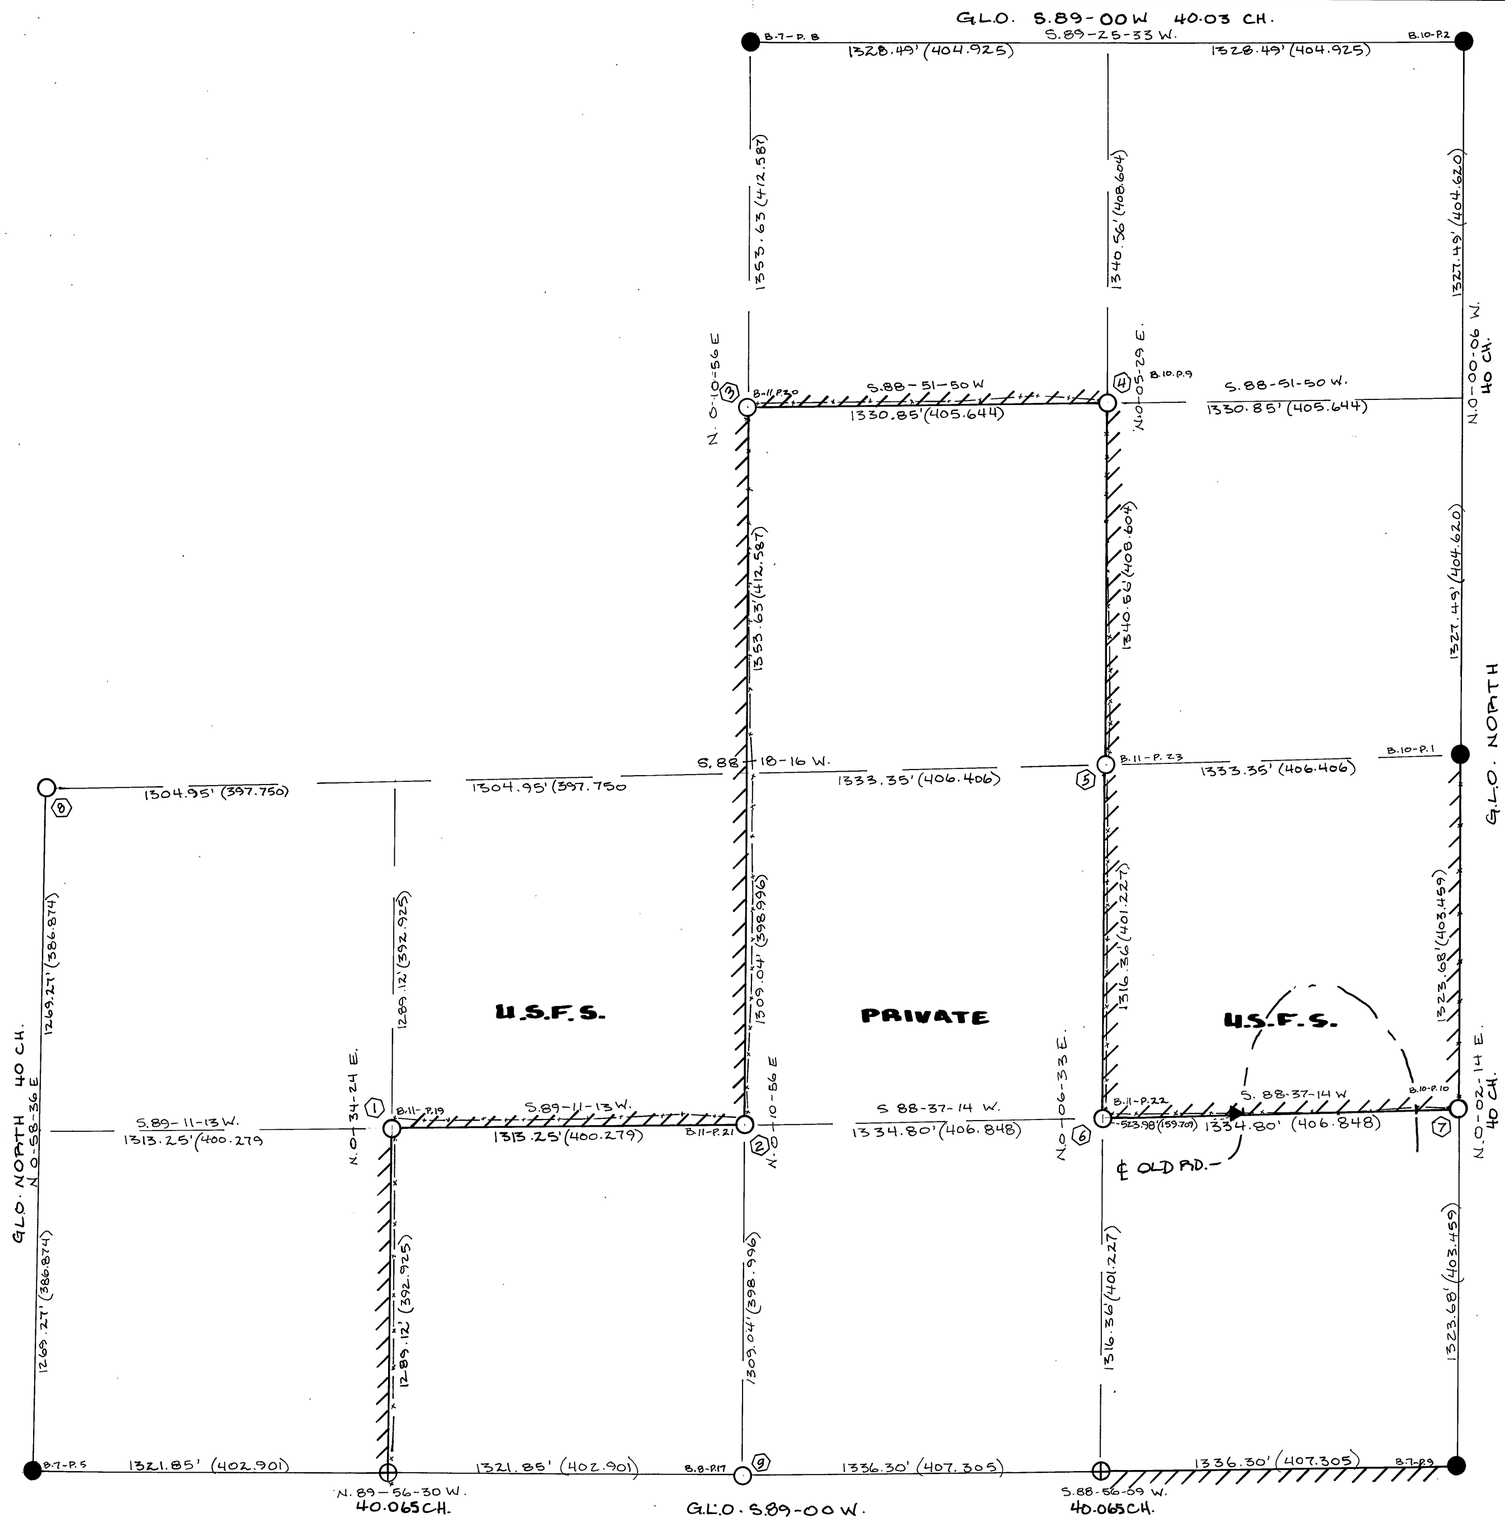

1. A 8" JUNIPER BEARS N21° E. @ 278.2' SCRIBED SW.1/16 S 22 UPPER BLAZE.
   A 9" PINE BEARS N 36° E @ 127.6' SCRIBED SW 1/16 S 22 UPPER BLAZE.

2. A 11" DOUGLAS FIR BEARS S.28° W. @ 20.2' SCRIBED CS 1/16 S 22 UPPER BLAZE.
   A 7" PINE BEARS N 74° W @ 10.0' SCRIBED CS 1/16 S 22 UPPER BLAZE.

3. A 8" DOUGLAS FIR BEARS S 16° W. @ 22.3' SCRIBED CN 1/16 S 22 UPPER BLAZE.
   A 12" DOUGLAS FIR BEARS N.12° W. @ 29.5' SCRIBED CN 1/16 S 22 UPPER BLAZE.

4. A 6" JUNIPER BEARS S 50° E @ 183.1' SCRIBED NE 1/16 S 22 UPPER BLAZE
   A 8" PINE BEARS S 20° E @ 209.0' SCRIBED NE 1/16 S 22 UPPER BLAZE

5. A 6" DOUGLAS FIR BEARS N 76½° E @ 9.2' SCRIBED CE 1/16 S 22 UPPER BLAZE.
   A 7" DOUGLA FIR BEARS S 51° W @ 3.2' SCRIBED CE 1/16 S 22 UPPER BLAZE.

6. A 8" PINE BEARS N 22° E @ 22.1' SCRIBED SE 1/16 S 22 UPPER BLAZE.
   A 8" PINE BEARS N 38° W @ 4.3' SCRIBED SE 1/16 S 22 UPPER BLAZE.

7. A 9" PINE BEARS S 82½° E @ 14.8' SCRIBED S 1/16 S 23 UPPER BLAZE.
   A 10" PINE BEARS N 11° W @ 24.7' SCRIBED S 1/16 S 22 UPPER BLAZE

8. SEE U.S.F.S FORM R6-7100-57 (9/71)
9. " " " " " " "

RECEIVED AND
FILED
FEB 10 1981
OFFICE OF COUNTY SURVEYOR
Attest: [signature]

BASIS OF BEARINGS - SOLAR OBSERVATIONS
1" = 400'
BAR SCALE

FEET 0 100 200 300 400 800 1200
METERS 0 100 200 300 400
3.280833' EQUALS 1 METER

LEGEND

- ○ SET 2½" GALVANIZED STEEL PIPE 30" LONG WITH A 2½" BRASS CAP STAMPED AS SKETCHED ABOVE
- ● FOUND BRASS CAP OF RECORD
- ⊕ CORNER AND ITS ACCESSORIES DESCRIBED ON THE PLAT OF THE ADJACENT SECTION FILED AS A PORTION OF THIS SURVEY
- ▼ SET 4" X 4" X 6' WOOD POST WITH SIGN 54-2 & 54-5
- —x—x— FENCE
- ALL BEARING TREES MARKED DURING THIS SURVEY HAVE A 6" RED BAND, SIGN 54-3, SIGN 54-4 OR 54-9 AND A LOWER BLAZE SCRIBED BY AND WITH A BRASS DISK STAMPED PLS 896
- //////// PROPERTY LINE POSTED WITH STEEL FENCE POSTS AND SIGN 54-2
- (219.3/2) DISTANCE IN METERS (B & P = BOOK & PAGE)
- SET STEEL GUARD POST WITH SIGN 54-2 & 54-4 OR 54-9 AT CORNERS SET (TWO AT GOVT. PROPERTY CORNERS)

I, LARRY D. BISHOP, A REGISTERED LAND SURVEYOR IN THE STATE OF OREGON HEREBY CERTIFY THAT THIS PLAT AND THE NOTES HEREON ARE A CORRECT REPRESENTATION OF A SURVEY I PERFORMED DURING SEPT-OCT-NOV-DEC. 1980 FOR THE U.S. FOREST SERVICE IN ACCORDANCE WITH THE STATUTES OF THE STATE OF OREGON & THE ARTICLES OF MY CONTRACT.

Larry D. Bishop
LARRY D. BISHOP
REGISTERED LAND SURVEYOR NO. 896

REGISTERED PROFESSIONAL LAND SURVEYOR
Larry D. Bishop
OREGON JULY 11, 1969 LARRY D. BISHOP 896

HISTORY OF SURVEYS

THE SECTION WAS ORIGINALLY SURVEYED BY DEPUTY FOREST W. CAMPBELL IN JUNE, 1881 UNDER CONTRACT NO. 380

PLAT OF SURVEY
USDA, FOREST SERVICE - REGION 6
UMATILLA NATIONAL FOREST
SMITH CREEK CADASTRAL
CONTRACT NO. 53-04R3-0-01147

BISHOP SURVEYING
PO BOX 729 HOOD RIVER, ORE.
(503) 386-5122
DATE:
PROJECT NO. 80067

LOCATION: SECTION 22, T. 7 S., R. 31 E., WM. GRANT COUNTY, ORE.

MAP OF SURVEY NO. 656