


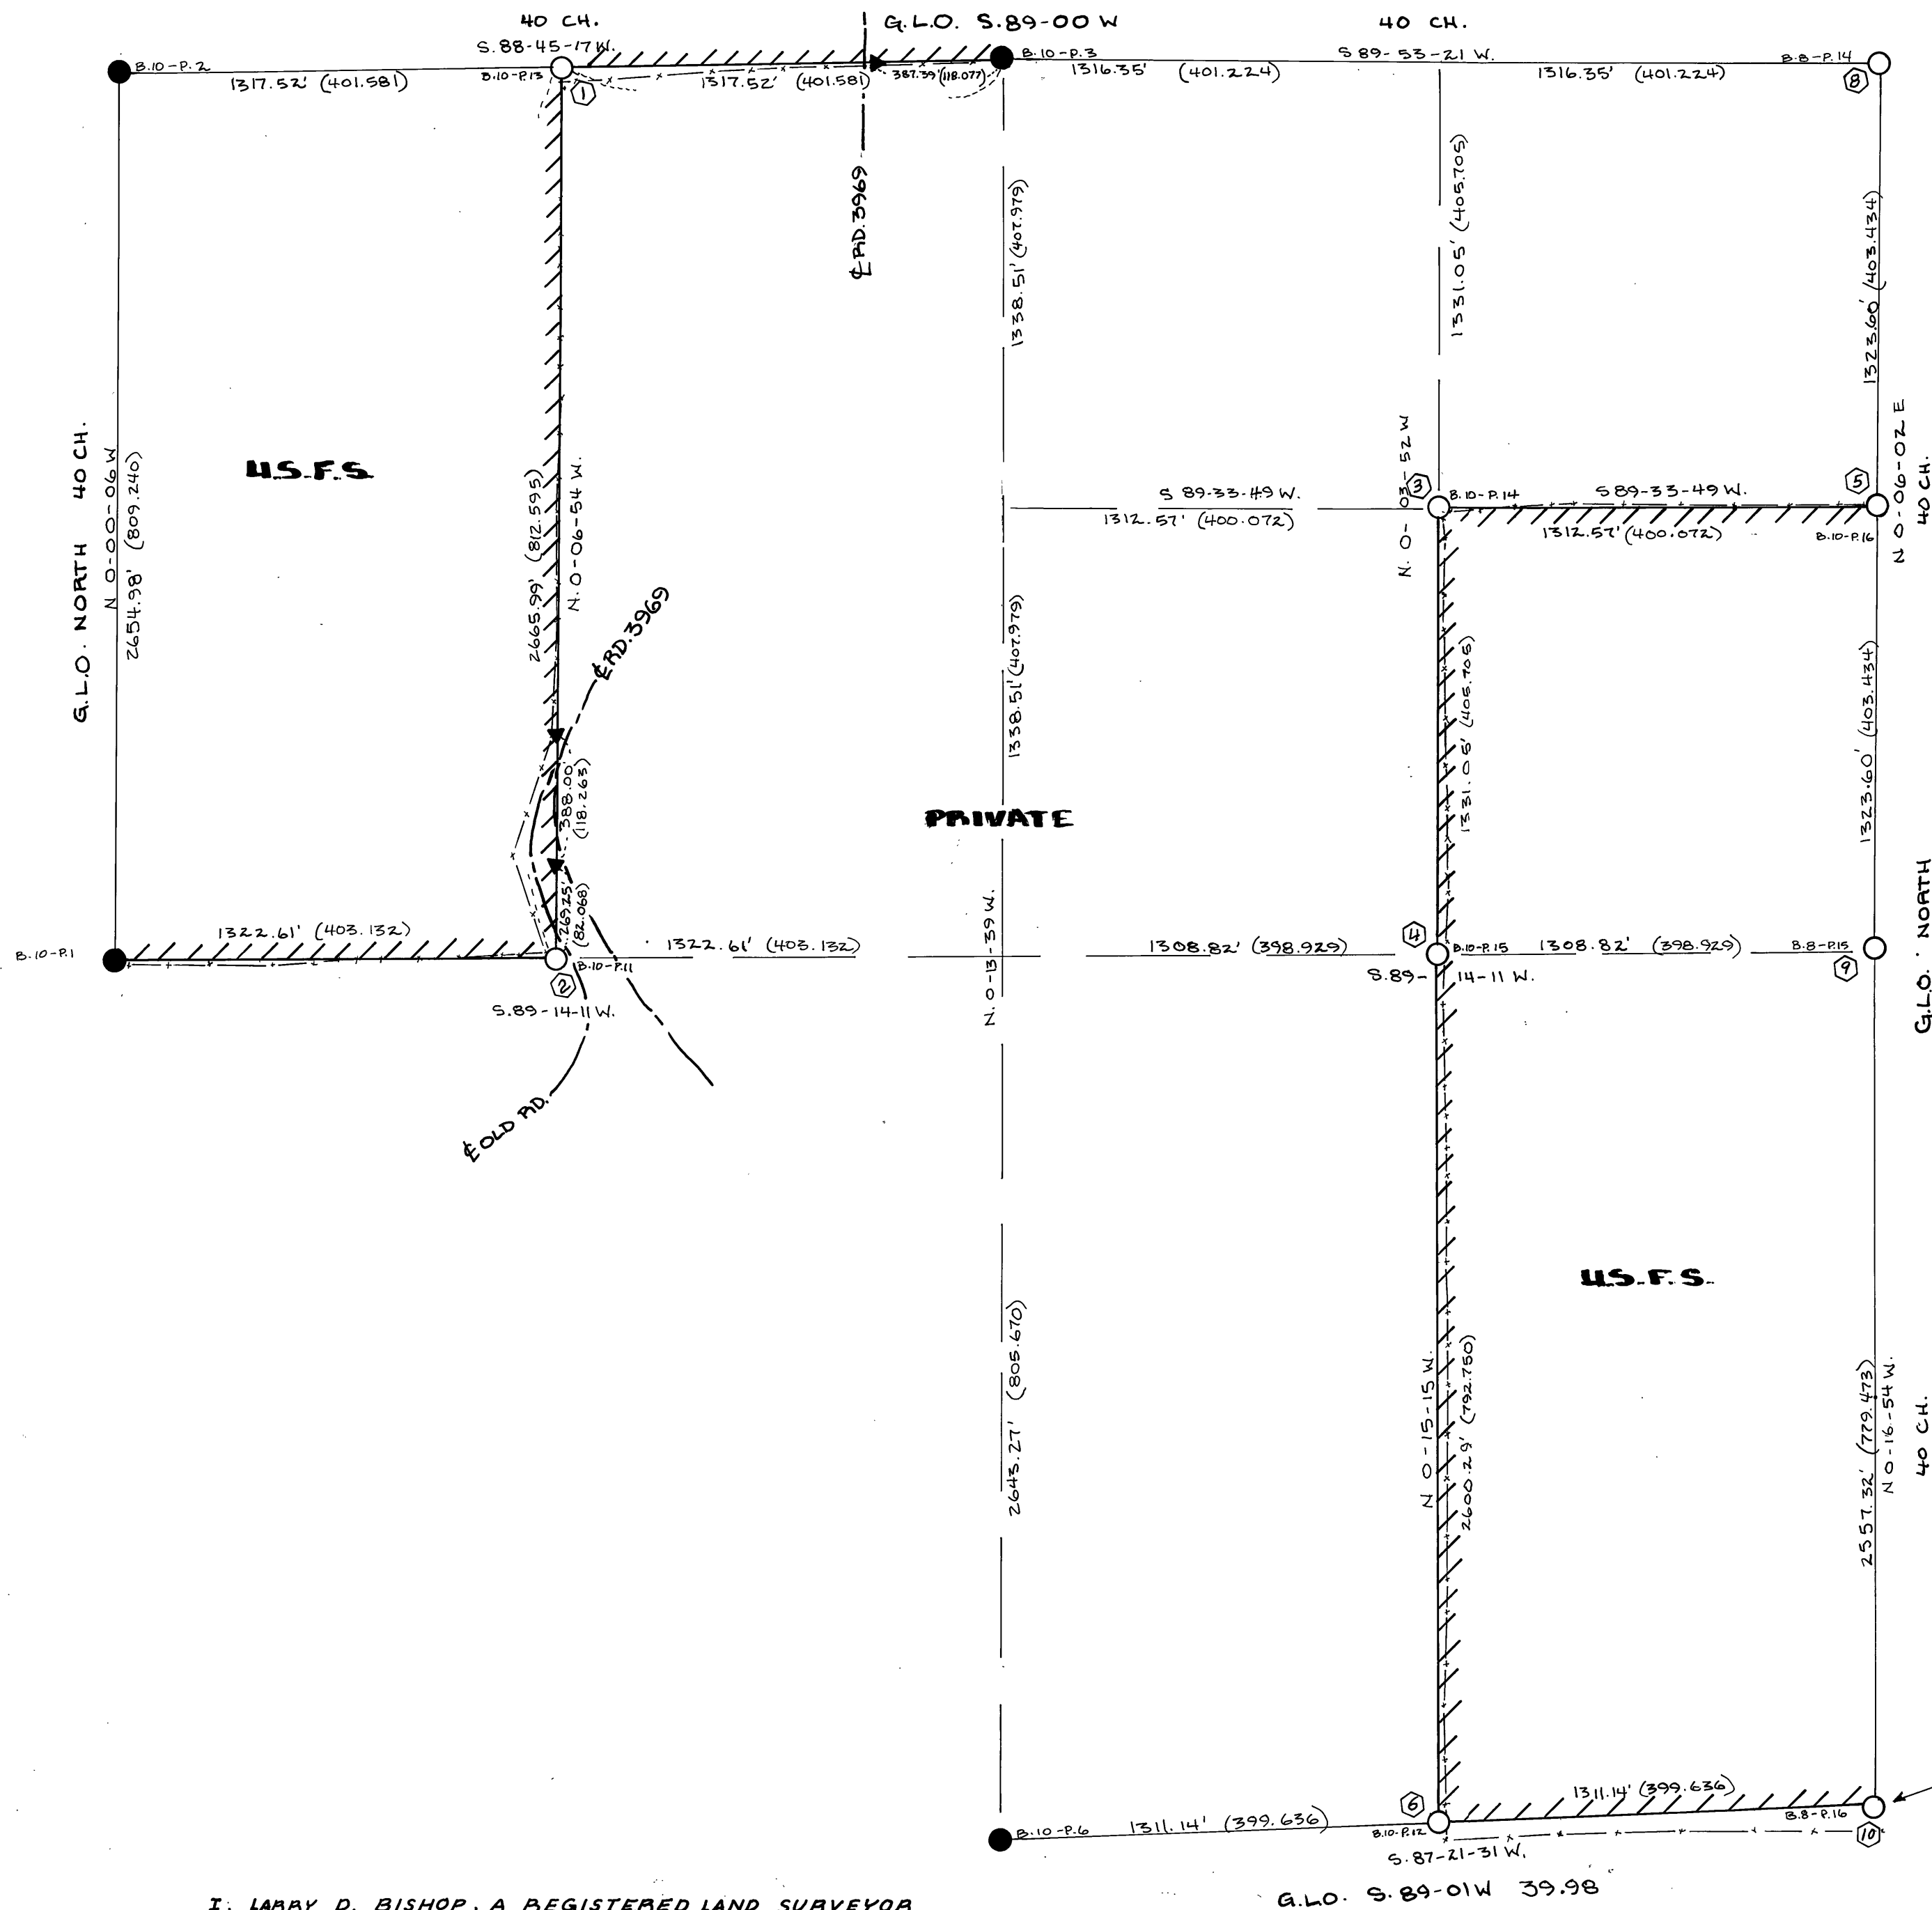

- 1. 15' R31E S14 W 1/16 S23 1981 PLS 896
- 2. 15' R31E C W 1/16 S23 1981 PLS 896
- 3. 15' R31E NE 1/16 S23 1981 PLS 896
- 4. 15' R31E E 1/16 S23 1981 PLS 896
- 5. 15' R31E N 1/16 S24 1981 PLS 896
- 6. 15' R31E E 1/16 S26 1981 PLS 896


RECEIVED AND
FILED

FEB 10 1981

OFFICE OF COUNTY SURVEYOR

Attest: *Robert D. Bishop*

BASIS OF BEARINGS - SOLAR
OBSERVATIONS
1" = 400'
BAR SCALE

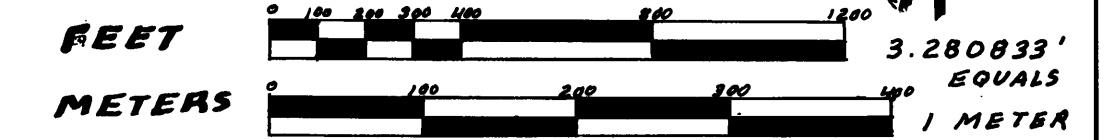

LEGEND

- SET 2 1/2" GALVANIZED STEEL PIPE, 30" LONG WITH A 2 1/2" BRASS CAP STAMPED AS SHOWN ABOVE
- FOUND BRASS CAP OF RECORD
- ⊕ CORNER AND ITS ACCESSORIES DESCRIBED ON THE PLAT OF THE ADJACENT SECTION FILED AS A PORTION OF THIS SURVEY
- ▽ SET 4" x 4" x 6' WOOD POST WITH SIGN 54-2 & 54-5
- FENCE
- ||||| ALL BEARING TREES MARKED DURING THIS SURVEY HAVE A 6" RED BAND, SIGN 54-3, SIGN 54-4, OR 54-5 AND A LOWER BAND, SIGN 54-6, AND WITH A BRASS DISH STAMPED PLS 896
- PROPERTY LINE POSTED WITH STEEL FENCE POSTS AND SIGN 54-2
- (219.312) DISTANCE IN METERS (C.R.P. = BOOK & PAGE)
- ▽ SET STEEL GUARD POST WITH SIGN 54-2 & 54-4 OR 54-5 AT CORNERS SET (TWO AT GOVT. PROPERTY CORNERS)

I, LARRY D. BISHOP, A REGISTERED LAND SURVEYOR IN THE STATE OF OREGON, HEREBY CERTIFY THAT THIS PLAT AND THE NOTES HEREON ARE A CORRECT REPRESENTATION OF A SURVEY PERFORMED DURING SEPT.-OCT.-NOV.-DEC. 1980 FOR THE U.S. FOREST SERVICE IN ACCORDANCE WITH THE STATUTES OF THE STATE OF OREGON & THE ARTICLES OF MY CONTRACT.

Larry D. Bishop
LARRY D. BISHOP
REGISTERED LAND SURVEYOR NO. 896

HISTORY OF SURVEYS

THE SECTION WAS ORIGINALLY SURVEYED BY DEPUTY FOREST W. CAMPBELL IN JUNE, 1881 UNDER CONTRACT NO. 380

REGISTERED
PROFESSIONAL
LAND SURVEYOR
Larry D. Bishop
OREGON
LARRY D. BISHOP
896

PLAT OF SURVEY
USDA, FOREST SERVICE- REGION 6
UMATILLA NATIONAL FOREST
SMITH CREEK CADASTRAL
CONTRACT NO. 53-04R3-0-01147

LOCATION: SECTION 23, T.7S., R.31E., WM. GRANT COUNTY, ORE.

BISHOP SURVEYING
PO BOX 729 HOOD RIVER, ORE.
(503) 386-5122
DATE:
PROJECT NO. 80067