


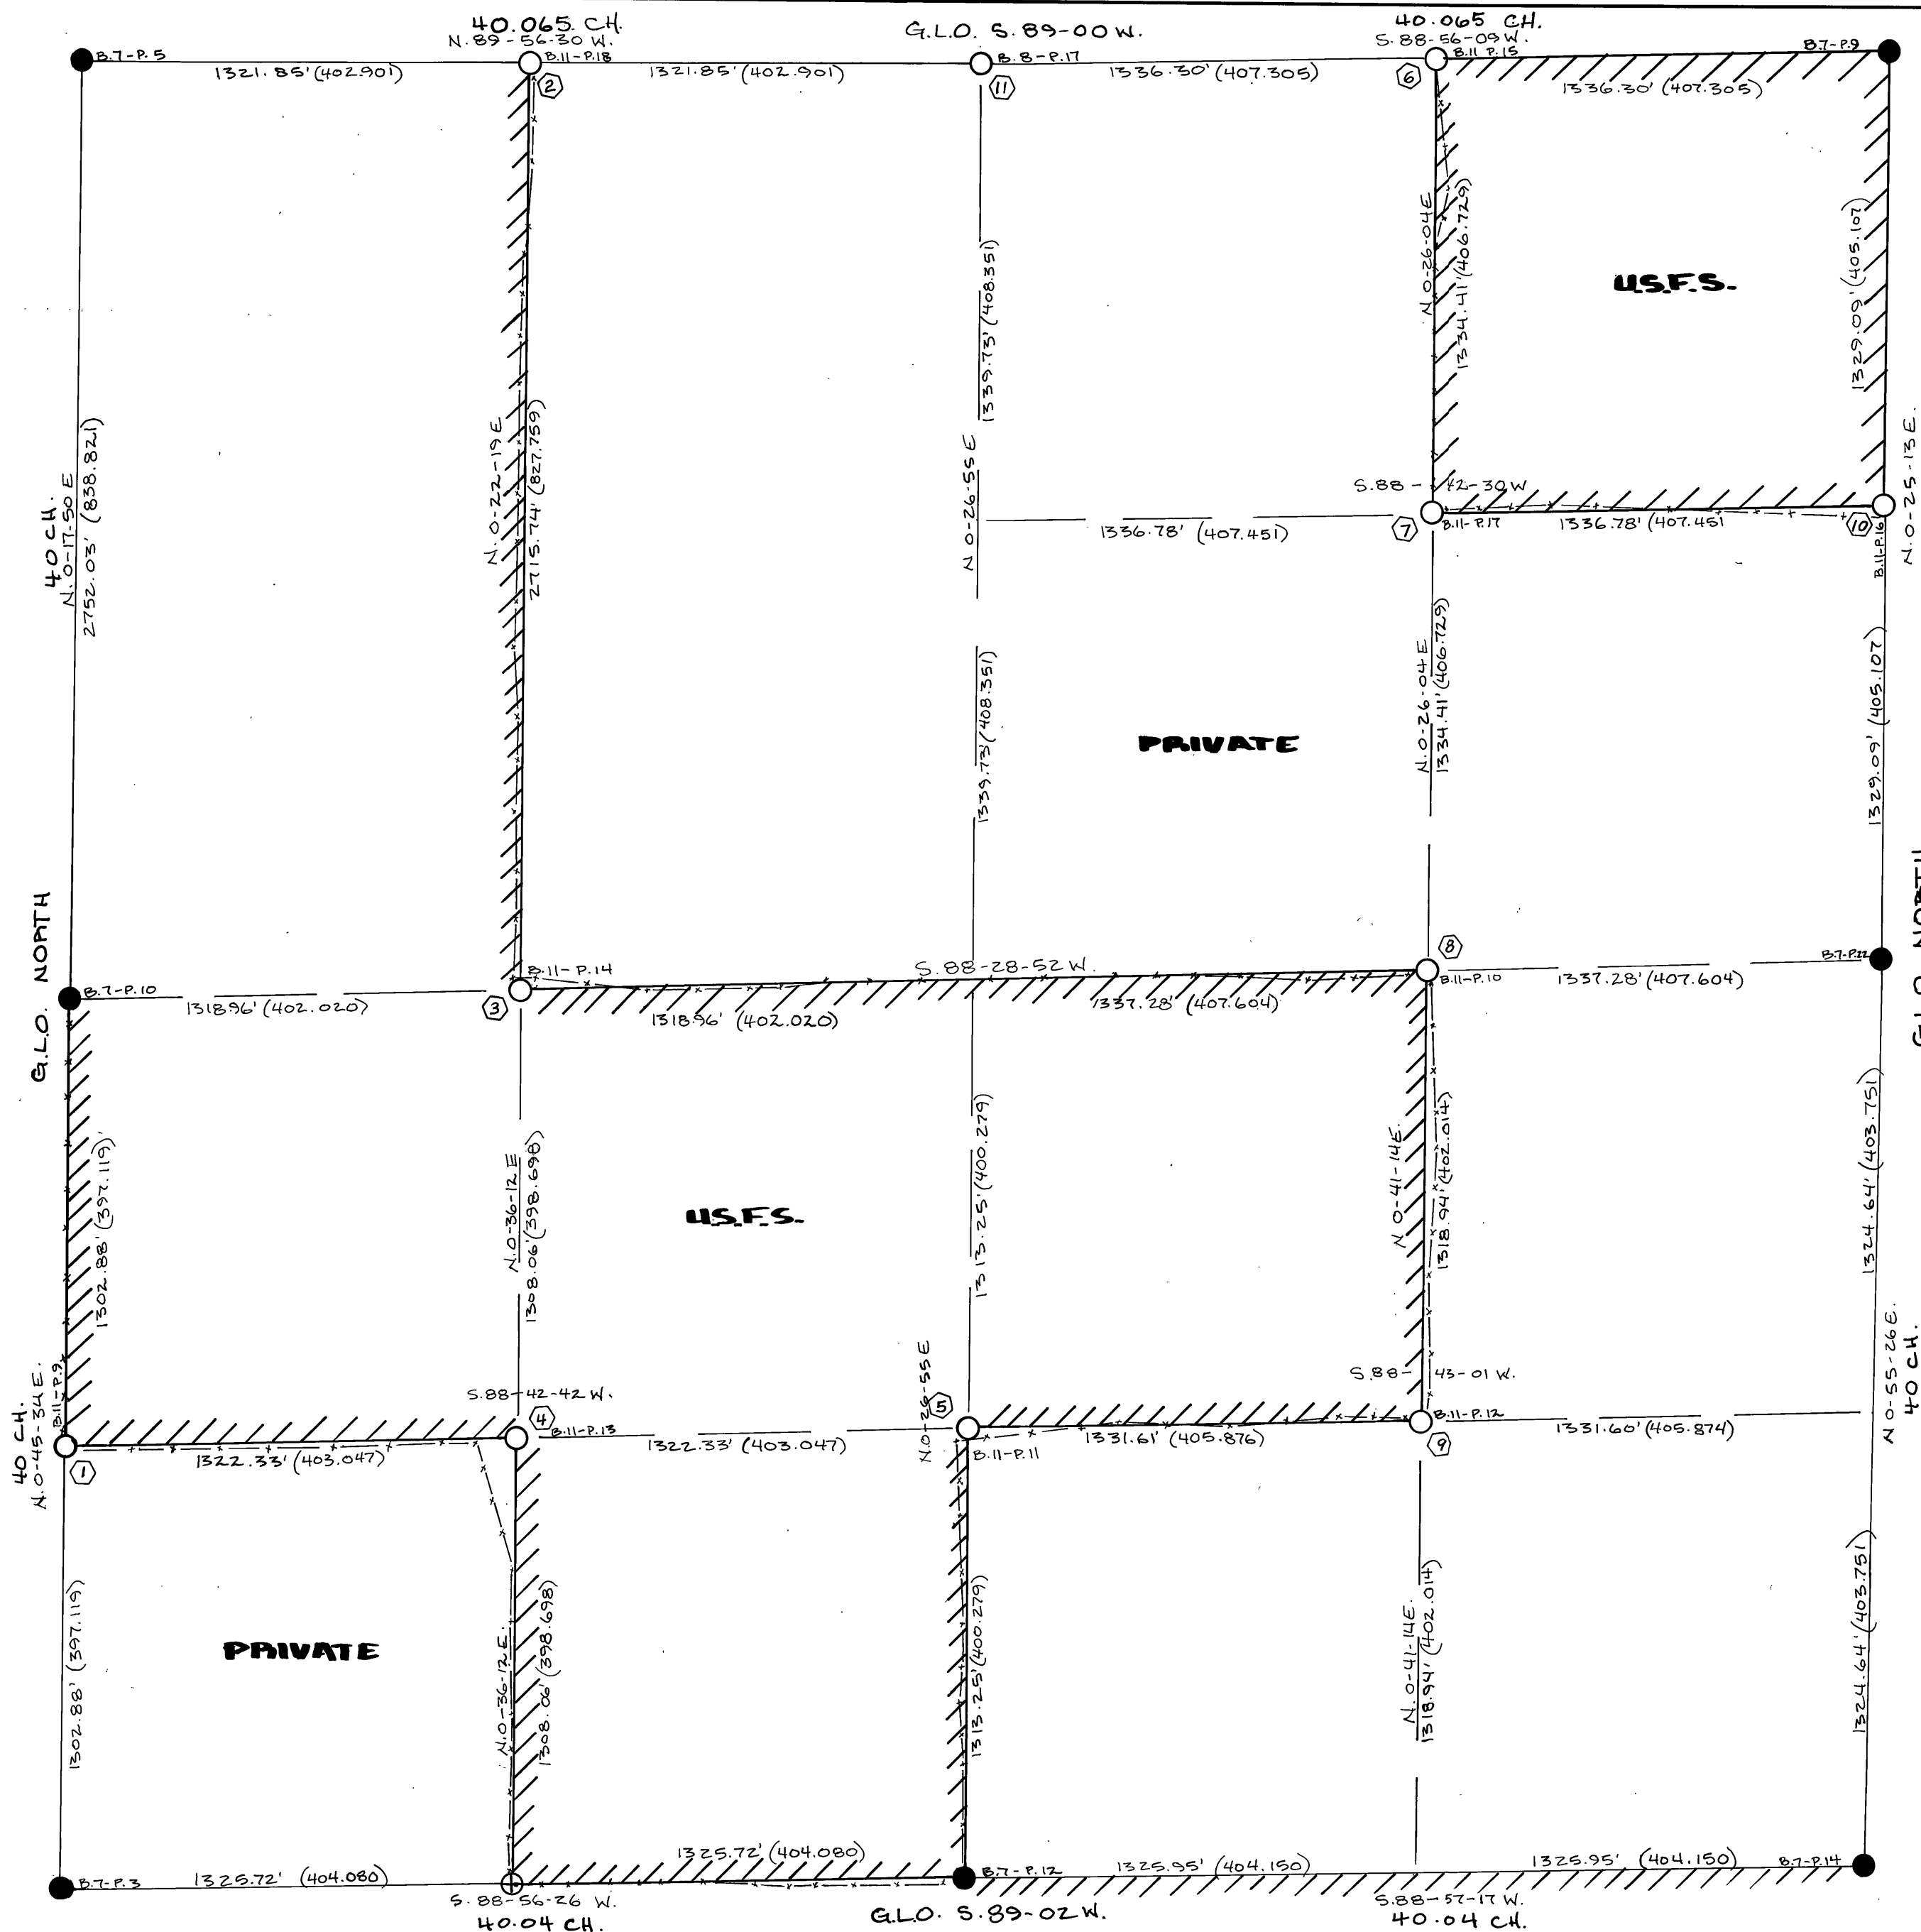

1. 15" DOUGLAS FIR BEAMS N53°E @ 15.5' SCRIBED S 1/16 S 27 UPPER BLAZE.
2. 6" PINE BEAMS S80°W @ 15.1' SCRIBED S 1/16 S 28 UPPER BLAZE.
3. 14" PINE BEAMS S. 71°W @ 81.2' SCRIBED W 1/16 S 27 UPPER BLAZE.
4. 11" PINE BEAMS N14°W @ 15.1' SCRIBED S 1/16 S 27 UPPER BLAZE.
5. 7" PINE BEAMS S 76°E @ 30.0' SCRIBED CW 1/16 S 27 UPPER BLAZE.
6. 10" PINE BEAMS S. 86°W @ 27.3' SCRIBED CW 1/16 S 27 UPPER BLAZE.
7. 7" PINE BEAMS N85°W @ 42.2' SCRIBED SW 1/16 S 27 UPPER BLAZE.
8. 14" DOUGLAS FIR BEAMS N28°W @ 20.8' SCRIBED SW 1/16 S 27 UPPER BLAZE.
9. 12" PINE BEAMS N56°E @ 26.2' SCRIBED S 1/16 S 27 UPPER BLAZE.
10. 11" PINE BEAMS N39°W @ 33.3' SCRIBED CS 1/16 S 27 UPPER BLAZE.
11. 10" LARCH BEAMS S37°W @ 15.1' SCRIBED E 1/16 S 27 UPPER BLAZE.
12. 13" DOUGLAS FIR BEAMS N56°W @ 36.3' SCRIBED E 1/16 S 22 UPPER BLAZE.
13. 15" DOUGLAS FIR BEAMS N. 24°E @ 57.2' SCRIBED NE 1/16 S 27 UPPER BLAZE.
14. 8" PINE BEAMS S84°E @ 20.9' SCRIBED NE 1/16 S 27 UPPER BLAZE.
15. 9" PINE BEAMS S. 4°W @ 55.3' SCRIBED CE 1/16 S 27 UPPER BLAZE.
16. 10" PINE BEAMS S45°W @ 65.6' SCRIBED CE 1/16 S 27 UPPER BLAZE.
17. 8" PINE BEAMS N36°W @ 24.2' SCRIBED SE 1/16 S 27 UPPER BLAZE.
18. 8" PINE BEAMS N. 2°W @ 26.1' SCRIBED SE 1/16 S 27 UPPER BLAZE.
19. 6" JUNIPER BEAMS N. 41°E @ 53.7' SCRIBED N 1/16 S 26 UPPER BLAZE.
20. 16" PINE BEAMS N4°W @ 69.8' SCRIBED N 1/16 S 27 UPPER BLAZE.

11 SEE U.S.F.S. FORM R-6-7100-57 (9/71)

RECEIVED AND
FILED

FEB 10 1981


OFFICE OF COUNTY SURVEYOR

Attest: *[Signature]*

**BASIS OF BEARINGS - SOLAR
OBSERVATIONS**

1" = 400'

BAR SCALE

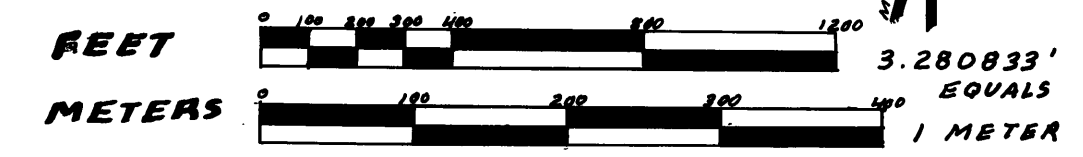

LEGEND

- SET 2 1/2" GALVANIZED STEEL PIPE 30" LONG WITH A 2 1/2" BRASS CAP STAMPED AS SKETCHED ABOVE
- FOUND BRASS CAP OF RECORD
- ⊕ CORNER AND ITS ACCESSORIES DESCRIBED ON THE PLAT OF THE ADJACENT SECTION FILED AS A PART OF THIS SURVEY
- ▼ SET 4" X 4" X 6' WOOD POST WITH SIGN 54-2 & 54-5 FENCE
- ALL BEARING TREES MARKED DURING THIS SURVEY HAVE A RED BAND SIGN 54-3, SIGN 54-4, AND A LOWER BLAZE SCRIBED BY AND WITH A BRASS DISH STAMPED PLS 896
- ~~~~~ PROPERTY LINE POSTED WITH STEEL FENCE POSTS AND SIGN 54-2
- (219.312) DISTANCE IN METERS (D & P = BOOK & PAGE)
- SET STEEL GUARD POST WITH SIGN 54-2 & 54-4 OR 54-9 AT CORNERS SET (TWO AT GOVT. PROPERTY CORNERS)

I, LARRY D. BISHOP, A REGISTERED LAND SURVEYOR IN THE STATE OF OREGON, HEREBY CERTIFY THAT THIS PLAT AND THE NOTES HEREON ARE A CORRECT REPRESENTATION OF A SURVEY PERFORMED DURING A SEPT.-OCT.-NOV. SURVEY 1980 WITH THE U.S. FOREST SERVICE IN ACCORDANCE WITH THE STATUTES OF THE STATE OF OREGON, THE ARTICLES OF MY CONTRACT.

Larry D. Bishop
LARRY D. BISHOP
REGISTERED LAND SURVEYOR NO. 896



**PLAT OF SURVEY
USDA, FOREST SERVICE- REGION 6
UMATILLA NATIONAL FOREST
SMITH CREEK CADASTRAL
CONTRACT NO. 53-04R3-0-01147**

HISTORY OF SURVEYS
THE SECTION WAS ORIGINALLY SURVEYED BY DEPUTY FOREST W. CAMPBELL IN JUNE, 1891 UNDER CONTRACT NO. 380

LOCATION: SECTION 27, T. 7 S., R. 31 E., WM. GRANT COUNTY, ORE.

BISHOP SURVEYING
PO BOX 729 HOOD RIVER, ORE.
(503) 386-5122
DATE: _____
PROJECT NO. 80067