


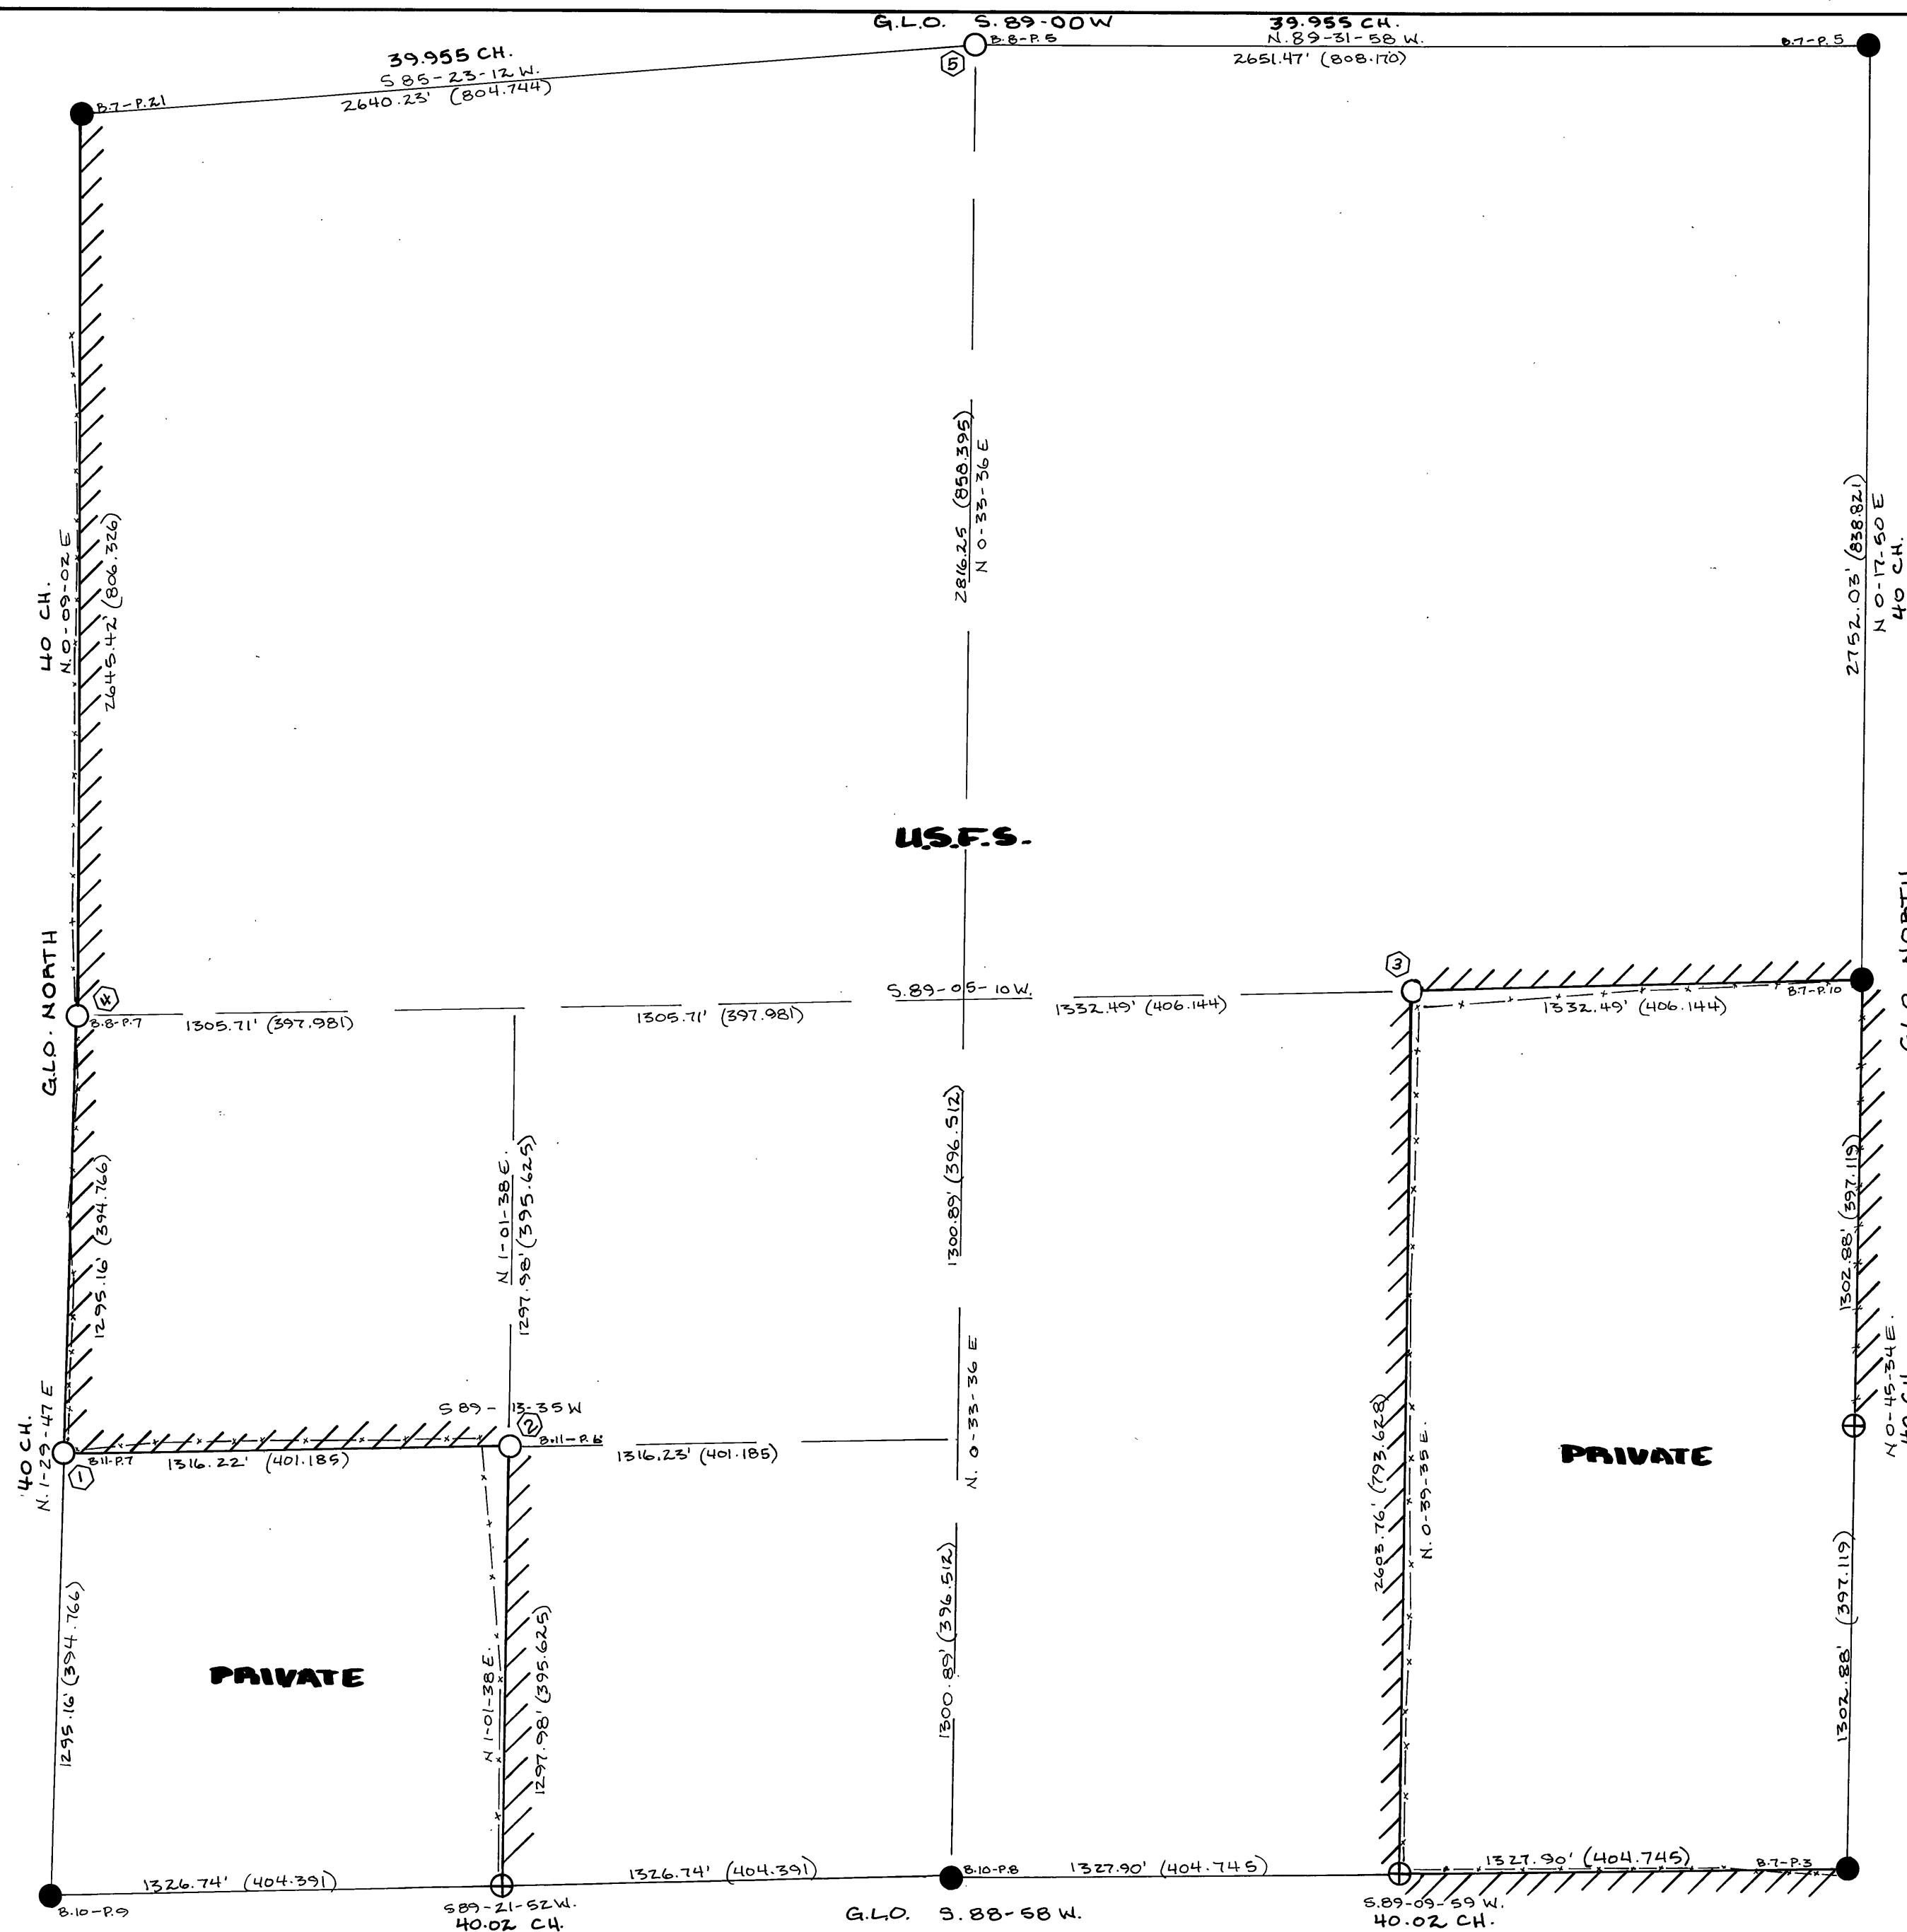


- ① A 12" LARCH BEARINGS N 24° E @ 13.5' SCRIBED S 1/16 S 28 UPPER BLAZE.
A 13" PINE BEARINGS N 8° W. @ 35.7' SCRIBED S 1/16 S 29 UPPER BLAZE.
PLS 896
- ② A 14" PINE BEARINGS N 26° E @ 40.6' SCRIBED S 1/16 S 28 UPPER BLAZE.
A 14" PINE BEARINGS N 68° E @ 76.5' SCRIBED S 1/16 S 28 UPPER BLAZE.
PLS 896
- ③ A 8" PINE BEARINGS N 60° E @ 25.5' SCRIBED C E 1/16 S 28 UPPER BLAZE.
A 8" PINE BEARINGS N 2° W. @ 27.2' SCRIBED C E 1/16 S 28 UPPER BLAZE.
PLS 896

④ SEE U.S.F.S. FORM R6-7100-57 (9/77)

RECEIVED AND
FILED
FEB 10 1981
OFFICE OF COUNTY SURVEYOR
Robert D. Bishop
Attest: *Laurie D. Bishop*

BASIS OF BEARINGS - SOLAR OBSERVATIONS
1" = 400'
BAR SCALE

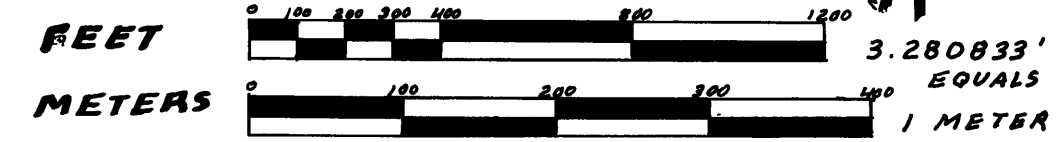

LEGEND

- SET 2 1/2" GALVANIZED STEEL PIPE 30" LONG WITH A 2 1/2" BRASS CAP STAMPED AS SKETCHED ABOVE
- FOUND BRASS CAP OF RECORD
- ⊕ CORNER AND ITS ACCESSORIES DESCRIBED ON THE PLAT OF THIS SURVEY
- ▼ SET 4" X 4" X 6' WOOD POST WITH SIGN 54-2 & 54-5 FENCE
- ||||| ALL BEARING TREES MARKED DURING THIS SURVEY HAVE A RED BAND SIGN 54-3 SIGN 54-4 & 54-5 AND A LOWER BLAZE SCRIBED AT AND WITH A BRASS DISH STAMPED PLS 896
- PROPERTY LINE POSTED WITH STEEL FENCE POSTS AND SIGN 54-2
- (219.312) DISTANCE IN METERS (B&P = BOOK & PAGE)
- SET STEEL GUARD POST WITH SIGN 54-2 & 54-4 OR 54-5 AT CORNERS SET (TWO AT GOVT. PROPERTY CORNERS)

I, LARRY D. BISHOP, A REGISTERED LAND SURVEYOR IN THE STATE OF OREGON, HEREBY CERTIFY THAT THIS PLAT AND THE NOTES HEREON ARE A CORRECT REPRESENTATION OF THE SURVEY AS PERFORMED DURING SEPT.-OCT.-NOV.-DEC. 1980 FOR THE U.S. FOREST SERVICE IN ACCORDANCE WITH THE STATUTES OF THE STATE OF OREGON & THE ARTICLES OF MY CONTRACT.

Larry D. Bishop
LARRY D. BISHOP
REGISTERED LAND SURVEYOR NO. 896



HISTORY OF SURVEYS
THE SECTION WAS ORIGINALLY SURVEYED BY DEPUTY FOREST W. CAMPBELL IN JUNE, 1881 UNDER CONTRACT NO. 380

PLAT OF SURVEY
USDA, FOREST SERVICE- REGION 6
UMATILLA NATIONAL FOREST
SMITH CREEK CADASTRAL
CONTRACT NO. 53-04R3-0-01147

LOCATION: SECTION 28, T.7S., R.31E, WM. GRANT COUNTY, ORE.

BISHOP SURVEYING
PO BOX 729 HOOD RIVER, ORE.
(503) 386-5122
DATE: _____
PROJECT NO. 80067